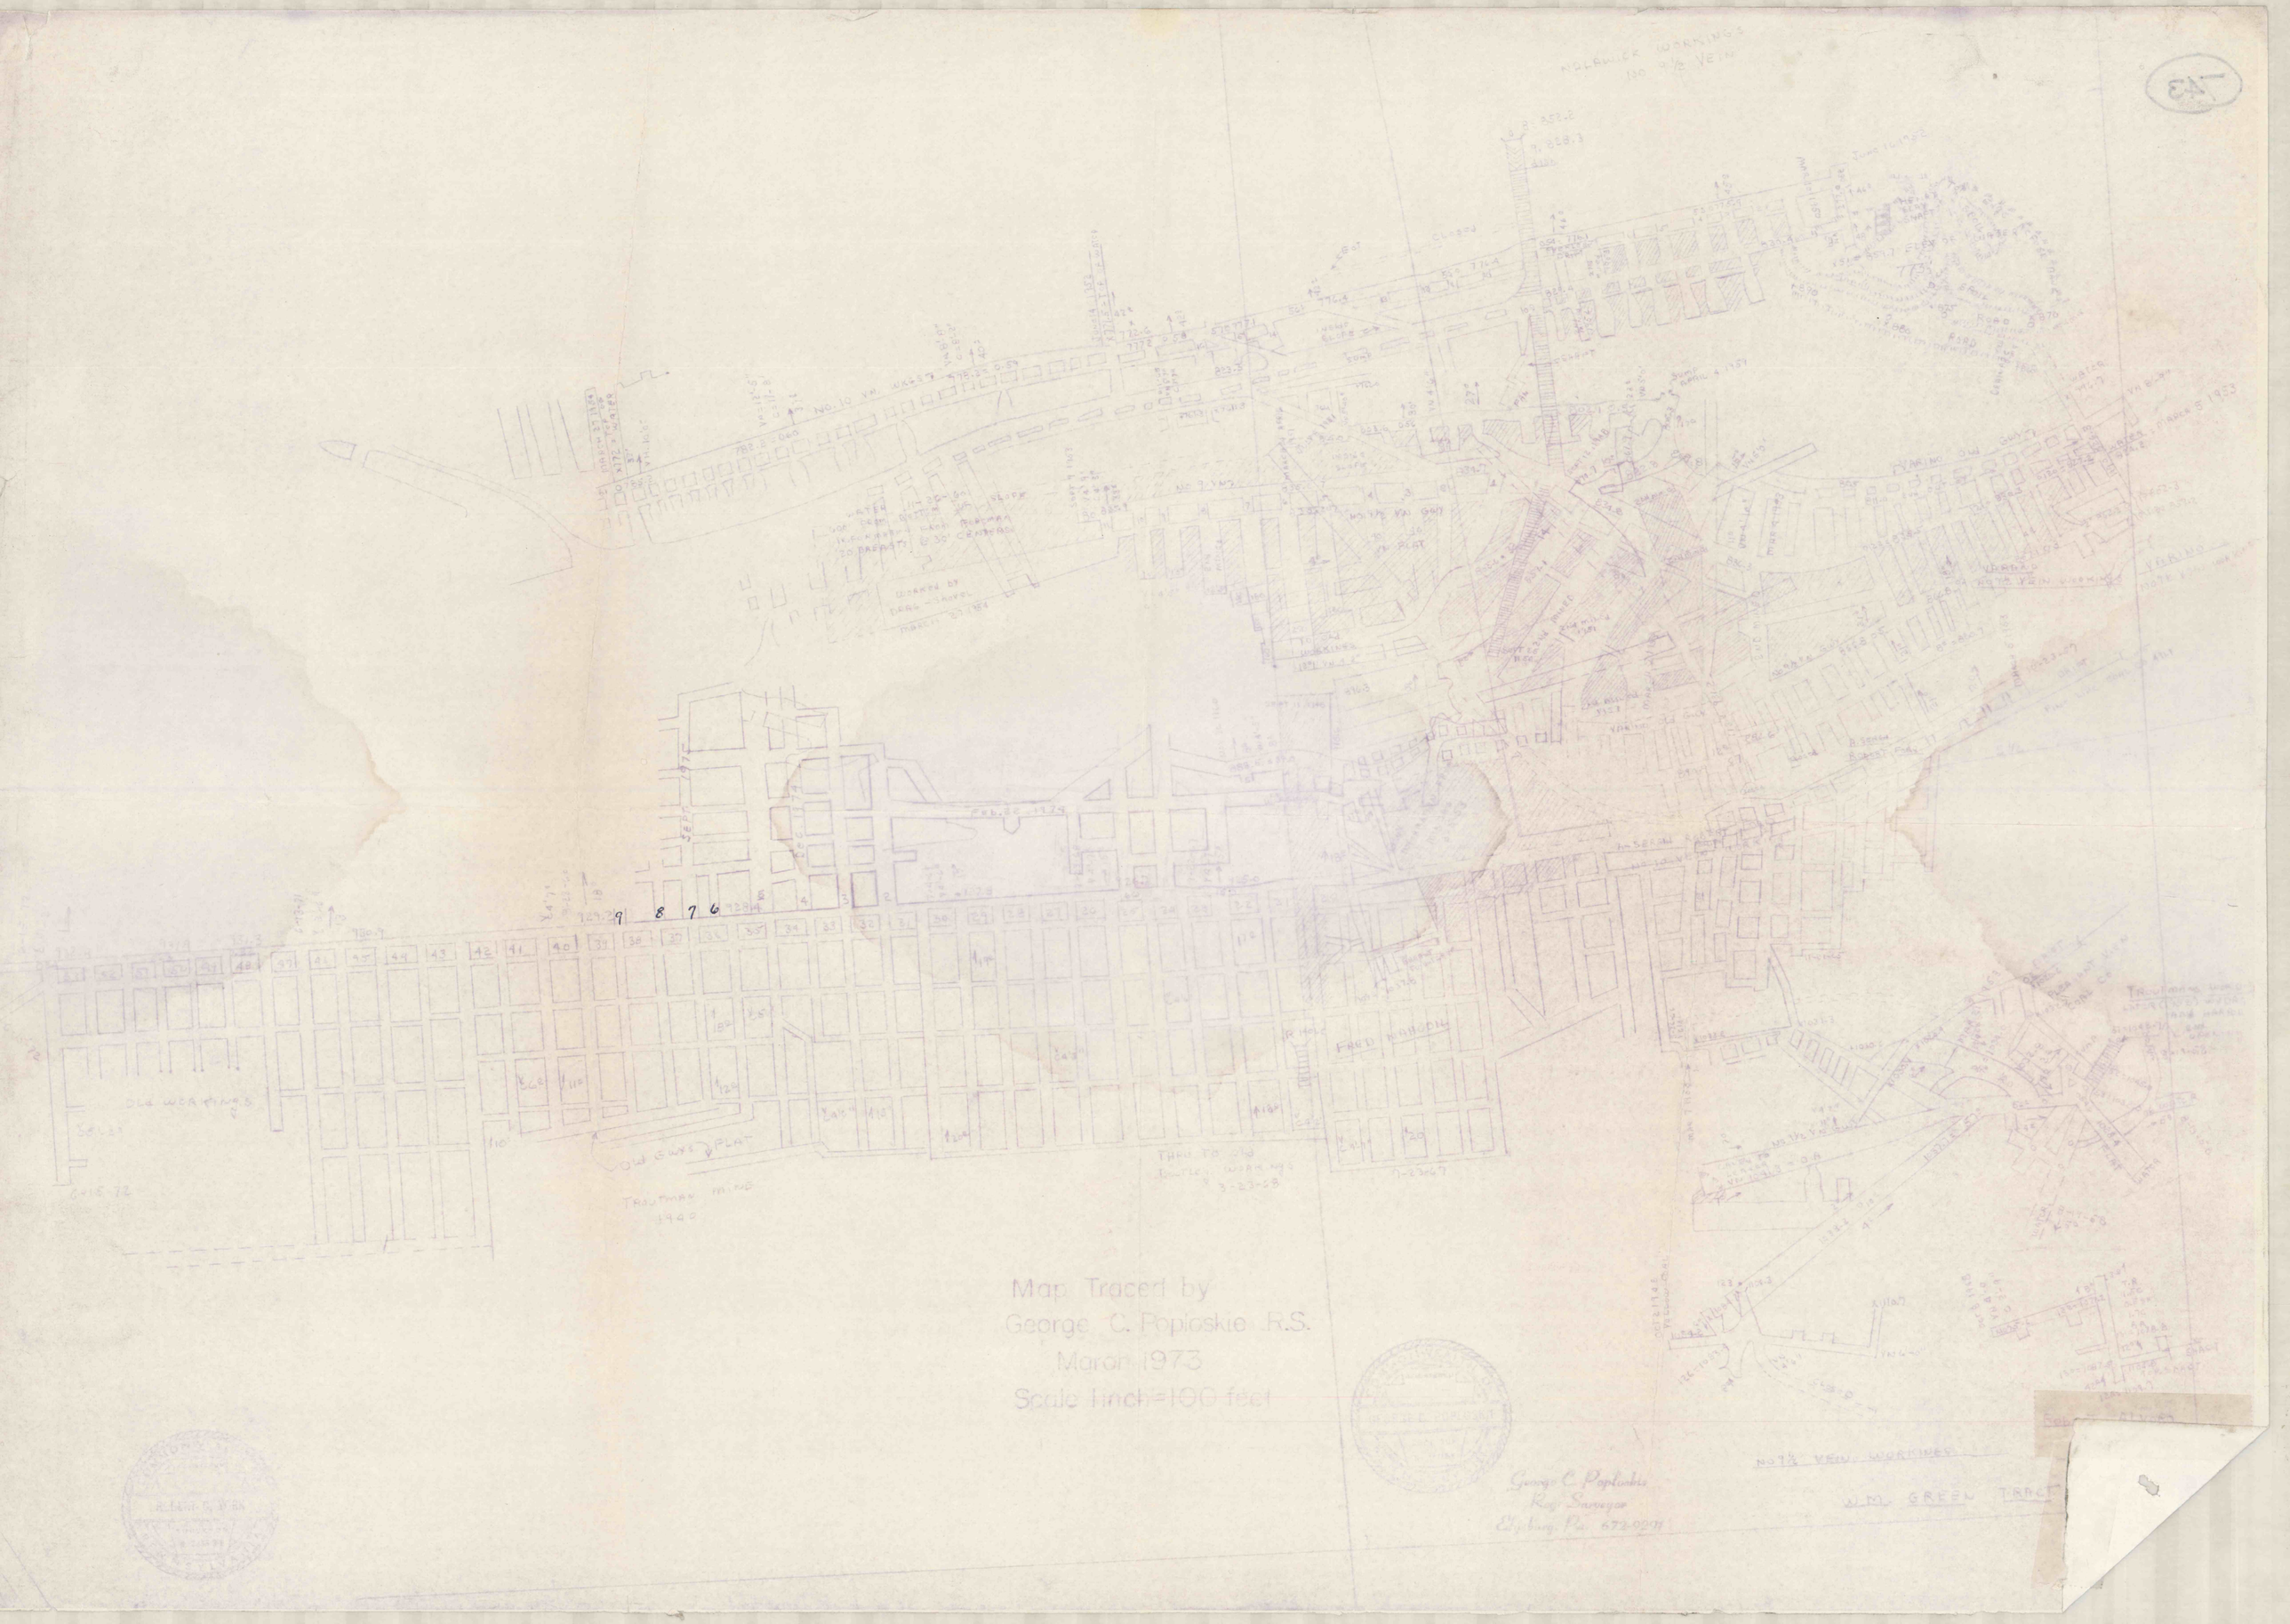
NOTAWICK WORKINGS
100 9½ VEIN
No. 10 VEIN WORKINGS
OLD WORKINGS
OLD GUYS PLAT
TRAUTMAN MINE
1940
THRU TO OLD
BUTTLE WORKINGS
3-23-68
FRED MAHOPIN
VARING OLD GUY
VARING
NOTE BOW WORKINGS
VERDAD
NO 7½ VEIN WORKINGS
WM. GREEN TRACT
Map Traced by
George C. Popioskie R.S.
March 1973
Scale 1 inch = 100 feet
George C. Popioskie
Reg. Surveyor
Ebensburg, Pa. 672-0291