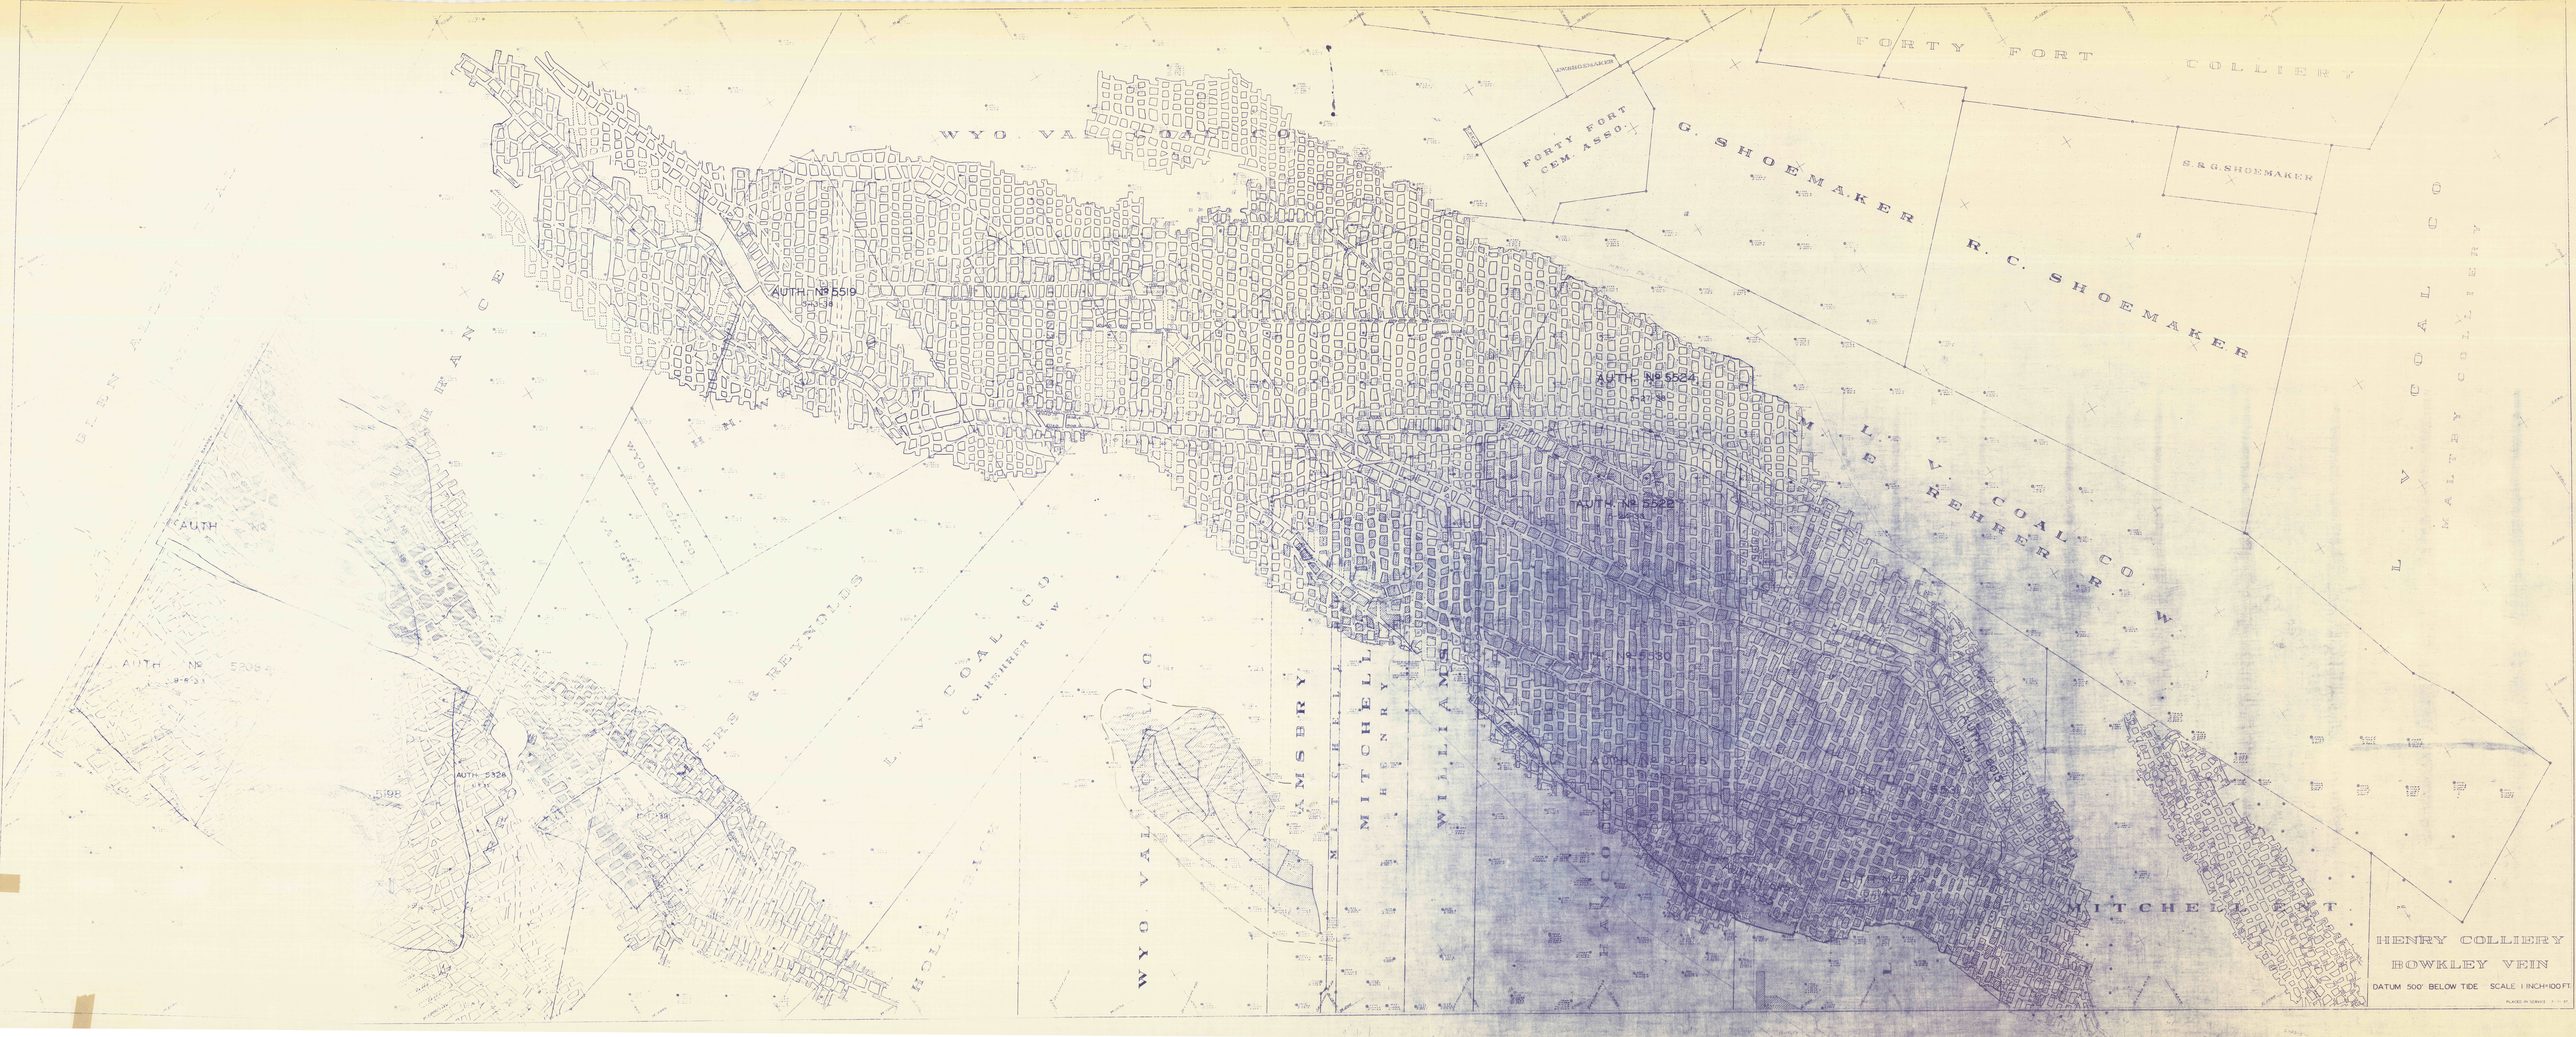

FORTY FORT
COLLIERY
FORTY FORT CEM. ASSO.
G. SHOEMAKER
S.R.G. SHOEMAKER
R. C. SHOEMAKER
WYO VALLEY COAL CO
AUTH. № 5519
AUTH. № 5524
AUTH. № 5522
AUTH. № 5525
AUTH. № 5526
AUTH. № 5528
AUTH. № 5529
AUTH. № 5531
AUTH. № 5532
AUTH. №