



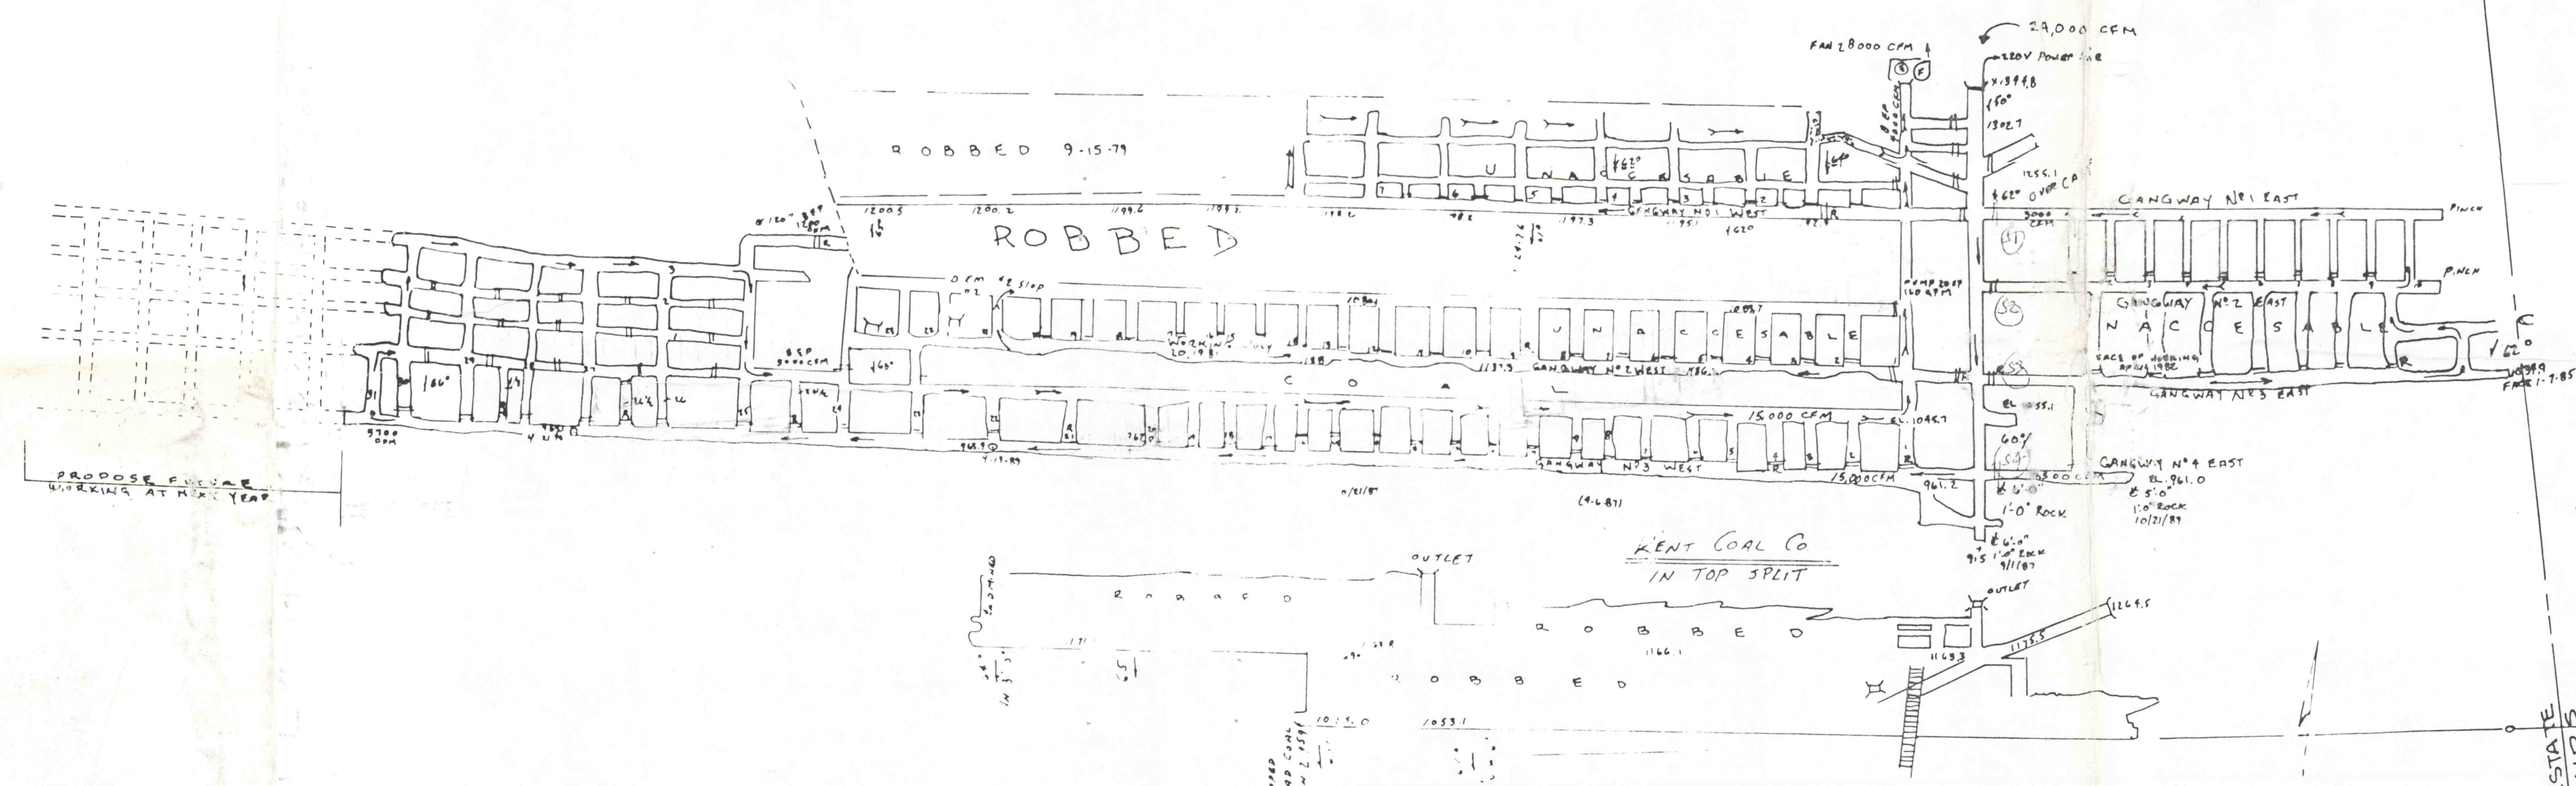

TRACED FROM PLAN
OF
S.B.M. COAL CO.
M & R SLOPE
PREPARED BY
BARRY E. TRUMBAUER P.E.
DATE: OCTOBER 22, 1991
SCALE: 1" = 100'
PLAN #3 OF 6

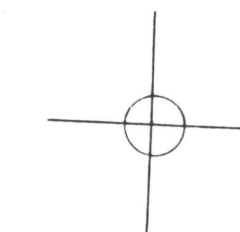