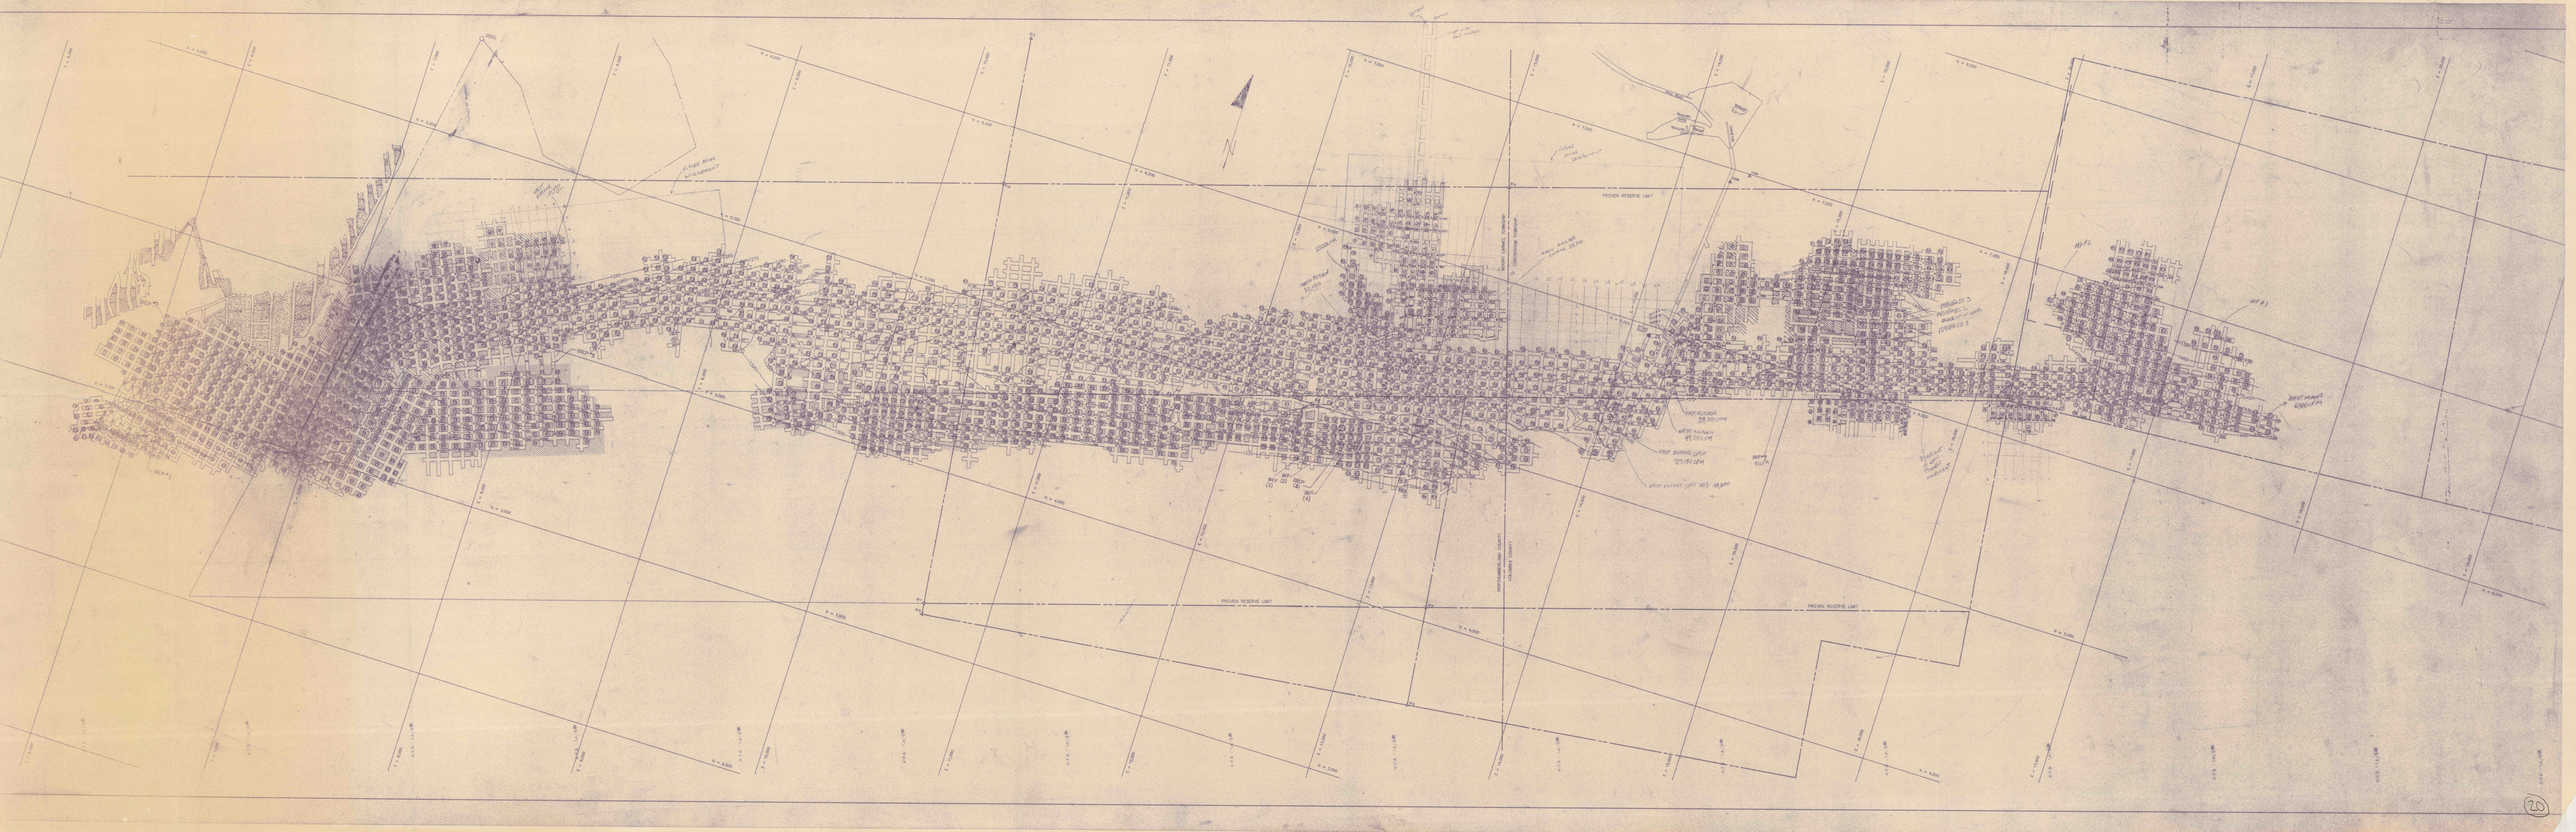
PROVEN RESERVE LIMIT
PROVEN RESERVE LIMIT
PROVEN RESERVE LIMIT
N