


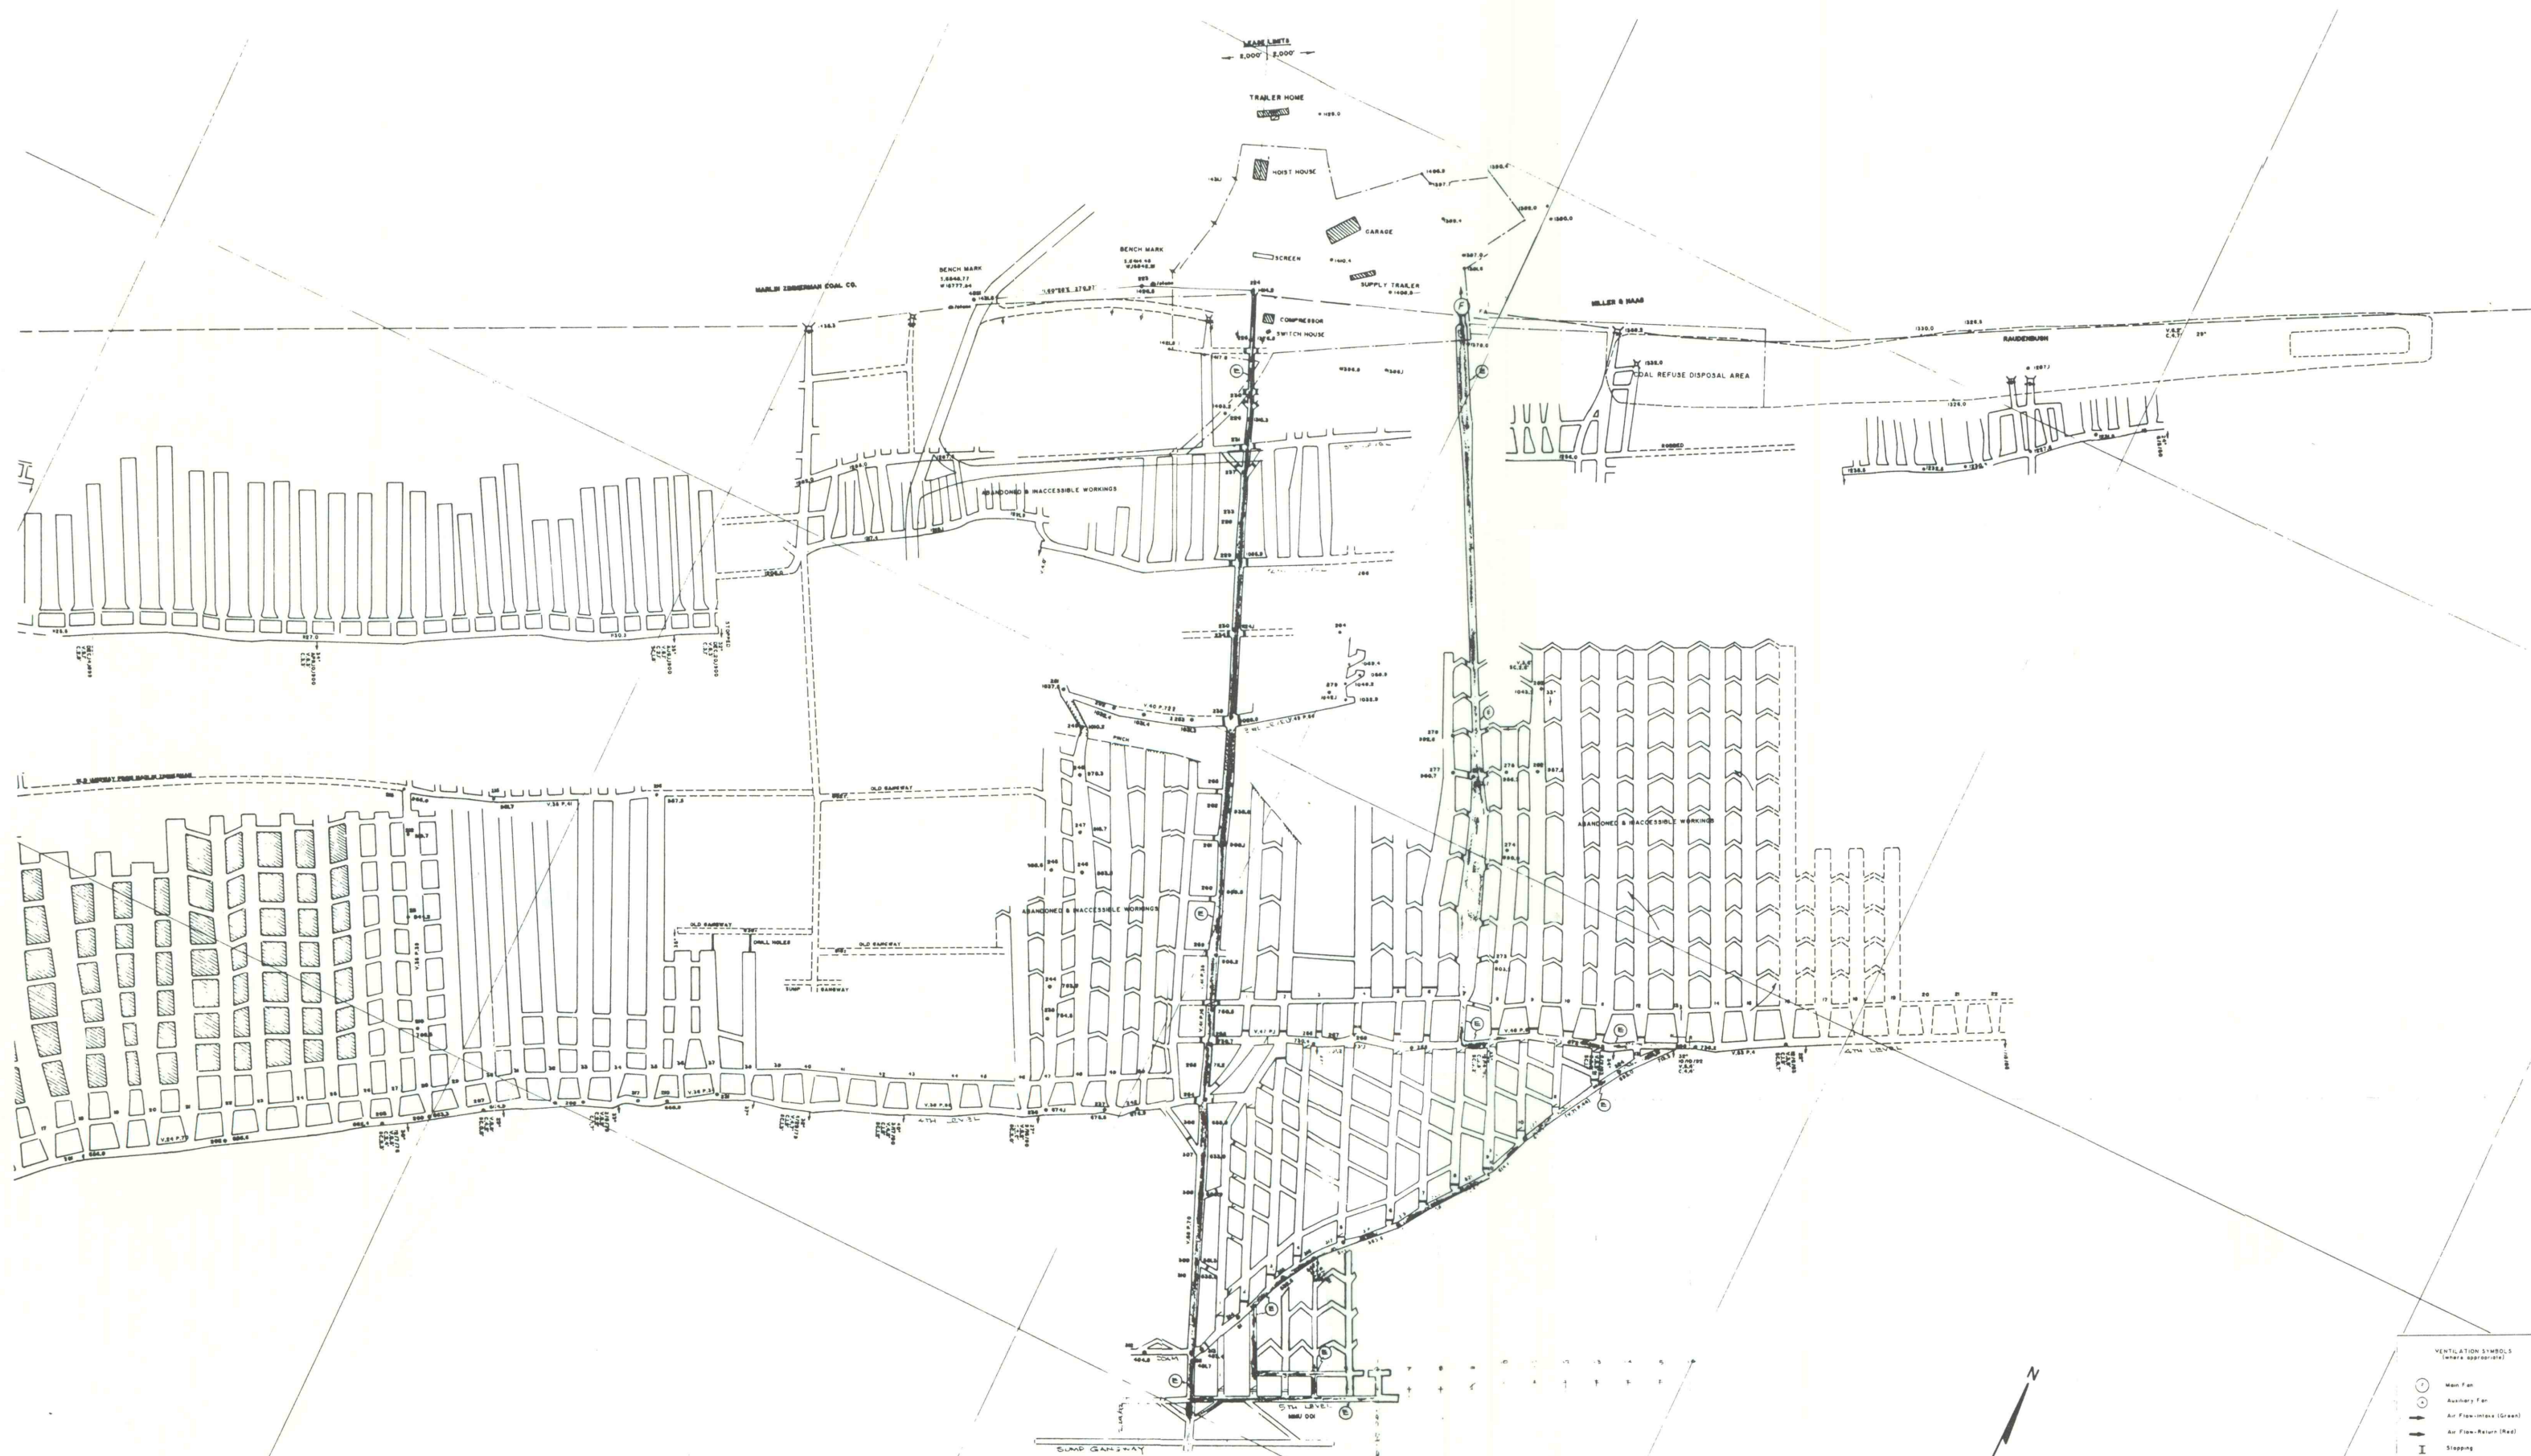

- VENTILATION SYMBOLS
- Main Fan
 - Auxiliary Fan
 - I Stopping
 - Air Bridge
 - Regulator
 - Man Door
 - Velocity Fan
 - Quantity Air
 - Water Supply
 - Exhaust Fan
 - Blower/Exhaust Fan
 - Filter Removal or Washing
 - Mine Seal
 - Active Workings (Yellow)
 - Current or Bridge
 - Workings Not Surveyed
 - Caved Ground

APPENDIX I - MINE MAP
BUCK MOUNTAIN SLOPE, ID NO. 36-02053
BUCK MOUNTAIN COAL COMPANY NO. 2
Updated by investigation team.

0 300
Scale, ft