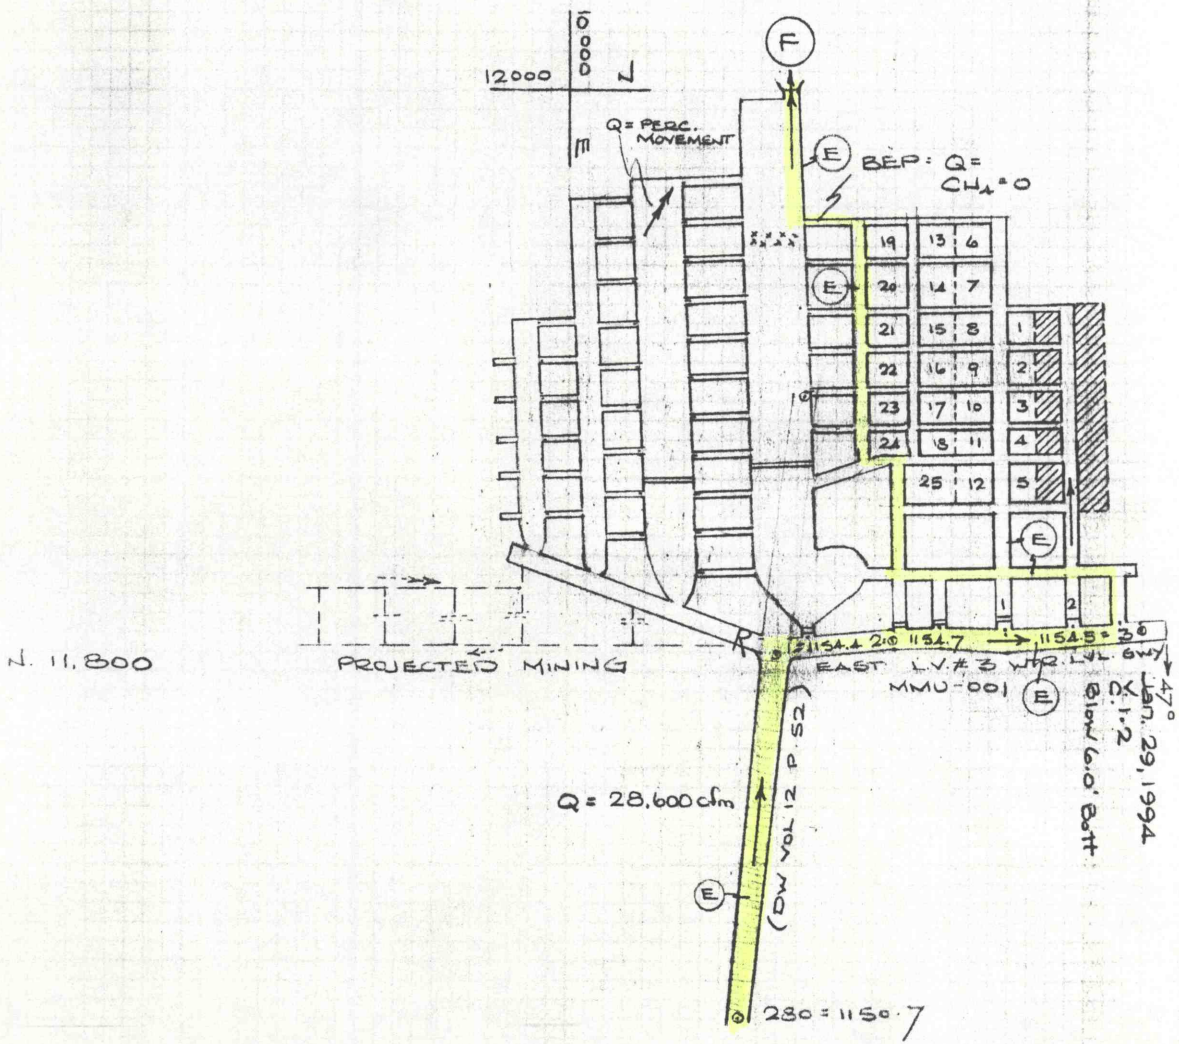

DRAFT

B.&M. TUNNEL
36-01781

R.&R. COAL COMPANY

SCALE: 1" = 100'

David L. Williams

(44)