




- | | |
|---|---------------------------|
|  | Main Fan |
|  | Auxiliary Fan |
|  | Air Flow-Intake (Green) |
|  | Air Flow-Return (Red) |
|  | Stopping |
|  | Air Bridge |
|  | Regulator |
|  | Man Door |
|  | Velocity, fpm |
|  | Quantity, cfm |
|  | Water Gauge, in |
|  | Escapeway |
|  | Blower Evaluation Point |
|  | Pillar Removal or Roofing |
|  | Mine Seal |
|  | Active Workings (Yellow) |
|  | Curtain or Brattice |
|  | Workings Not Surveyed |
|  | Covered Ground |

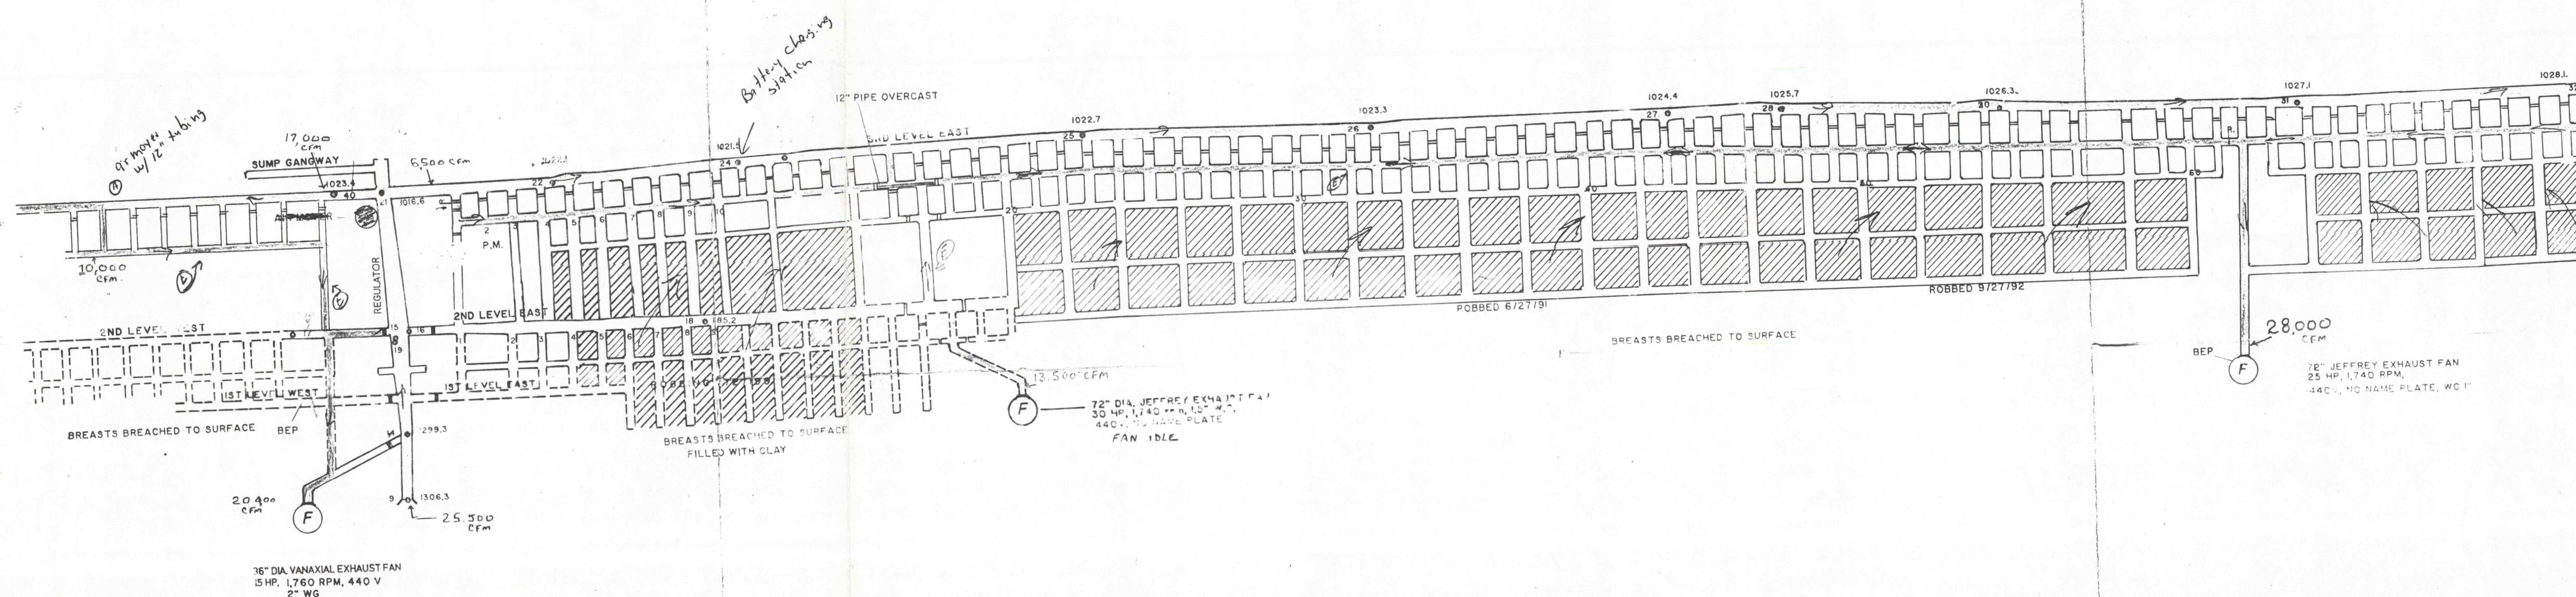

LONGITUDINAL SECTION
thru
Mine Workings
of the
Jeff Coal Company TRACY VEIN Slope
Mmu. 0100 I D # 36-07200

SURVEY POSTED JULY 22, 1993

Arthur B. Quail

PLATE NO. 1