


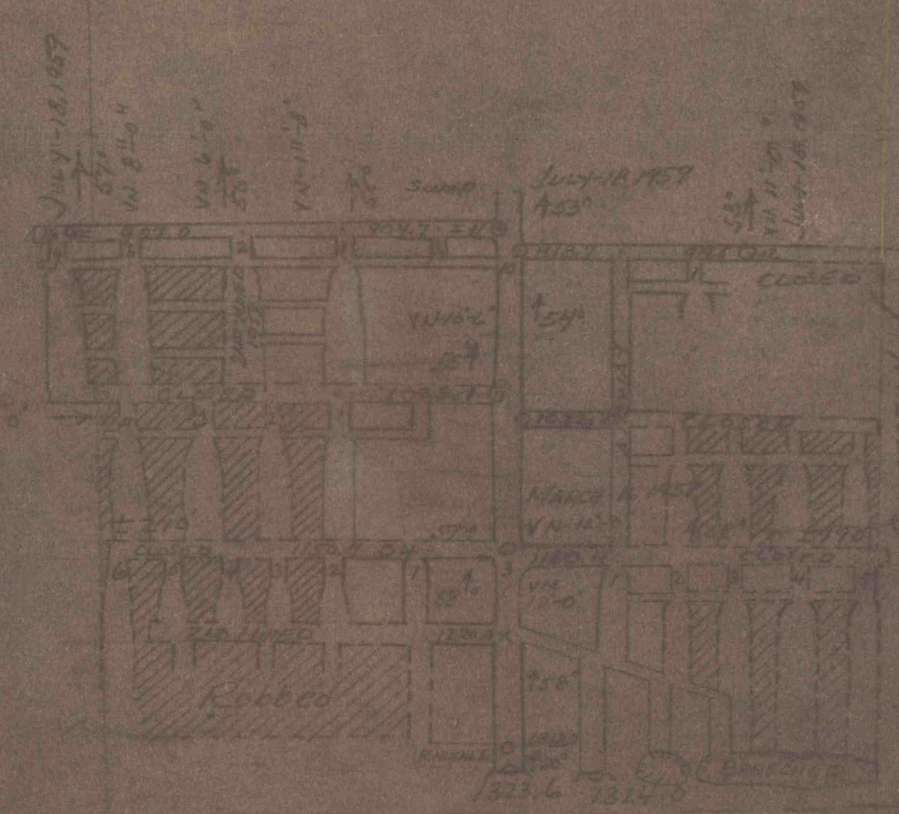

HAULAGE ROAD



AUGUSTINE B. ZERETSKI

100' STATION Point 3

100' FROM #7 CHUTE



B. E. B. Co. Co.

OVERSTREET

HAULAGE ROAD

