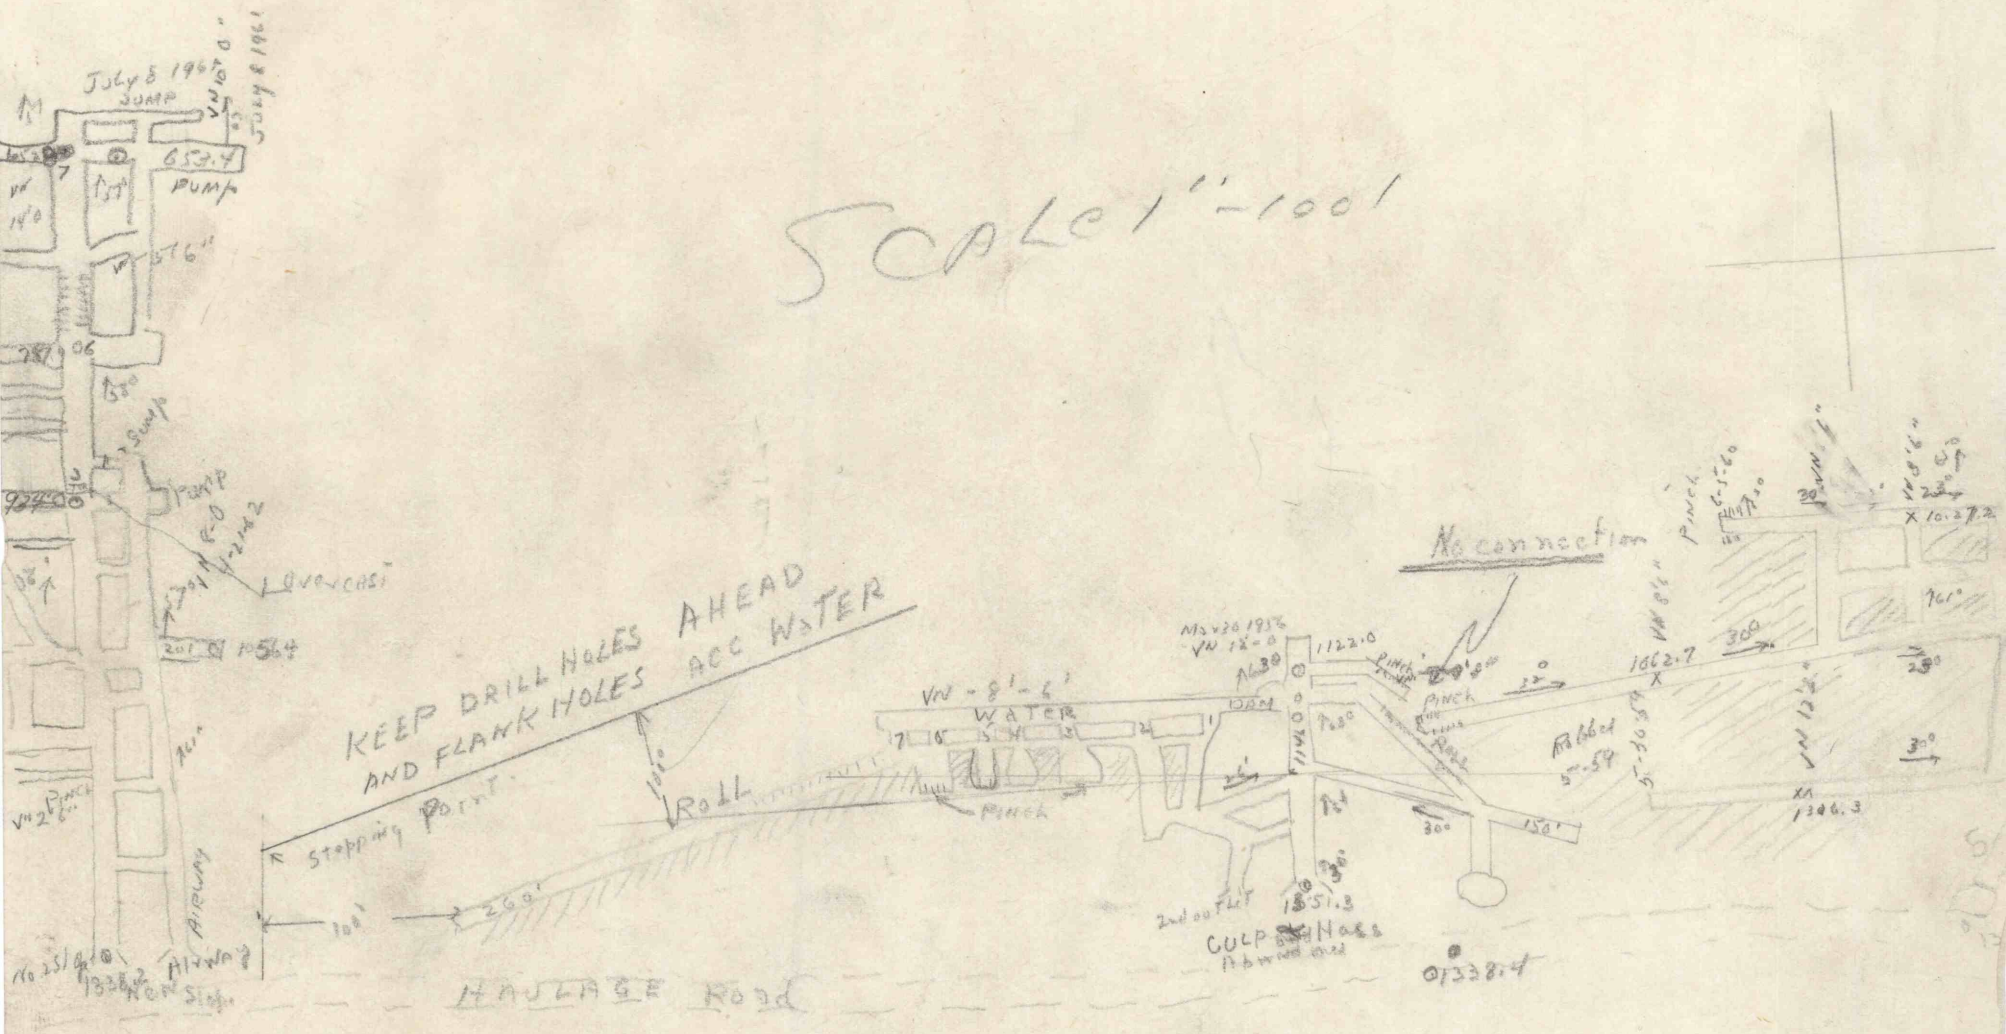
SCALE 1" = 100'
July 8 1962
SUMP
PUMP
Sump
Pump
Overcast
KEEP DRILL HOLES AHEAD
AND FLANK HOLES ACC WATER
Stopping Point
Roll
WATER
DAM
Pinch
No connection
Robbed
GULP
HAULAGE ROAD