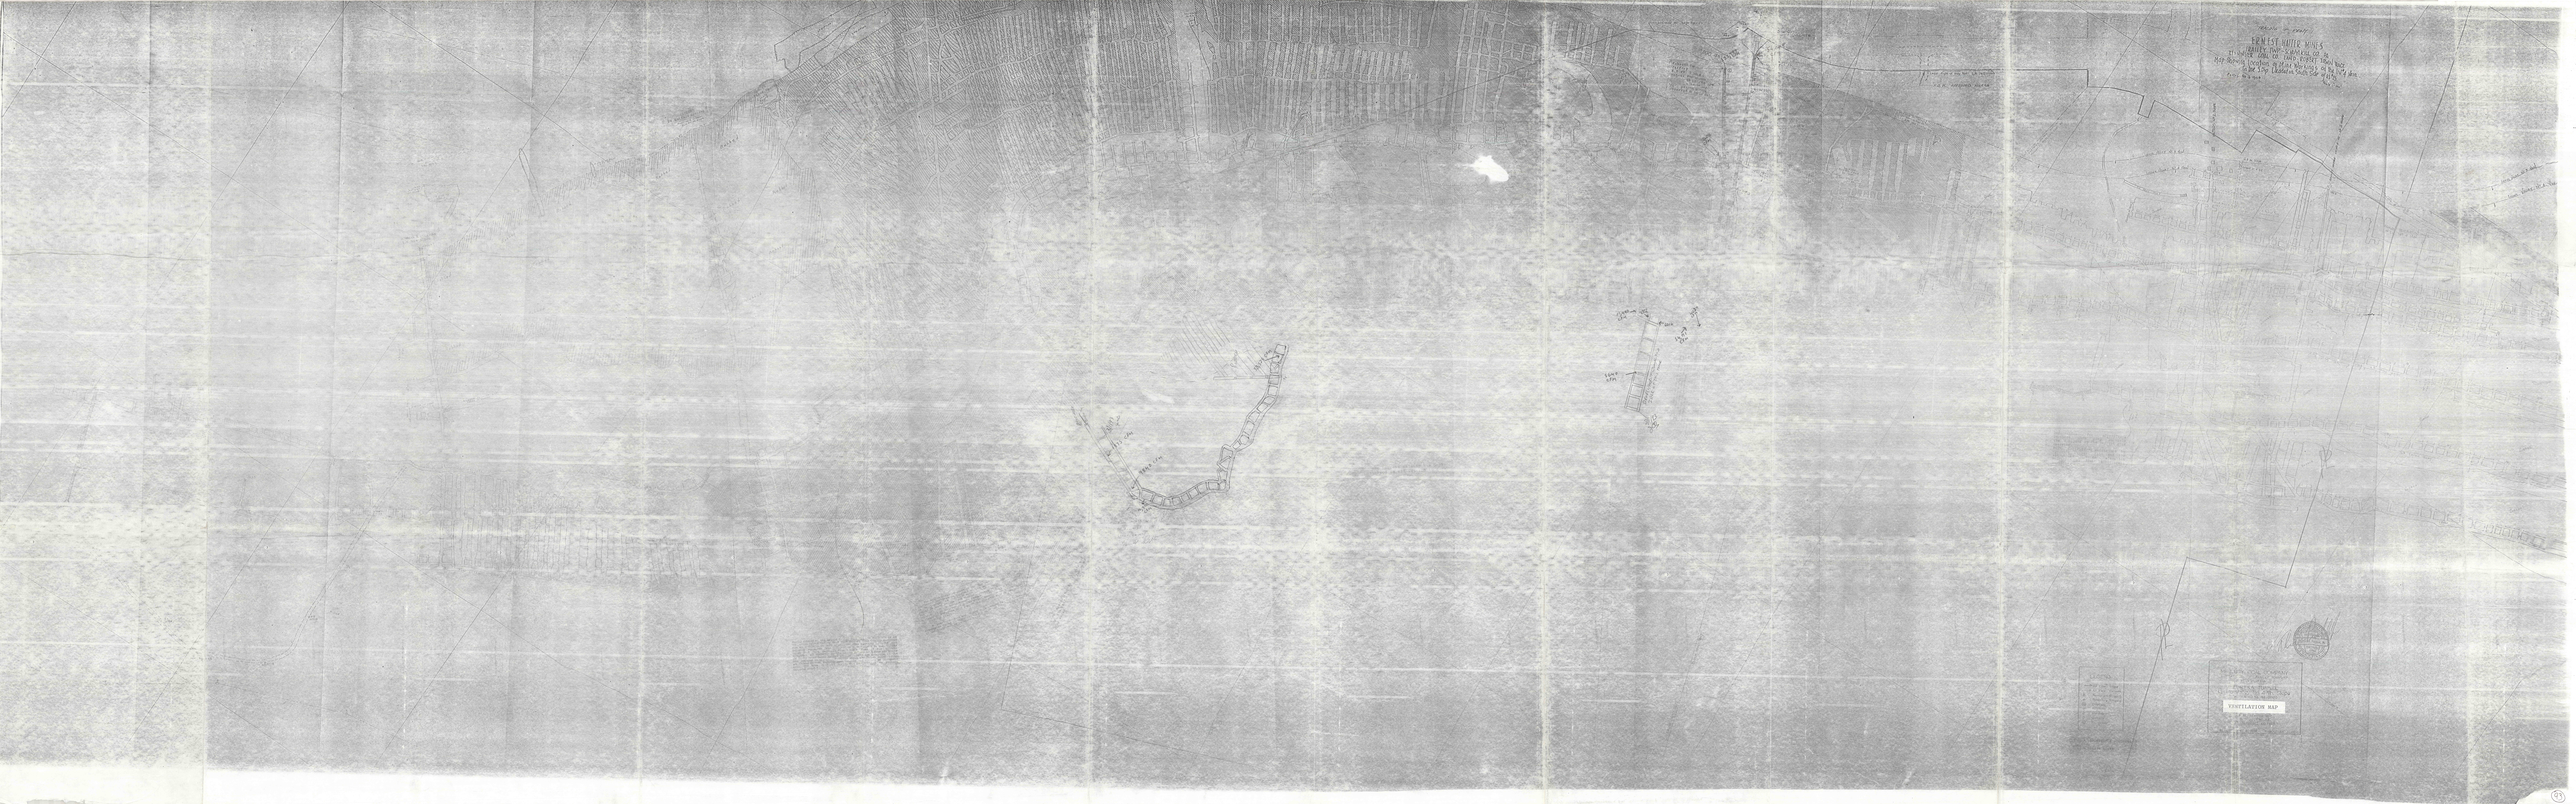
HEMLOCK WATER MINES
VENTILATION MAP