


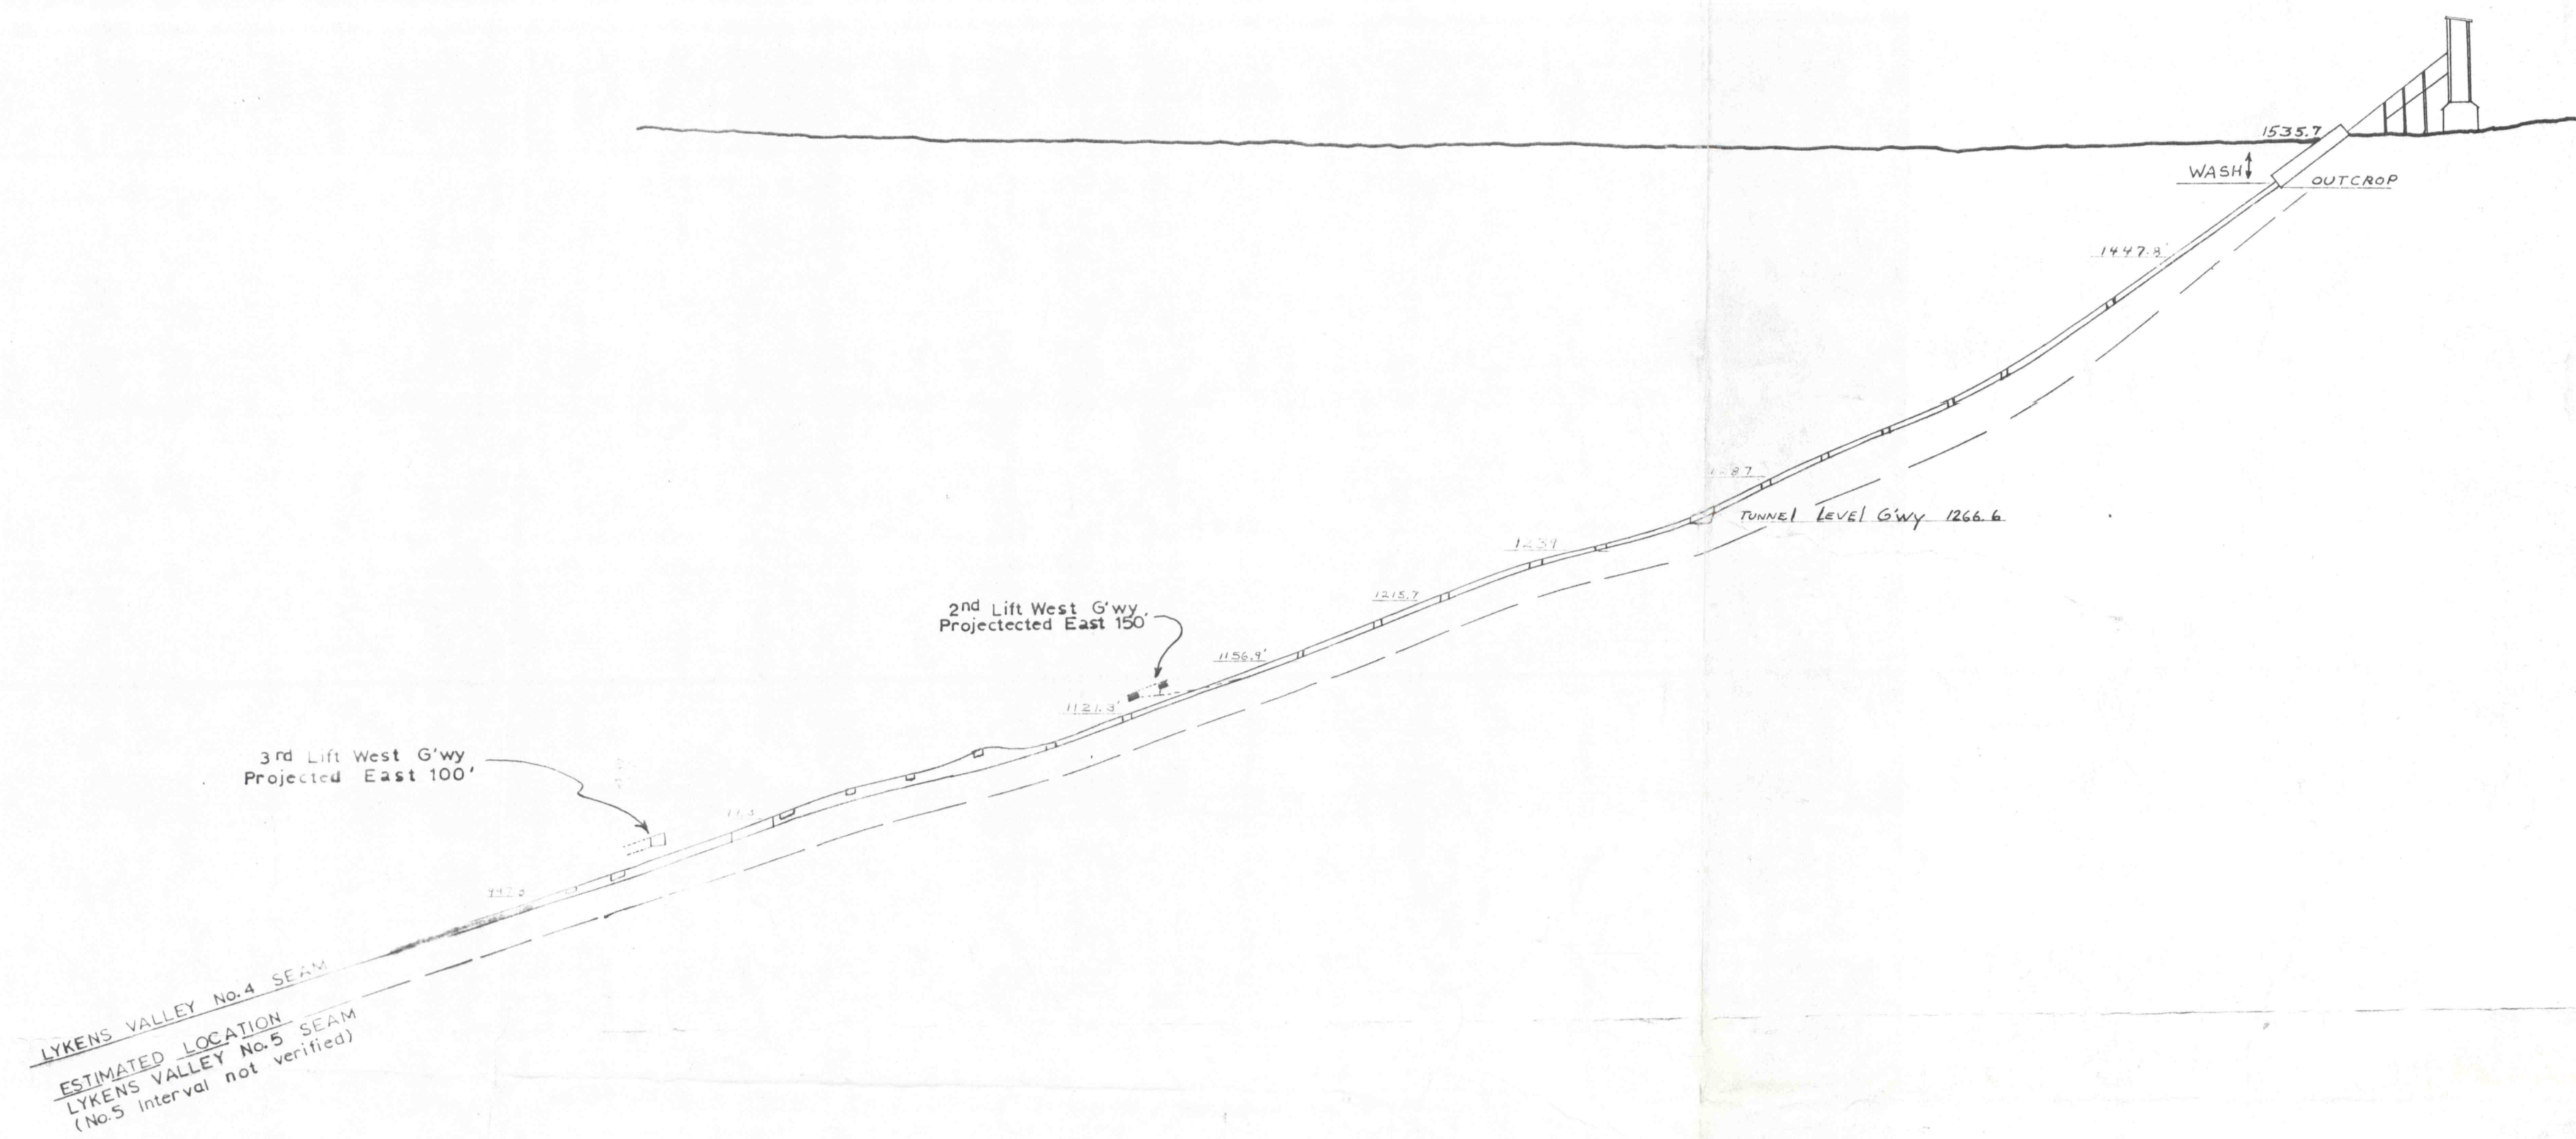

CROSS SECTION ON LINE OF SLOPE
LOOKING WEST

DATUM=400' ABOVE MID TIDE



MERCURY COAL COMPANY
SCHUYLKILL COUNTY FRAILEY TOWNSHIP
PENNSYLVANIA

Lykens Valley No. 4 Vn. Slope
M.S.H.A. ID No. 36-01920

CROSS SECTION
1" = 100'

Rev'd 1-9-90 T. PUSCHAK
12-22-90 T. P.