


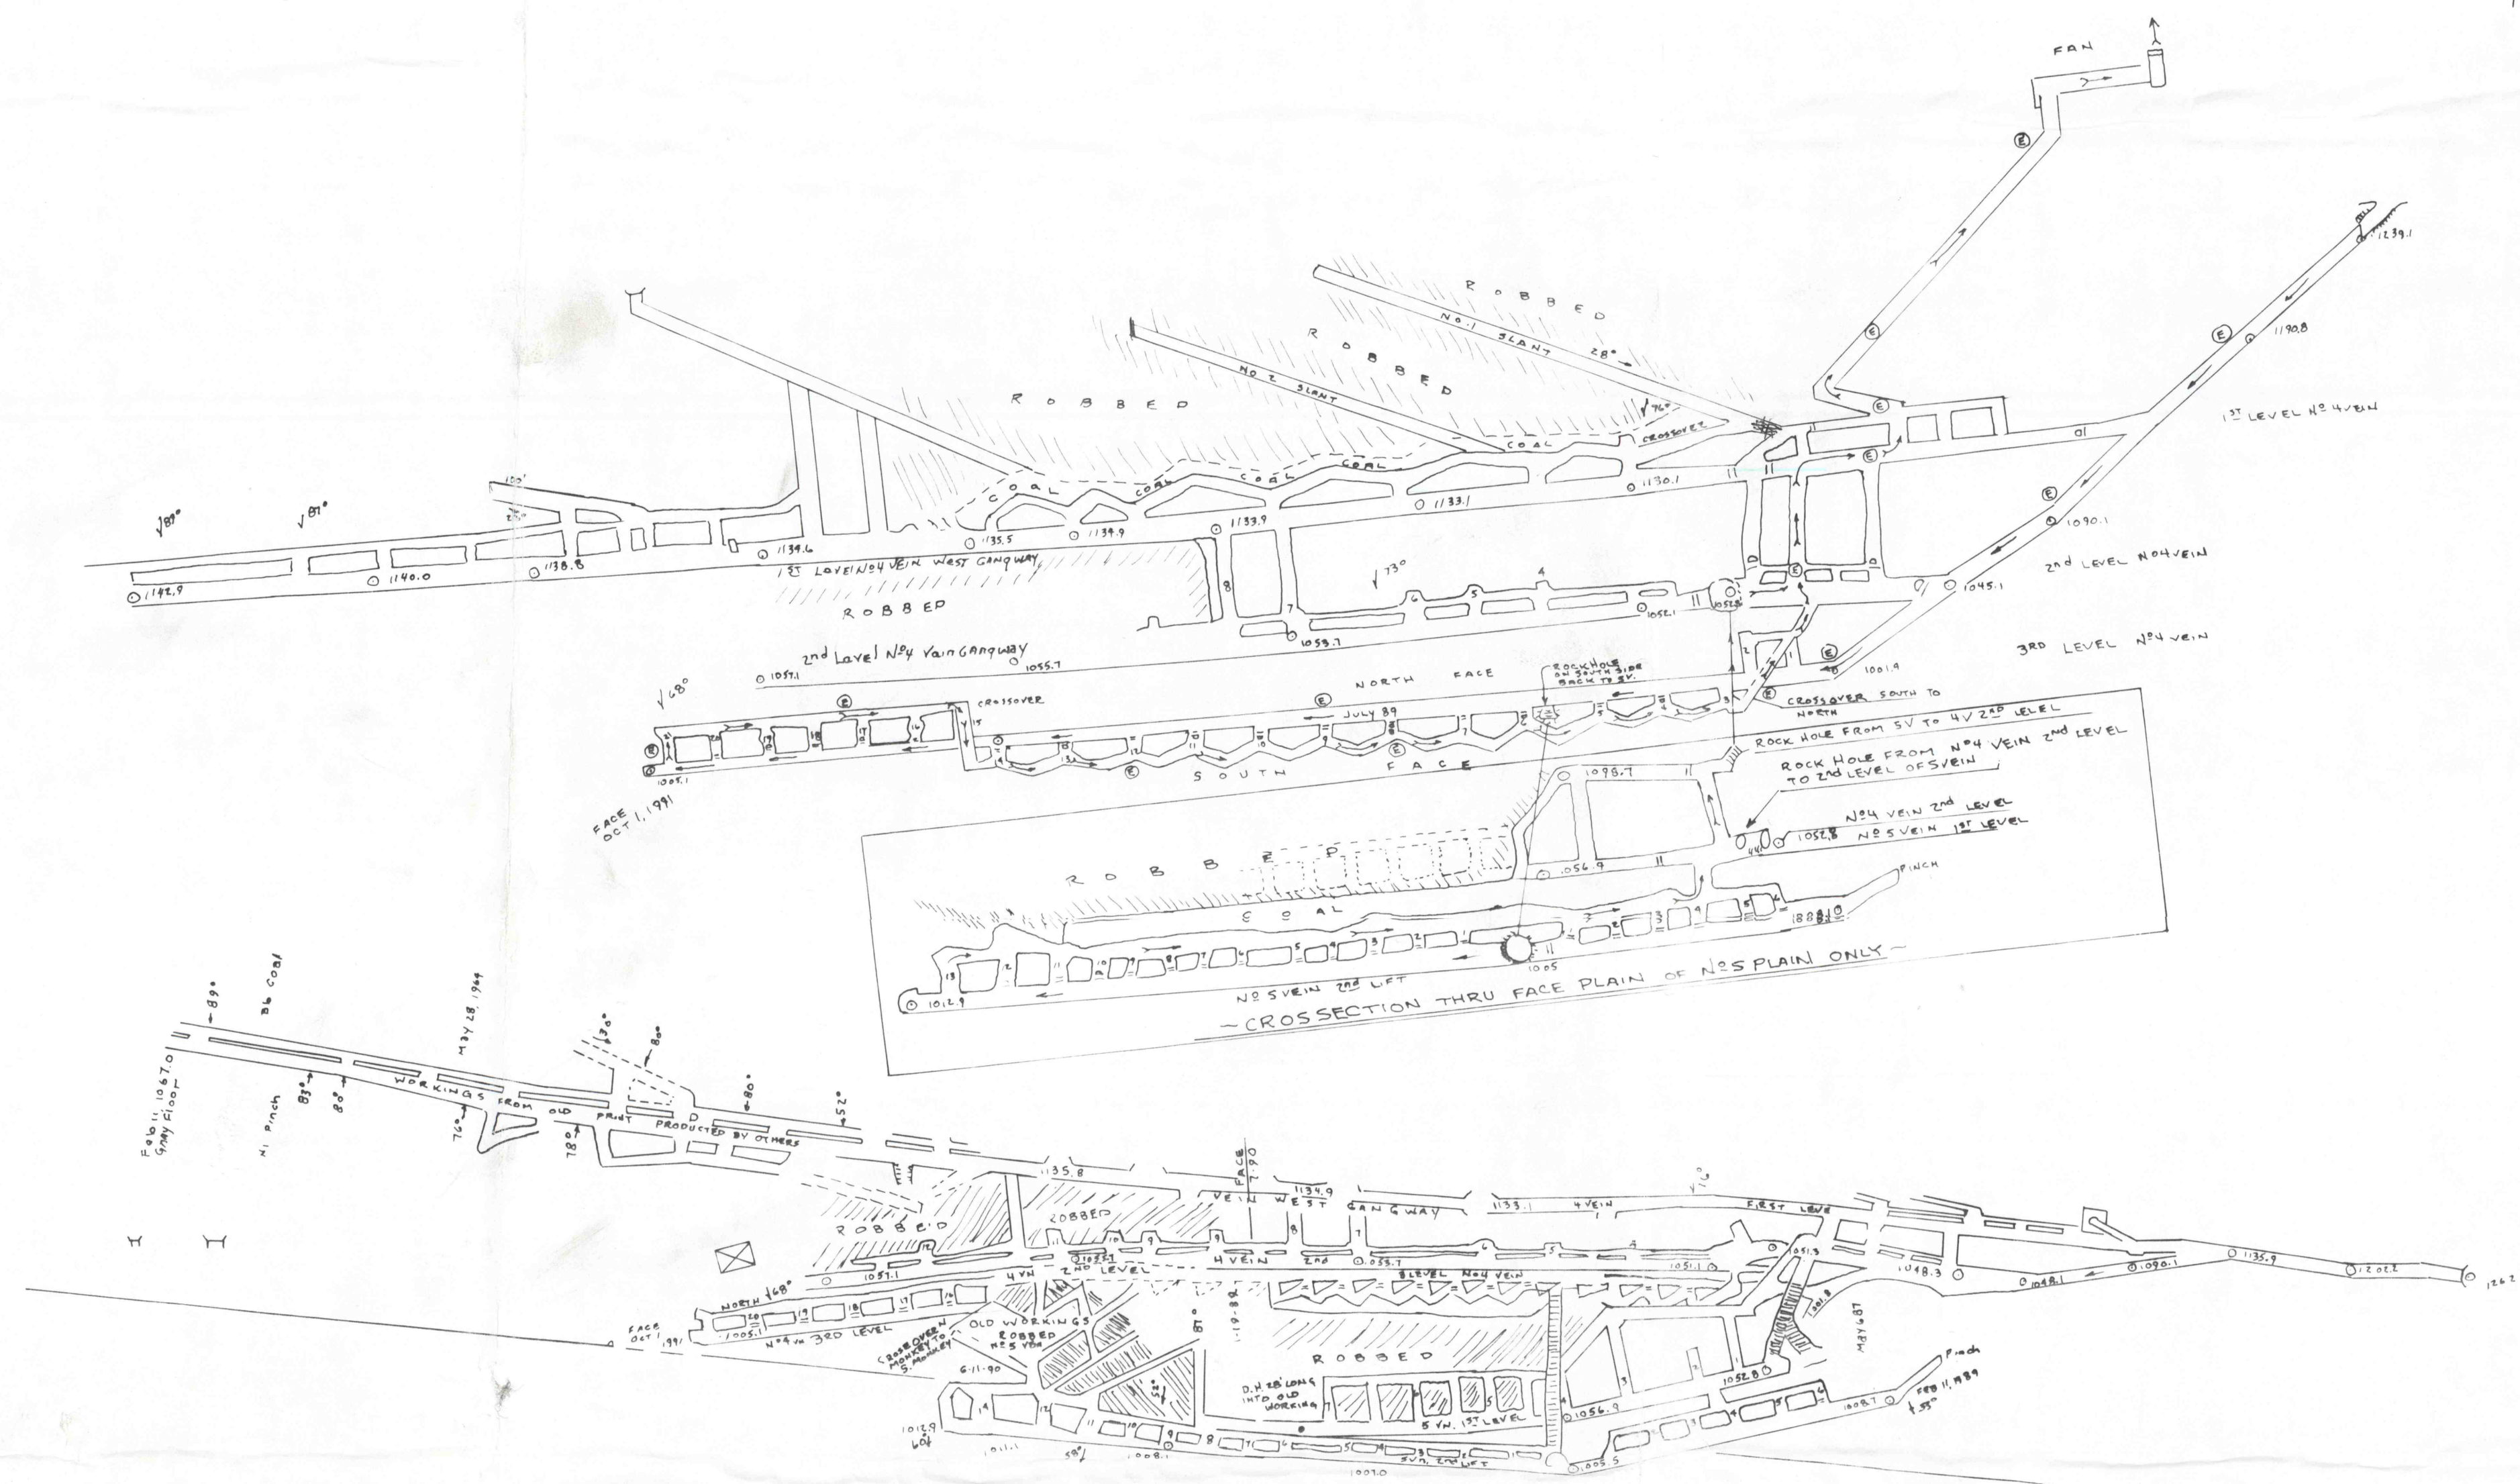

OVERLAY MAP OF ALL LEVELS OF N4W N5 VEIN
 TRACED FROM MAP OF JERRY E. TRUMBauer, P.E.
 DATED: 12 NOV. 1991
 MAPPED BY OTHERS

10000 SPANFIELD COAL CO.
 (unmarked) PRINT

TRACED FROM PLAN
 OF
 SPANFIELD COAL CO.
 PREPARED BY
 JERRY E. TRUMBauer, P.E.
 DATE: NOVEMBER 12, 1991
 SCALE: 1" = 100'
 PLAN #3 OF 8