
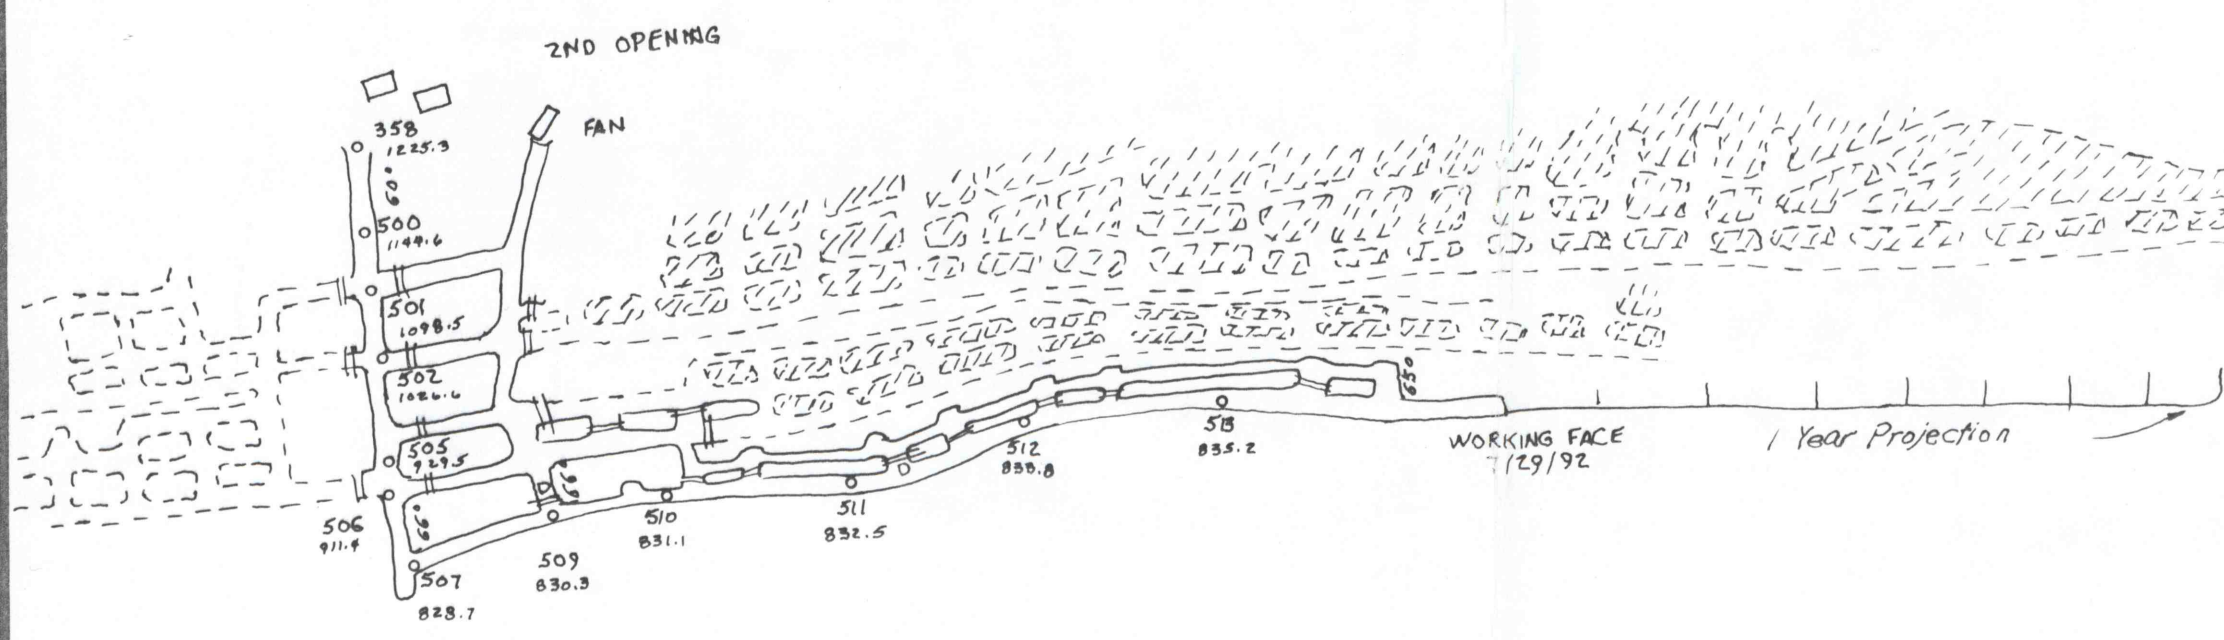


PETER PETERY TRACT

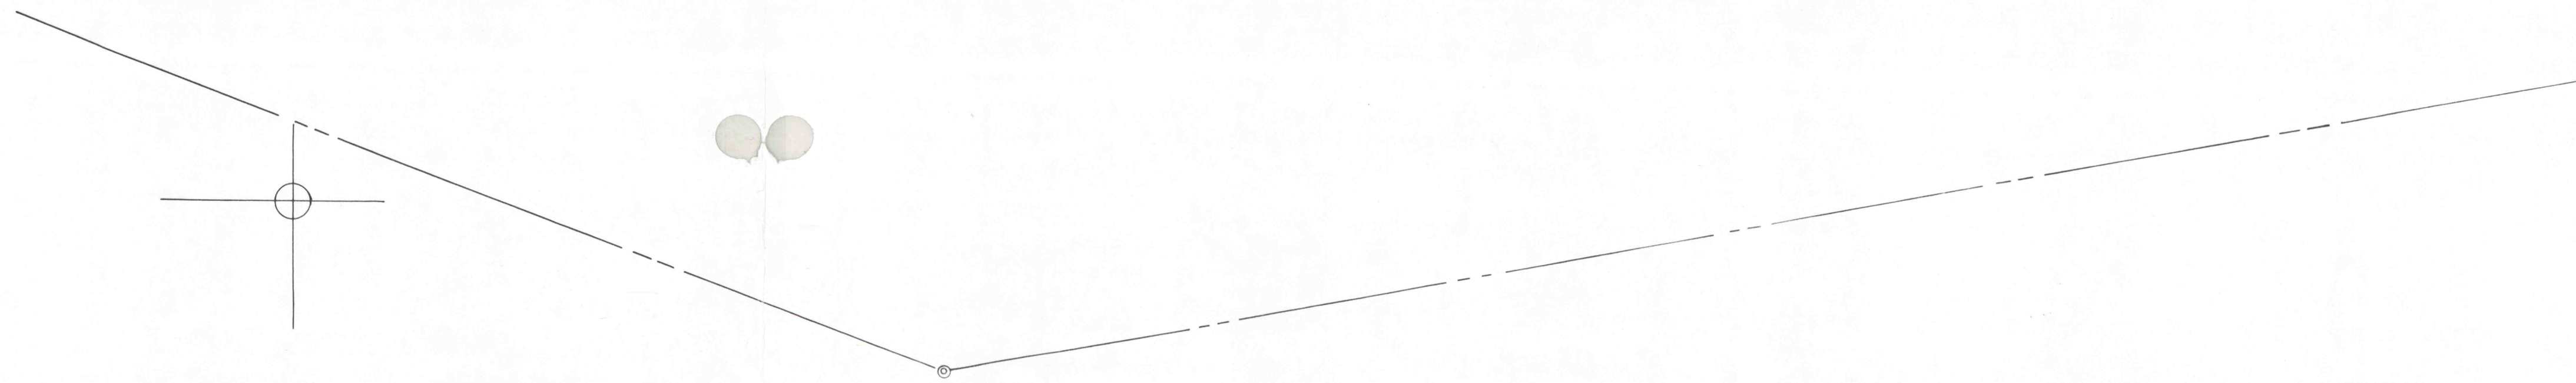

TRACED FROM PLAN
 OF
 K & L COAL CO.
 PREPARED BY
 TAYLOR-DORRICK ASSOCIATES
 DATE: JUNE 12, 1992
 SCALE: 1" = 100'
 PLAN #4 OF 8