

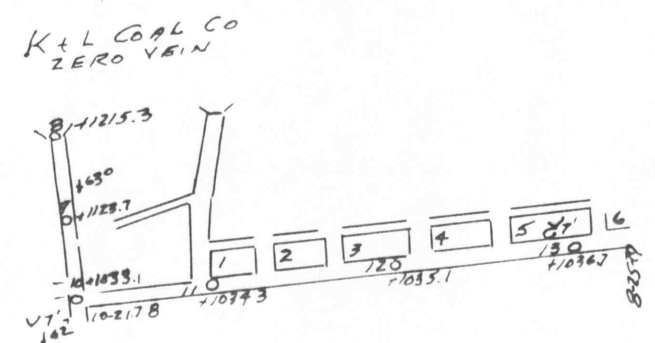
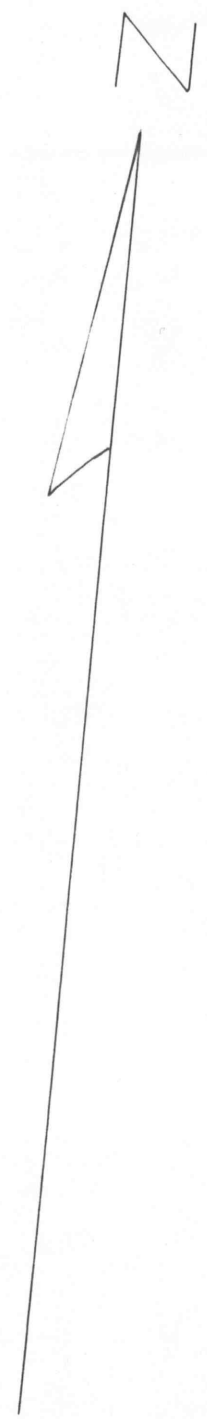
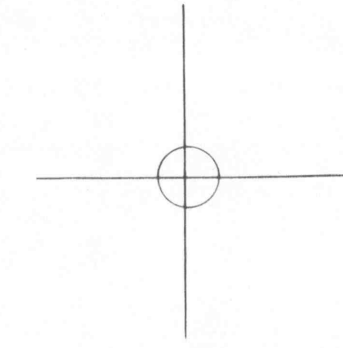


PETER PETERY TRACT

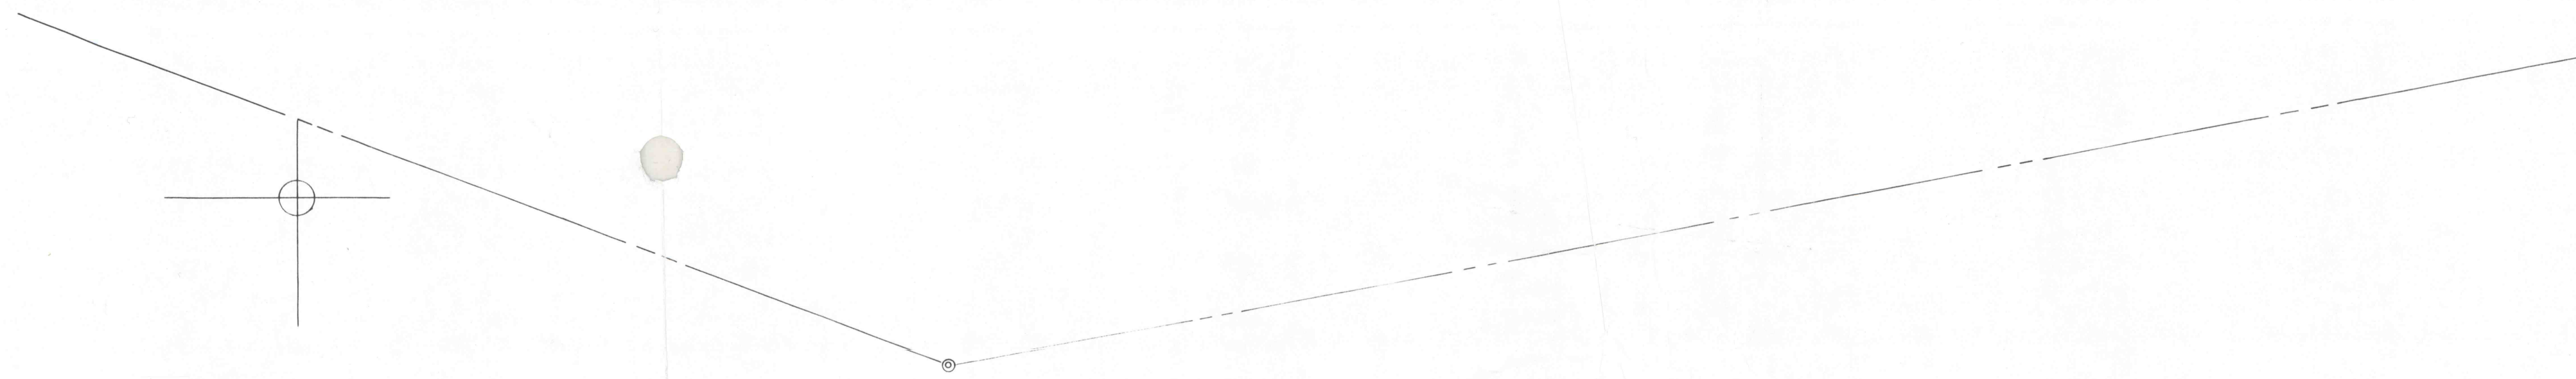





93074

V. NAVROCKI SLOPE

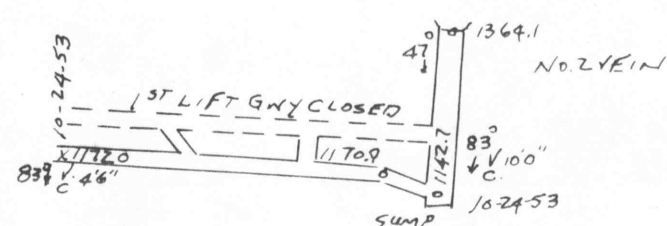

DRIFT MOUNTAIN
1034.7
1050.2

DRIFT MOUNTAIN
854

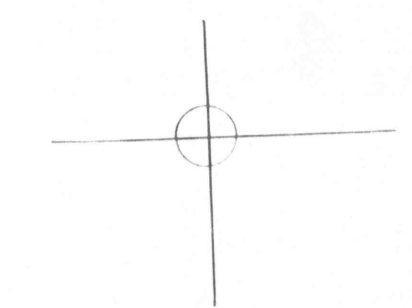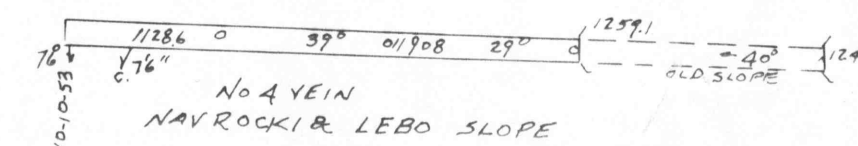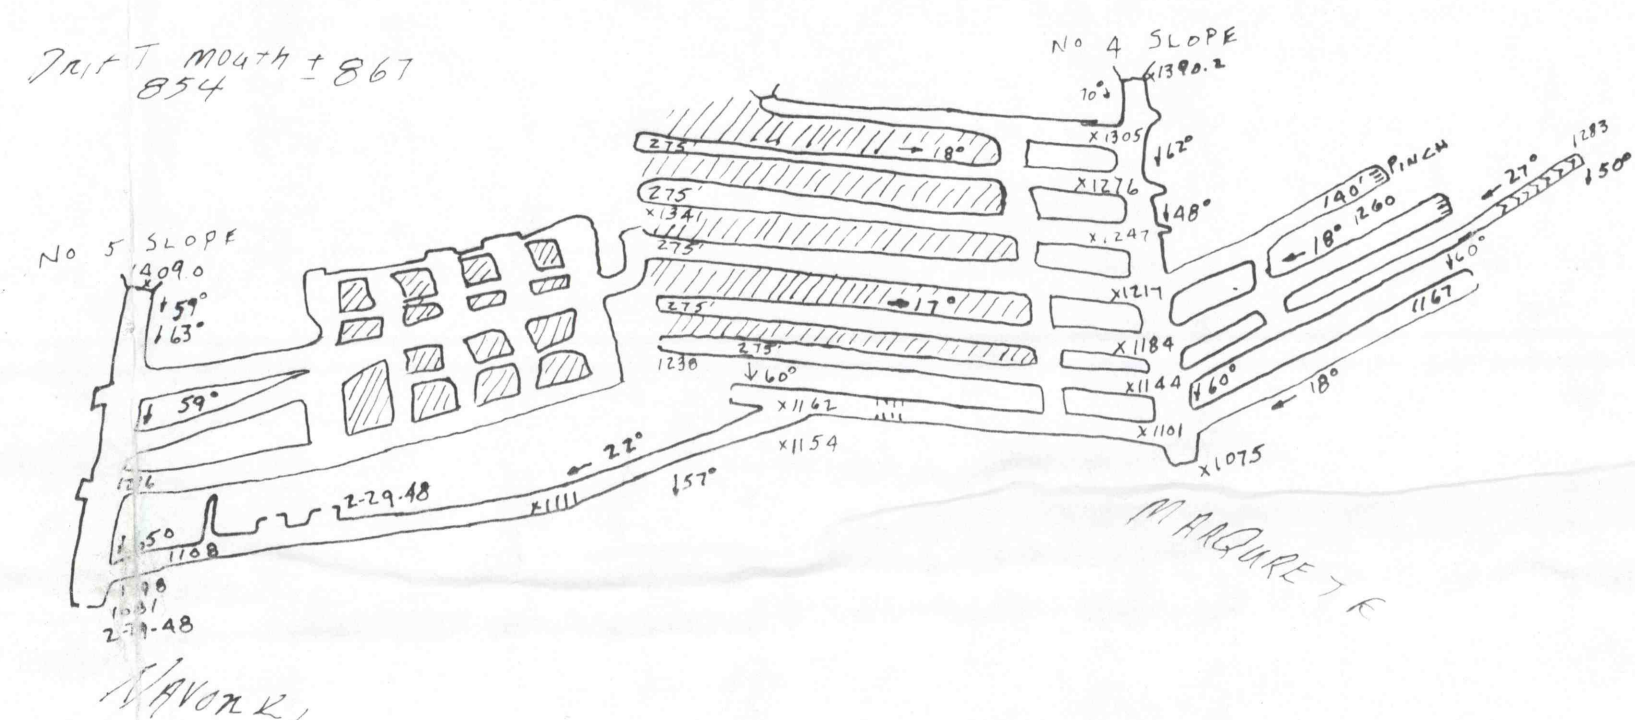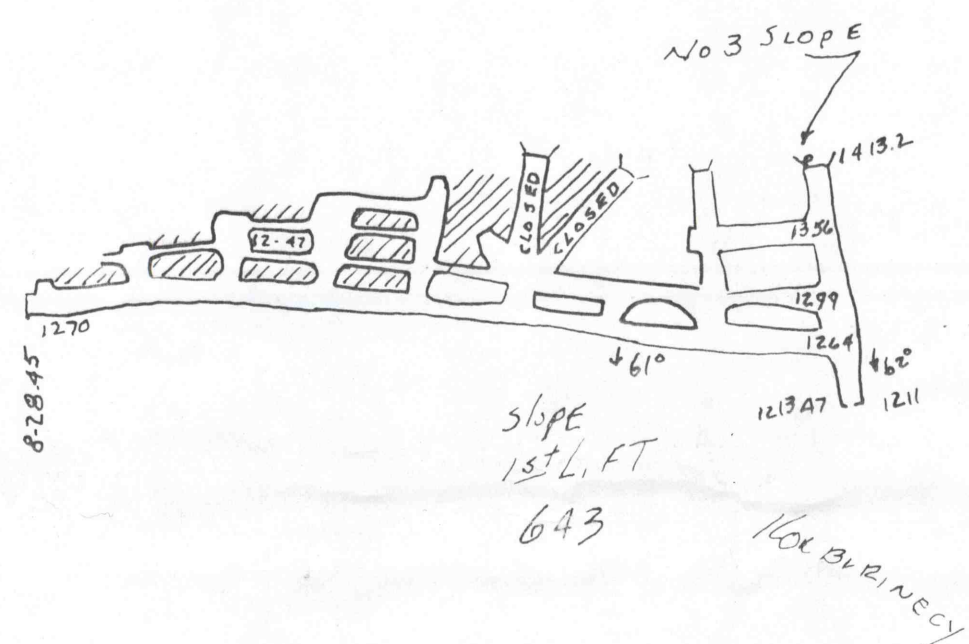

TRACED FROM PLAN
OF
NORTH FRANKLIN COLLIERY
VAINS #2, 3 & 5
DATE: JULY 1, 1912
SCALE: 1" = 100'
PLAN #7 OF 8