
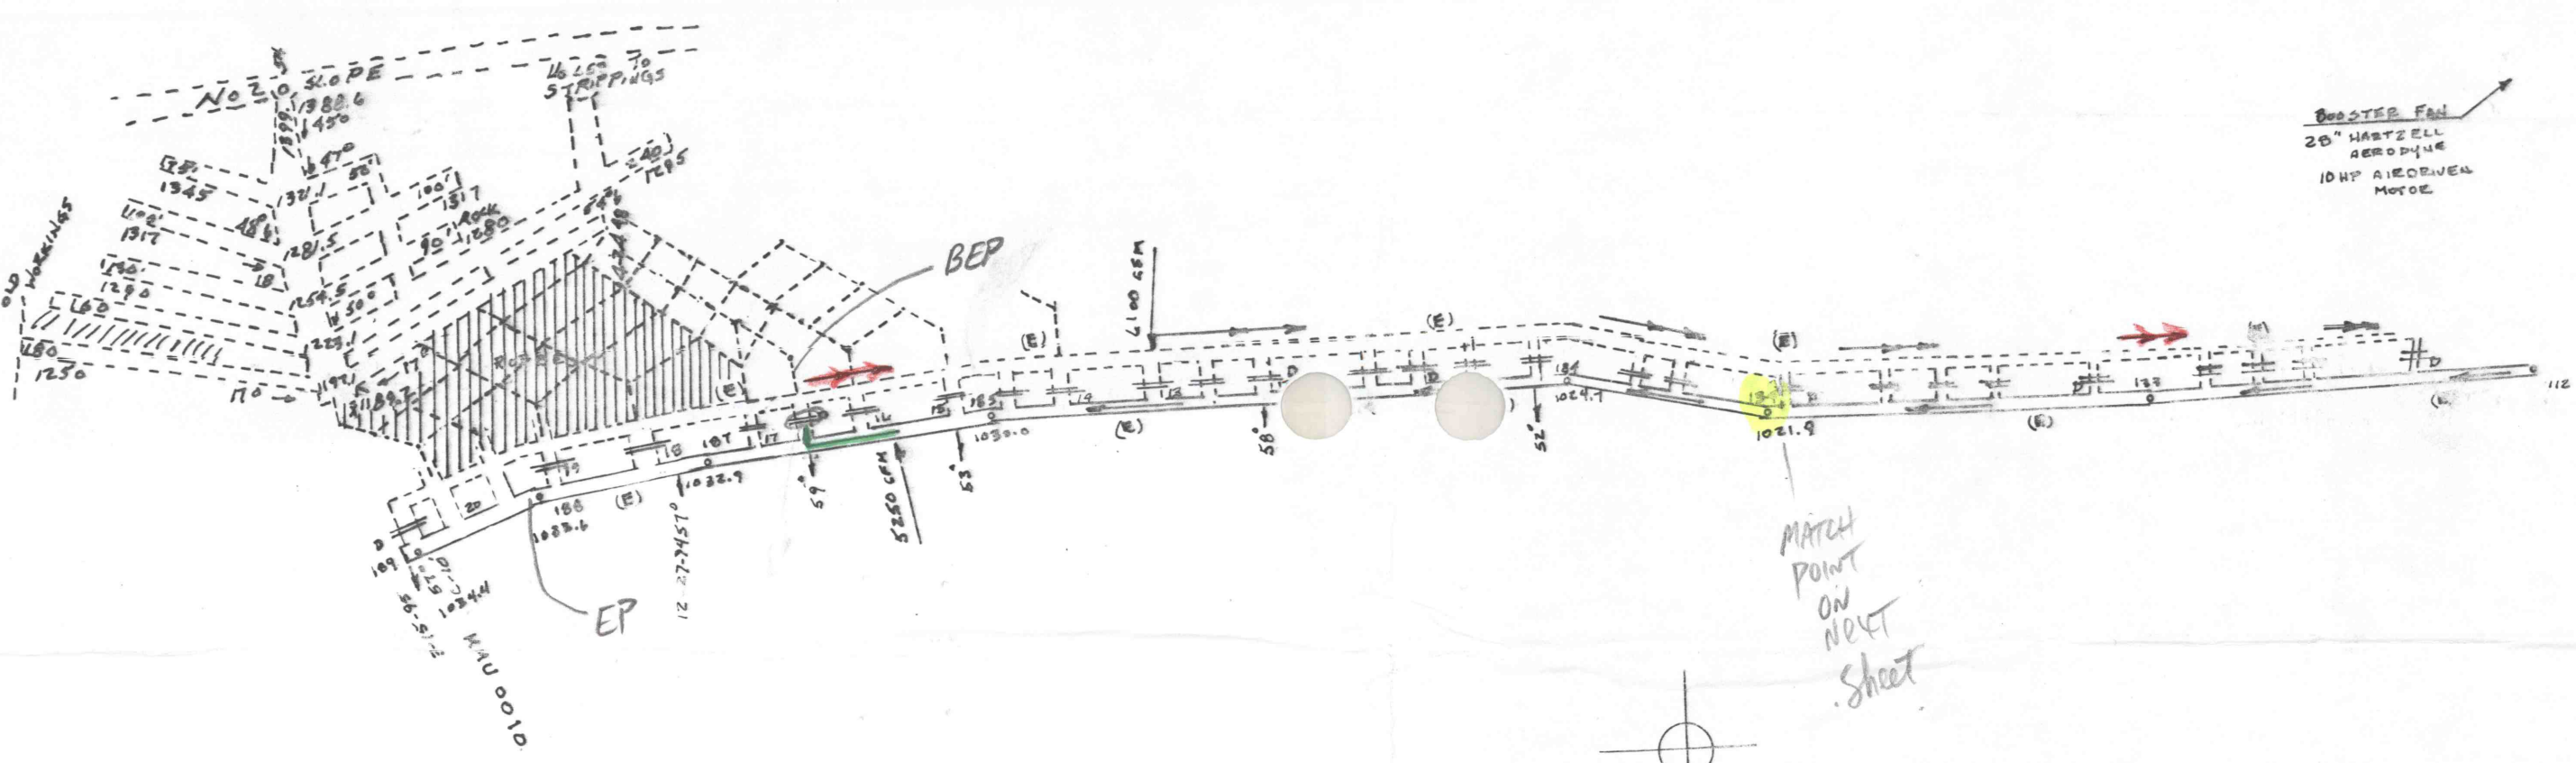


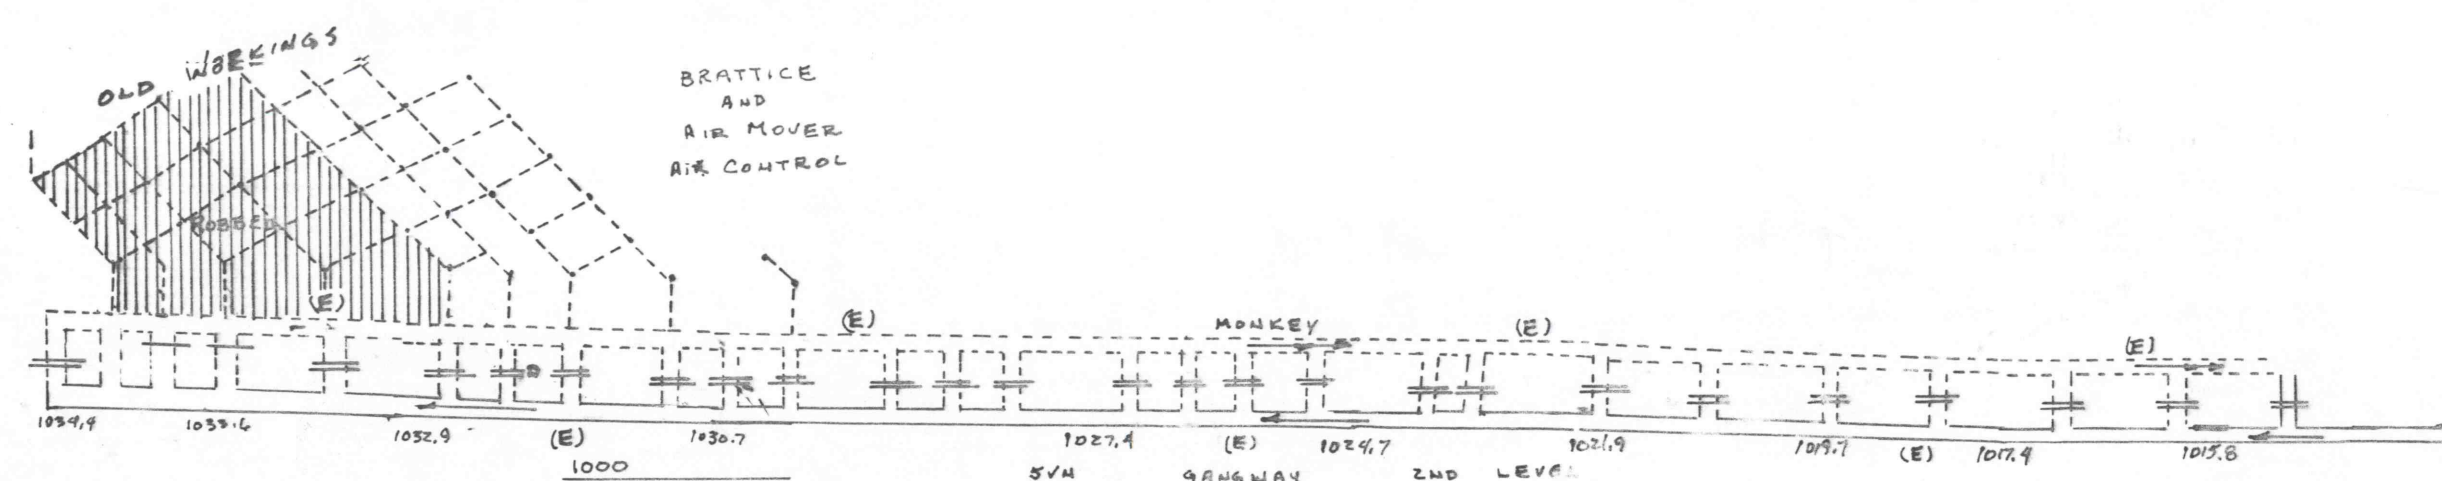

PLAN #2A.

RECEIVED
 MAR 10 1987
 U.S. DEPT. OF LABOR
 HSHA
 WILKES-BARRE, PA.