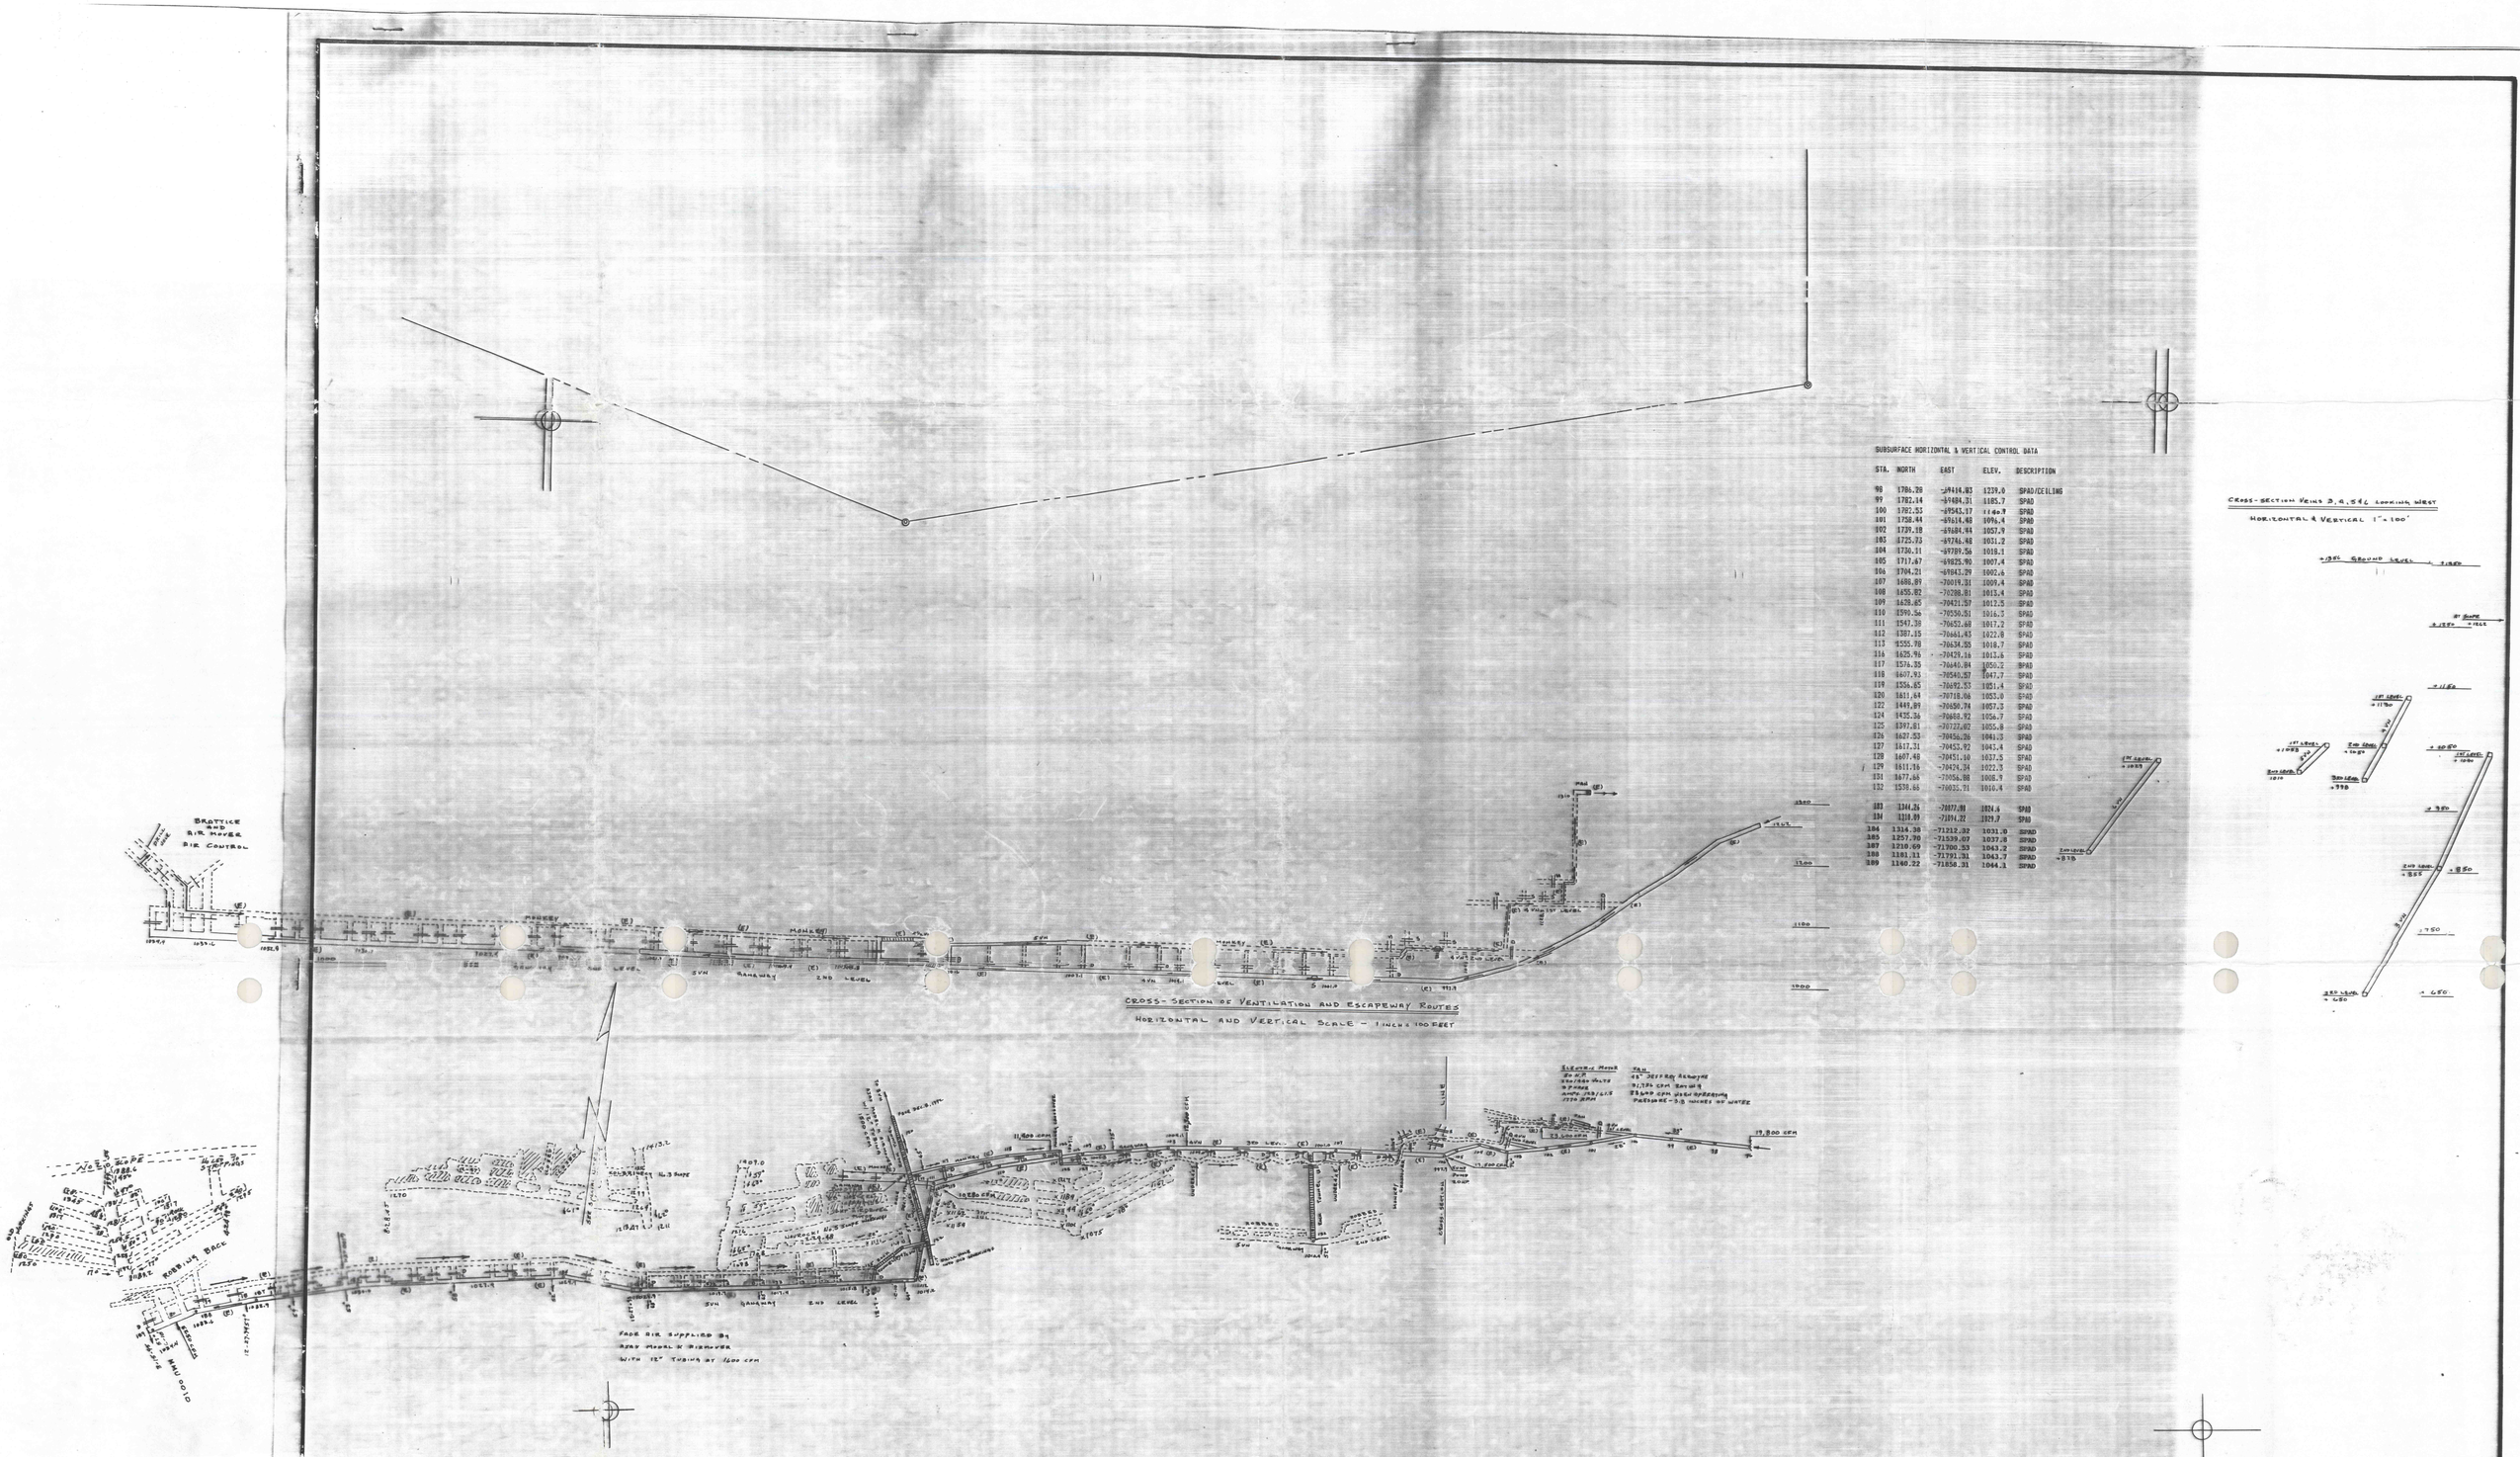

SUBSURFACE HORIZONTAL & VERTICAL CONTROL DATA

STA.	NORTH	EAST	ELEV.	DESCRIPTION
98	1786.28	-69414.83	1239.0	SPAD/CEILING
99	1782.14	-69484.31	1185.7	SPAD
100	1782.53	-69543.17	1146.9	SPAD
101	1758.44	-69614.48	1096.4	SPAD
102	1739.18	-69684.44	1057.9	SPAD
103	1725.73	-69746.48	1031.2	SPAD
104	1720.11	-69789.56	1018.1	SPAD
105	1717.67	-69825.90	1007.4	SPAD
106	1704.21	-69843.29	1002.6	SPAD
107	1688.89	-70019.31	1009.4	SPAD
108	1635.82	-70288.81	1013.4	SPAD
109	1658.65	-70421.59	1012.5	SPAD
110	1590.56	-70530.51	1016.3	SPAD
111	1547.38	-70652.68	1017.2	SPAD
112	1587.15	-70661.43	1022.8	SPAD
113	1555.78	-70634.35	1018.7	SPAD
114	1625.94	-70429.16	1013.6	SPAD
117	1576.35	-70640.84	1050.2	SPAD
118	1607.93	-70540.57	1047.7	SPAD
119	1556.65	-70692.53	1051.4	SPAD
120	1611.64	-70718.06	1053.0	SPAD
122	1449.89	-70650.74	1057.3	SPAD
124	1435.54	-70662.92	1056.7	SPAD
125	1397.81	-70727.82	1055.8	SPAD
126	1627.53	-70456.26	1041.3	SPAD
127	1617.31	-70453.92	1043.4	SPAD
128	1607.48	-70451.16	1037.5	SPAD
129	1611.76	-70424.34	1022.3	SPAD
131	1677.66	-70056.88	1008.9	SPAD
132	1538.66	-70035.71	1010.4	SPAD
133	1344.24	-70877.90	1024.6	SPAD
134	1318.89	-71014.22	1029.9	SPAD
184	1314.38	-71212.32	1031.0	SPAD
185	1257.90	-71539.07	1037.8	SPAD
187	1210.69	-71700.53	1043.2	SPAD
188	1181.11	-71791.31	1043.7	SPAD
189	1160.22	-71854.31	1044.1	SPAD

WILLIAM J. MESSNER, P.L.S.
R.D. #1 BOX 1523
HERNDON, PA. 17830
(717) 758-9266
SU-2886-E

RECEIVED
AUG 17 1995
U.S. DEPT. OF LABOR
MSHA
WILKES-BARRE, PA.

PLAN OF
MINE
AND
VENTILATION
FOR
SNYDER COAL COMPANY
MSHA I.D. #36-02203
DER I.D. #49861303R
R.D. #2 BOX 464
HEGINS, PA. 17938
(717) 682-9698
LOCATED IN
N. AND L. SLOPE
NO. 4 & 5 VEINS - SOUTH DIP
BIG MOUNTAIN
TOWNSHIP OF ZERBY
COUNTY OF NORTHUMBERLAND
COMMONWEALTH OF PENNSYLVANIA
SCALE: AS NOTED
DATE: JANUARY 5, 1993
FILE: SNYDER COAL
PLAN 2 OF 8

REVISED: MARCH 15, 1994
AUGUST 8, 1995