
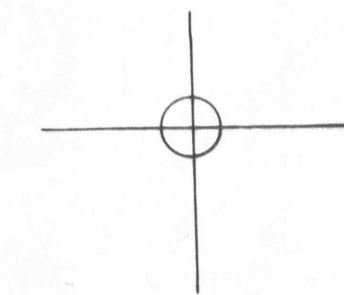
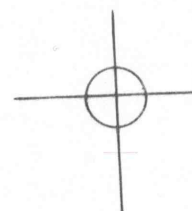
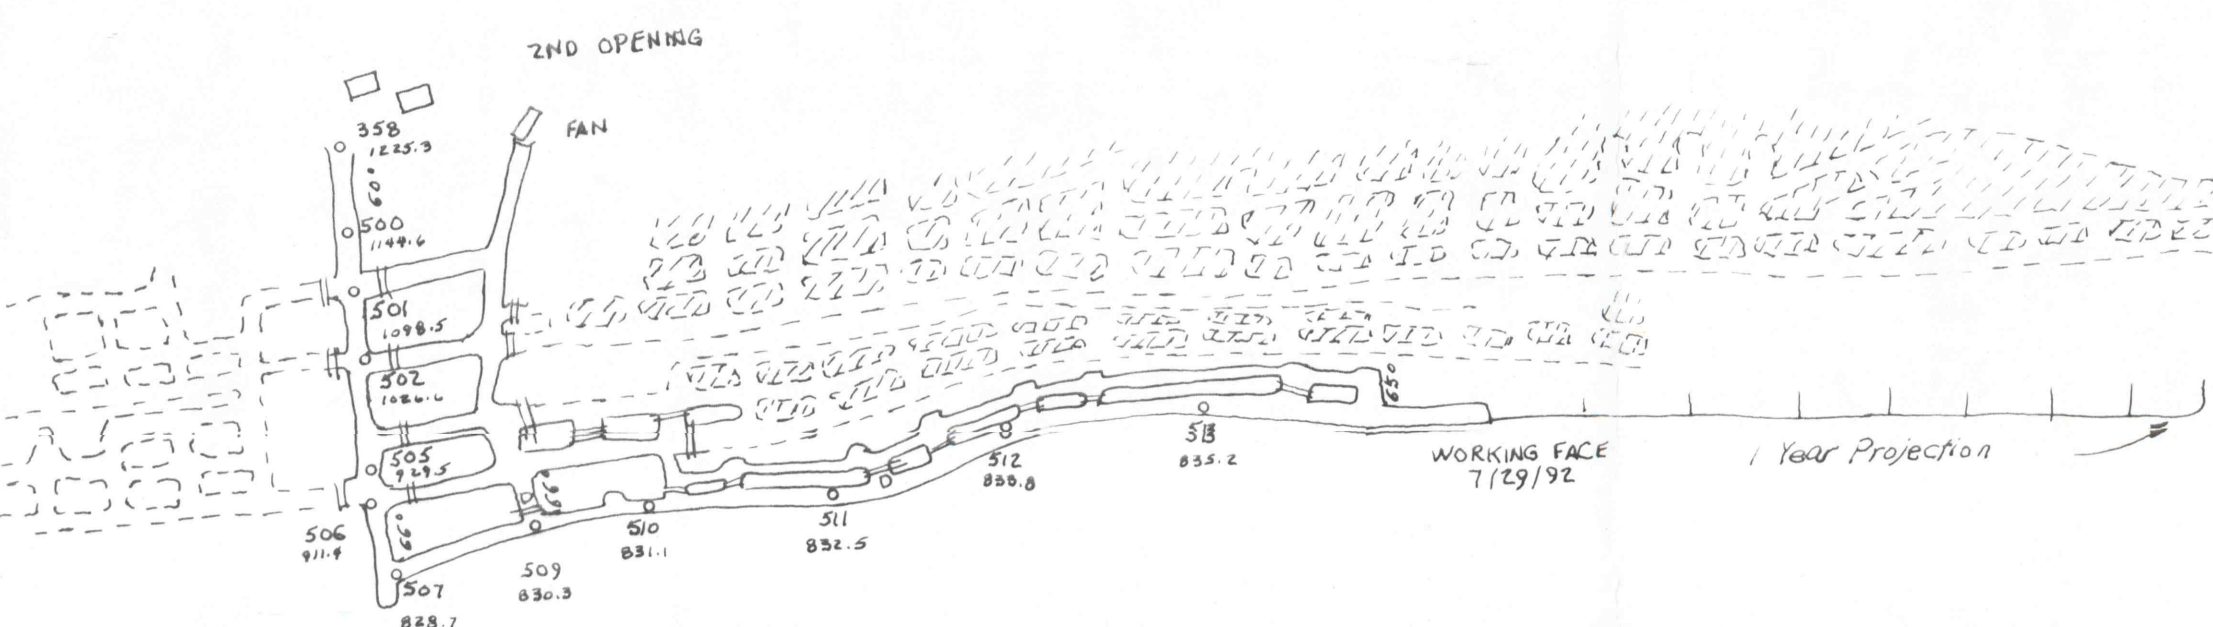


PETER PETERY TRACT

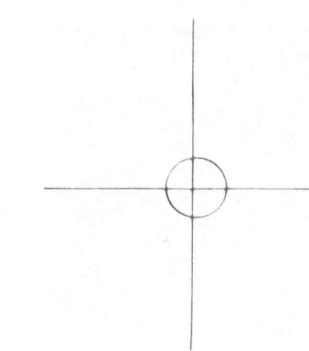

TRACED FROM PLAN
OF
K & L COAL CO.
PREPARED BY
TAYLOR-DOBECK ASSOCIATES
DATE: JUNE 12, 1992
SCALE: 1" = 100'
PLAN #4 OF 8