


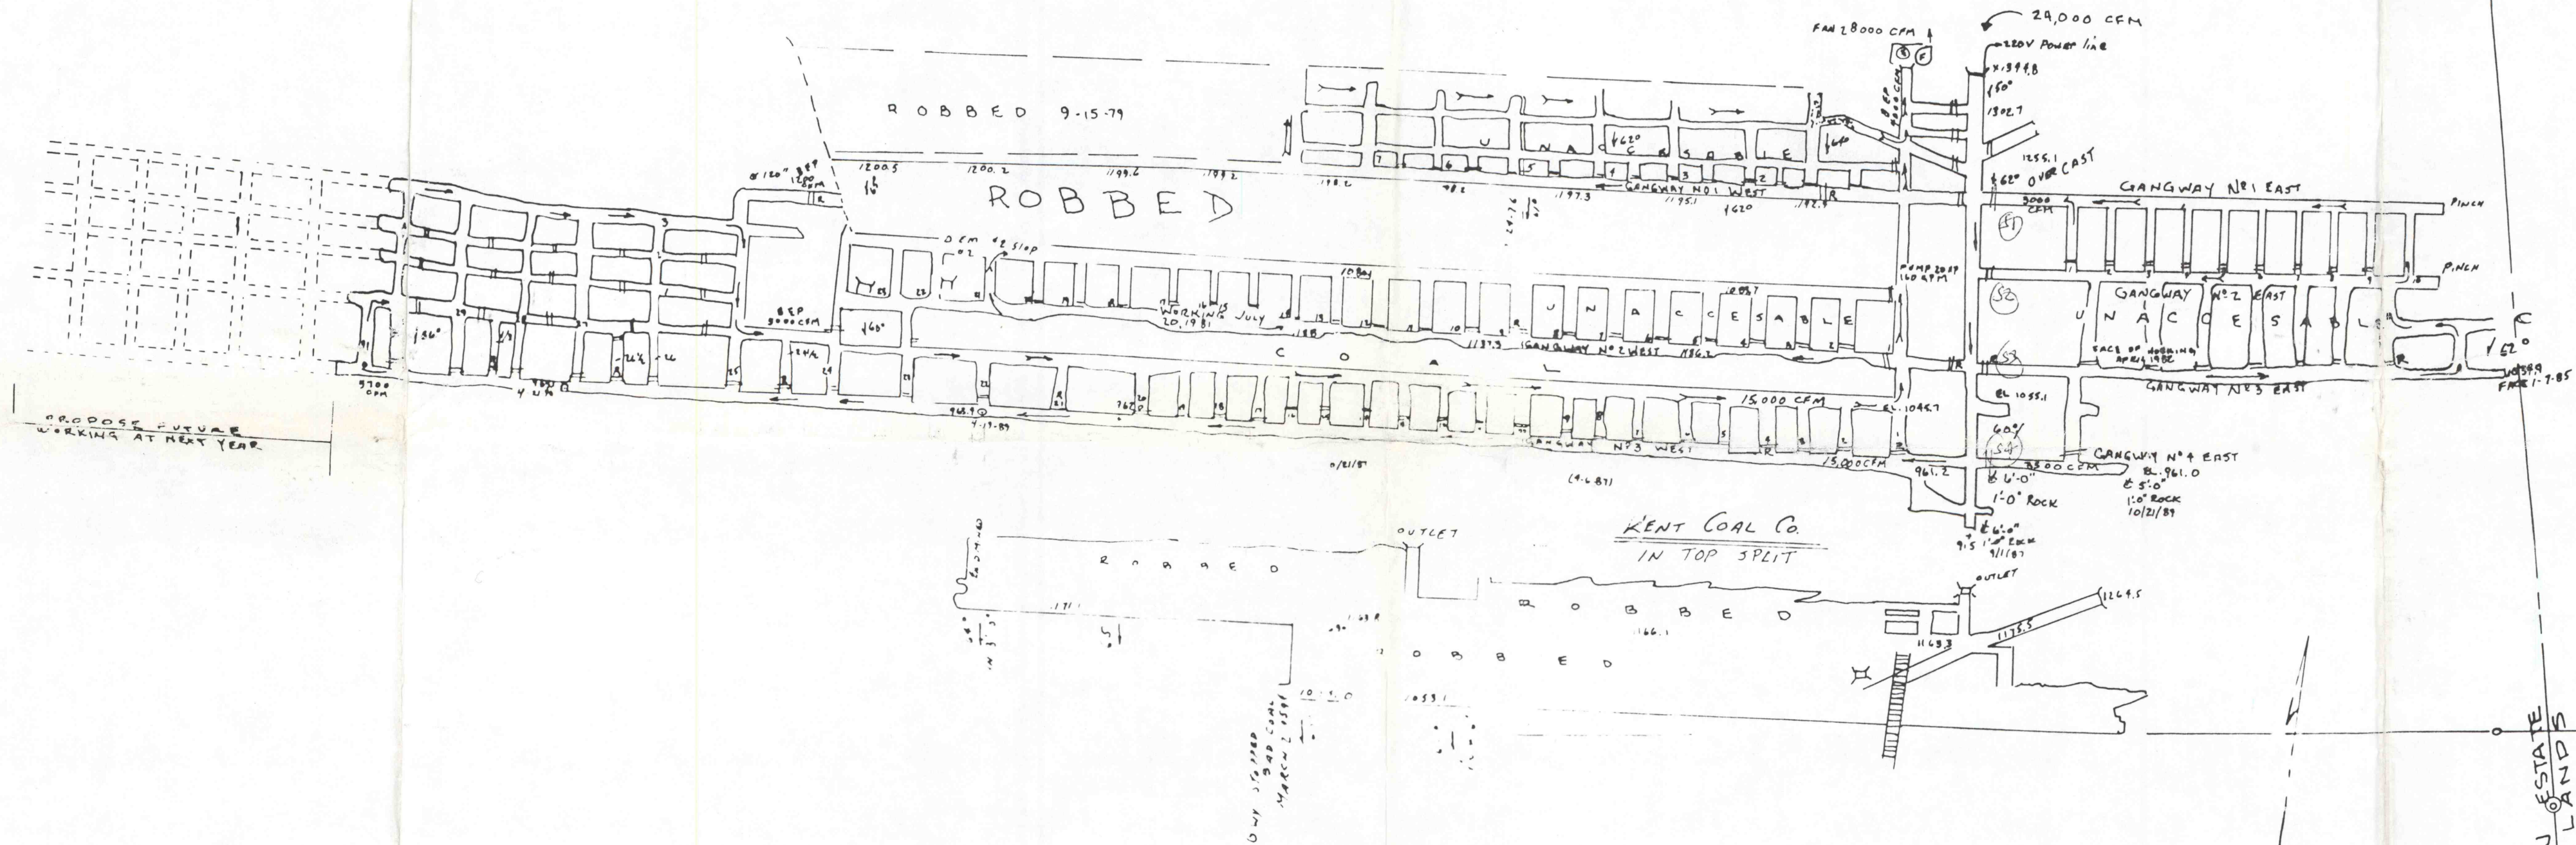

TRACED FROM PLAN
 OF
 S.B.M. COAL CO.
 M & N SLOPE
 PREPARED BY
 BARRY E. TRUMBauer P.E.
 DATE: OCTOBER 22, 1991
 SCALE: 1" = 100'
 PLAN #3 OF 6