New York Fan & Blower Co. - Class II
170 Internal Gas combustion Motor Capable
of 28,000 minimum, Fan Speed 700 RPM
Motor Speed 2,000, Static Efficiency 47%
Total Efficiency 59% 2" Static Pressure

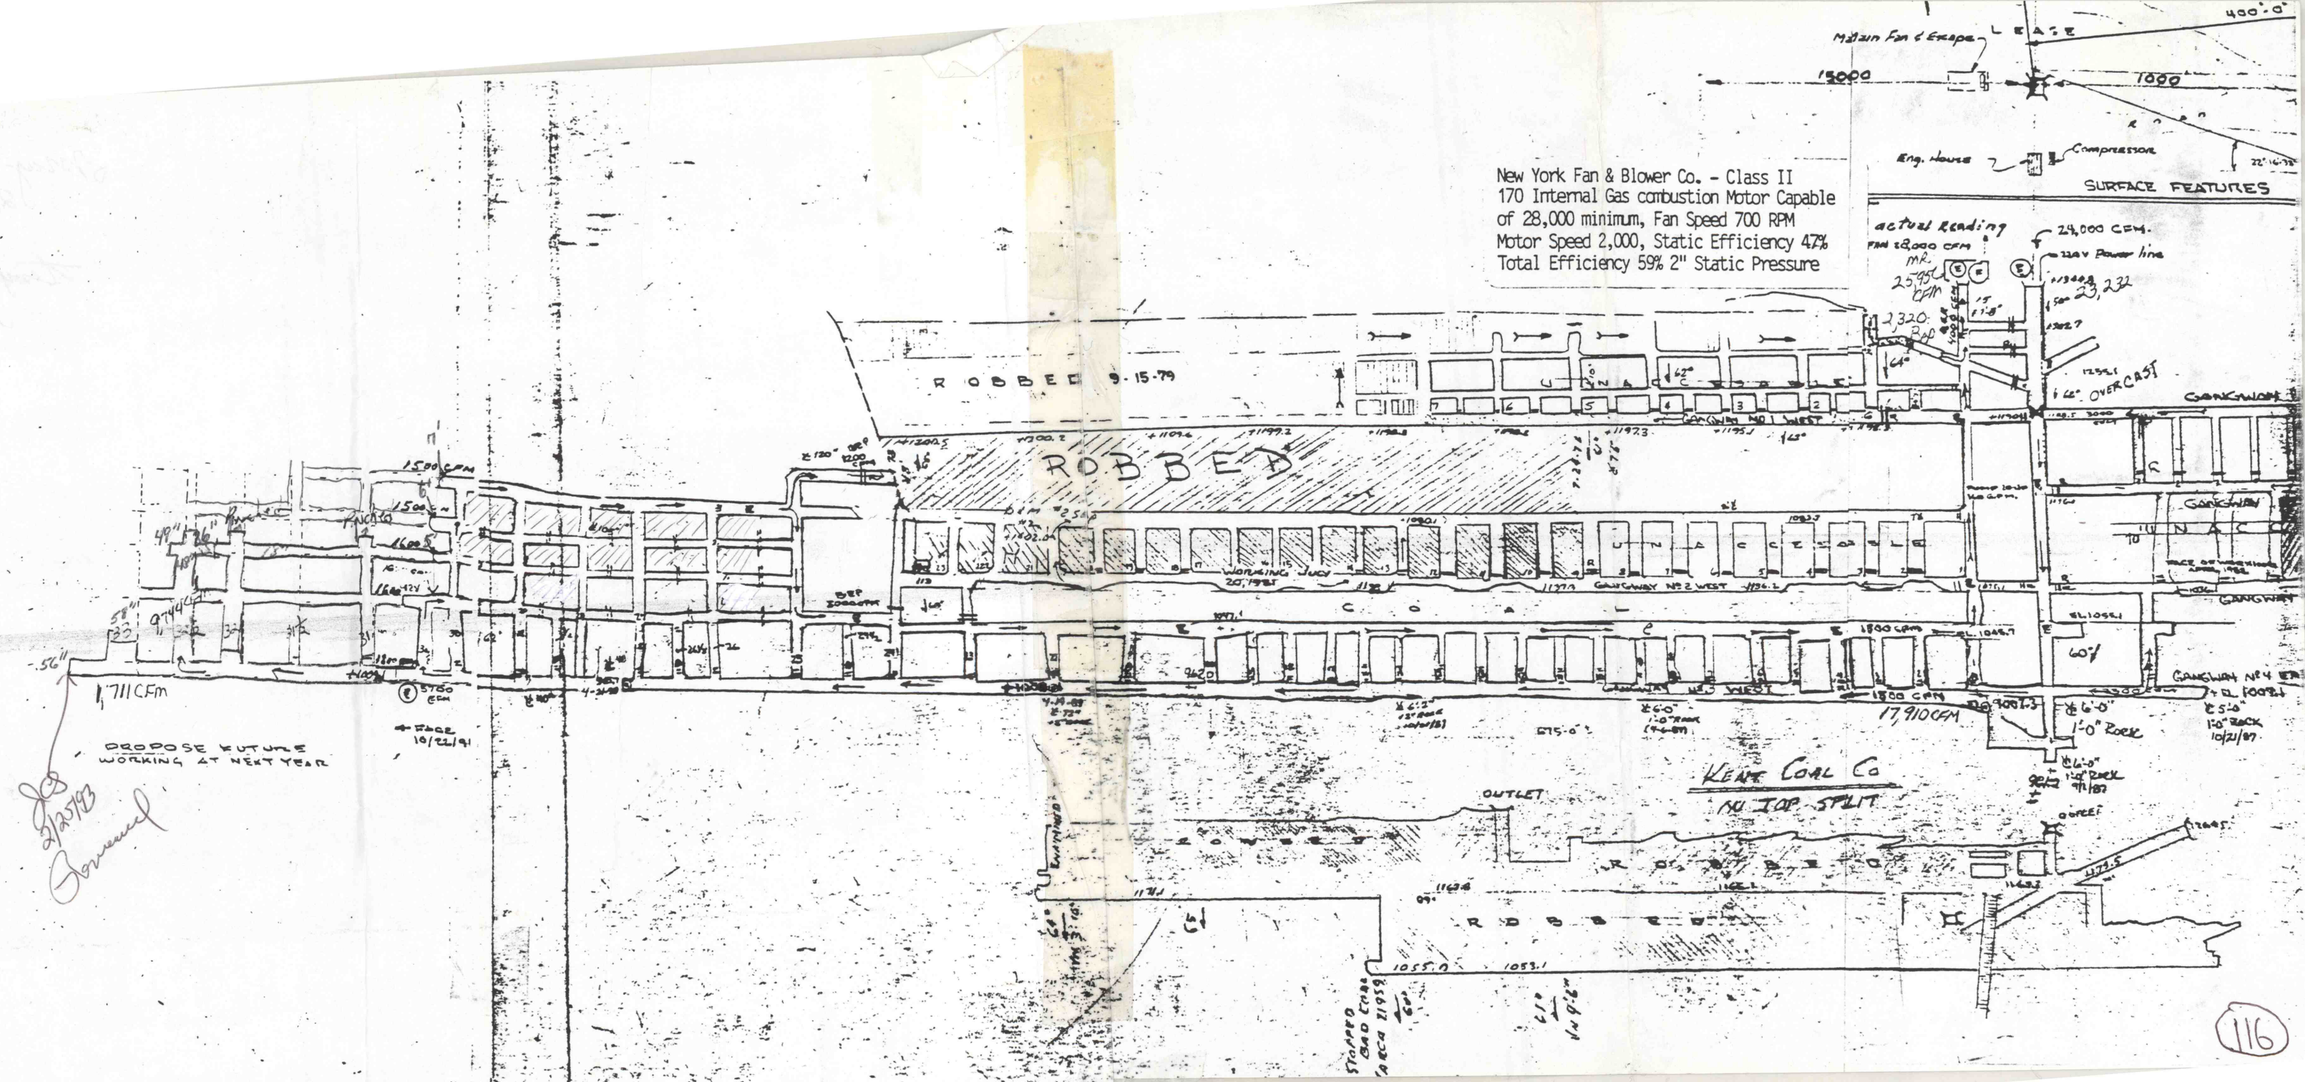

116