


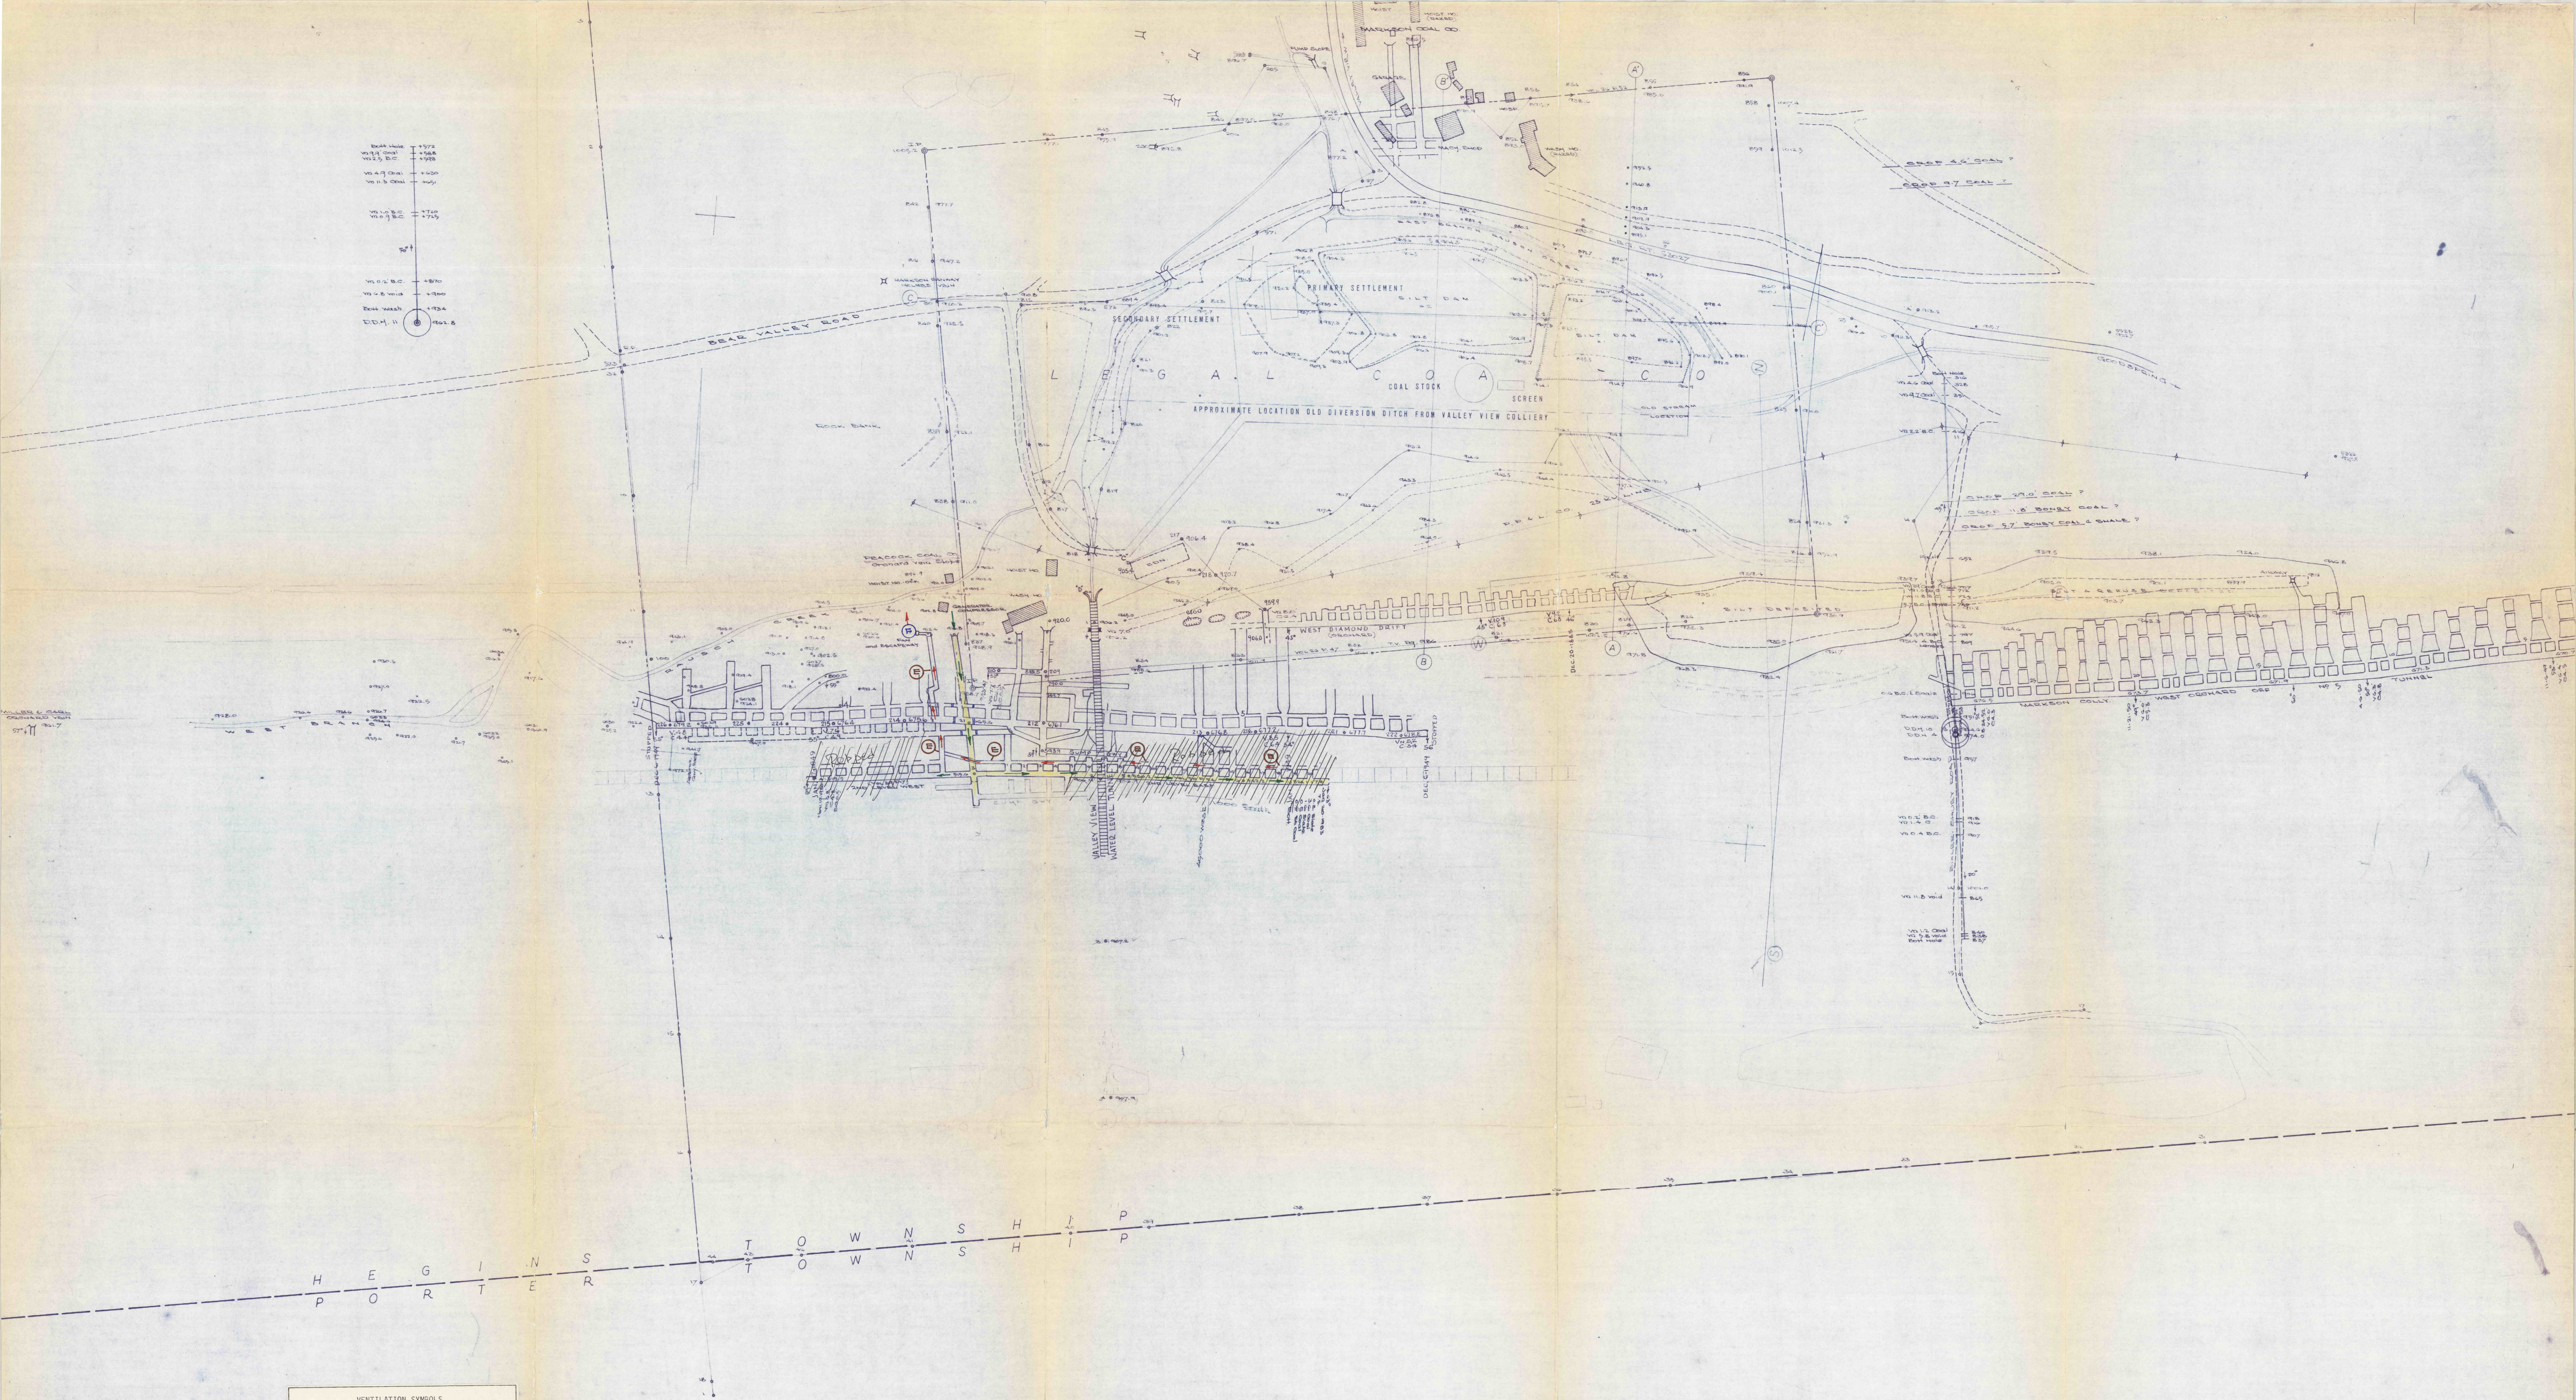

VENTILATION SYMBOLS

(F) = Main Fan	⌘ = Air Bridge
(A) = Auxiliary Fan	⌘ = Regulator
→ = Air Flow - Intake	⌘ = Man Door
→ = Air Flow - Exhaust	V = Velocity, fpm
⌘ = Permanent Stopping	Q = Quantity, cfm
⌘ = Temporary Stopping	WG = Water Gauge

MINE MAP

Showing the location and extent of development of the Peacock Coal Company slope mine. Situate on the South dip Orchard vein, Herfins Township, Schuylkill County, Pa. 56-6732

A.B. Riedel, P.E. Jan. 20, 1983 Scale 1"= 100'

Wm. B. Riedel