


ern Middle Field:
CONYNGHAM TWP.
Shanoy DISTRICT II.



HOLMES 36 ⁰⁶⁴⁰⁰
~~Holmes~~ Coal Company
 HOLMES VN.
 Potts Colliery
 Conyngham Twp Columbia Co.
 PENNSYLVANIA
 1"=100'

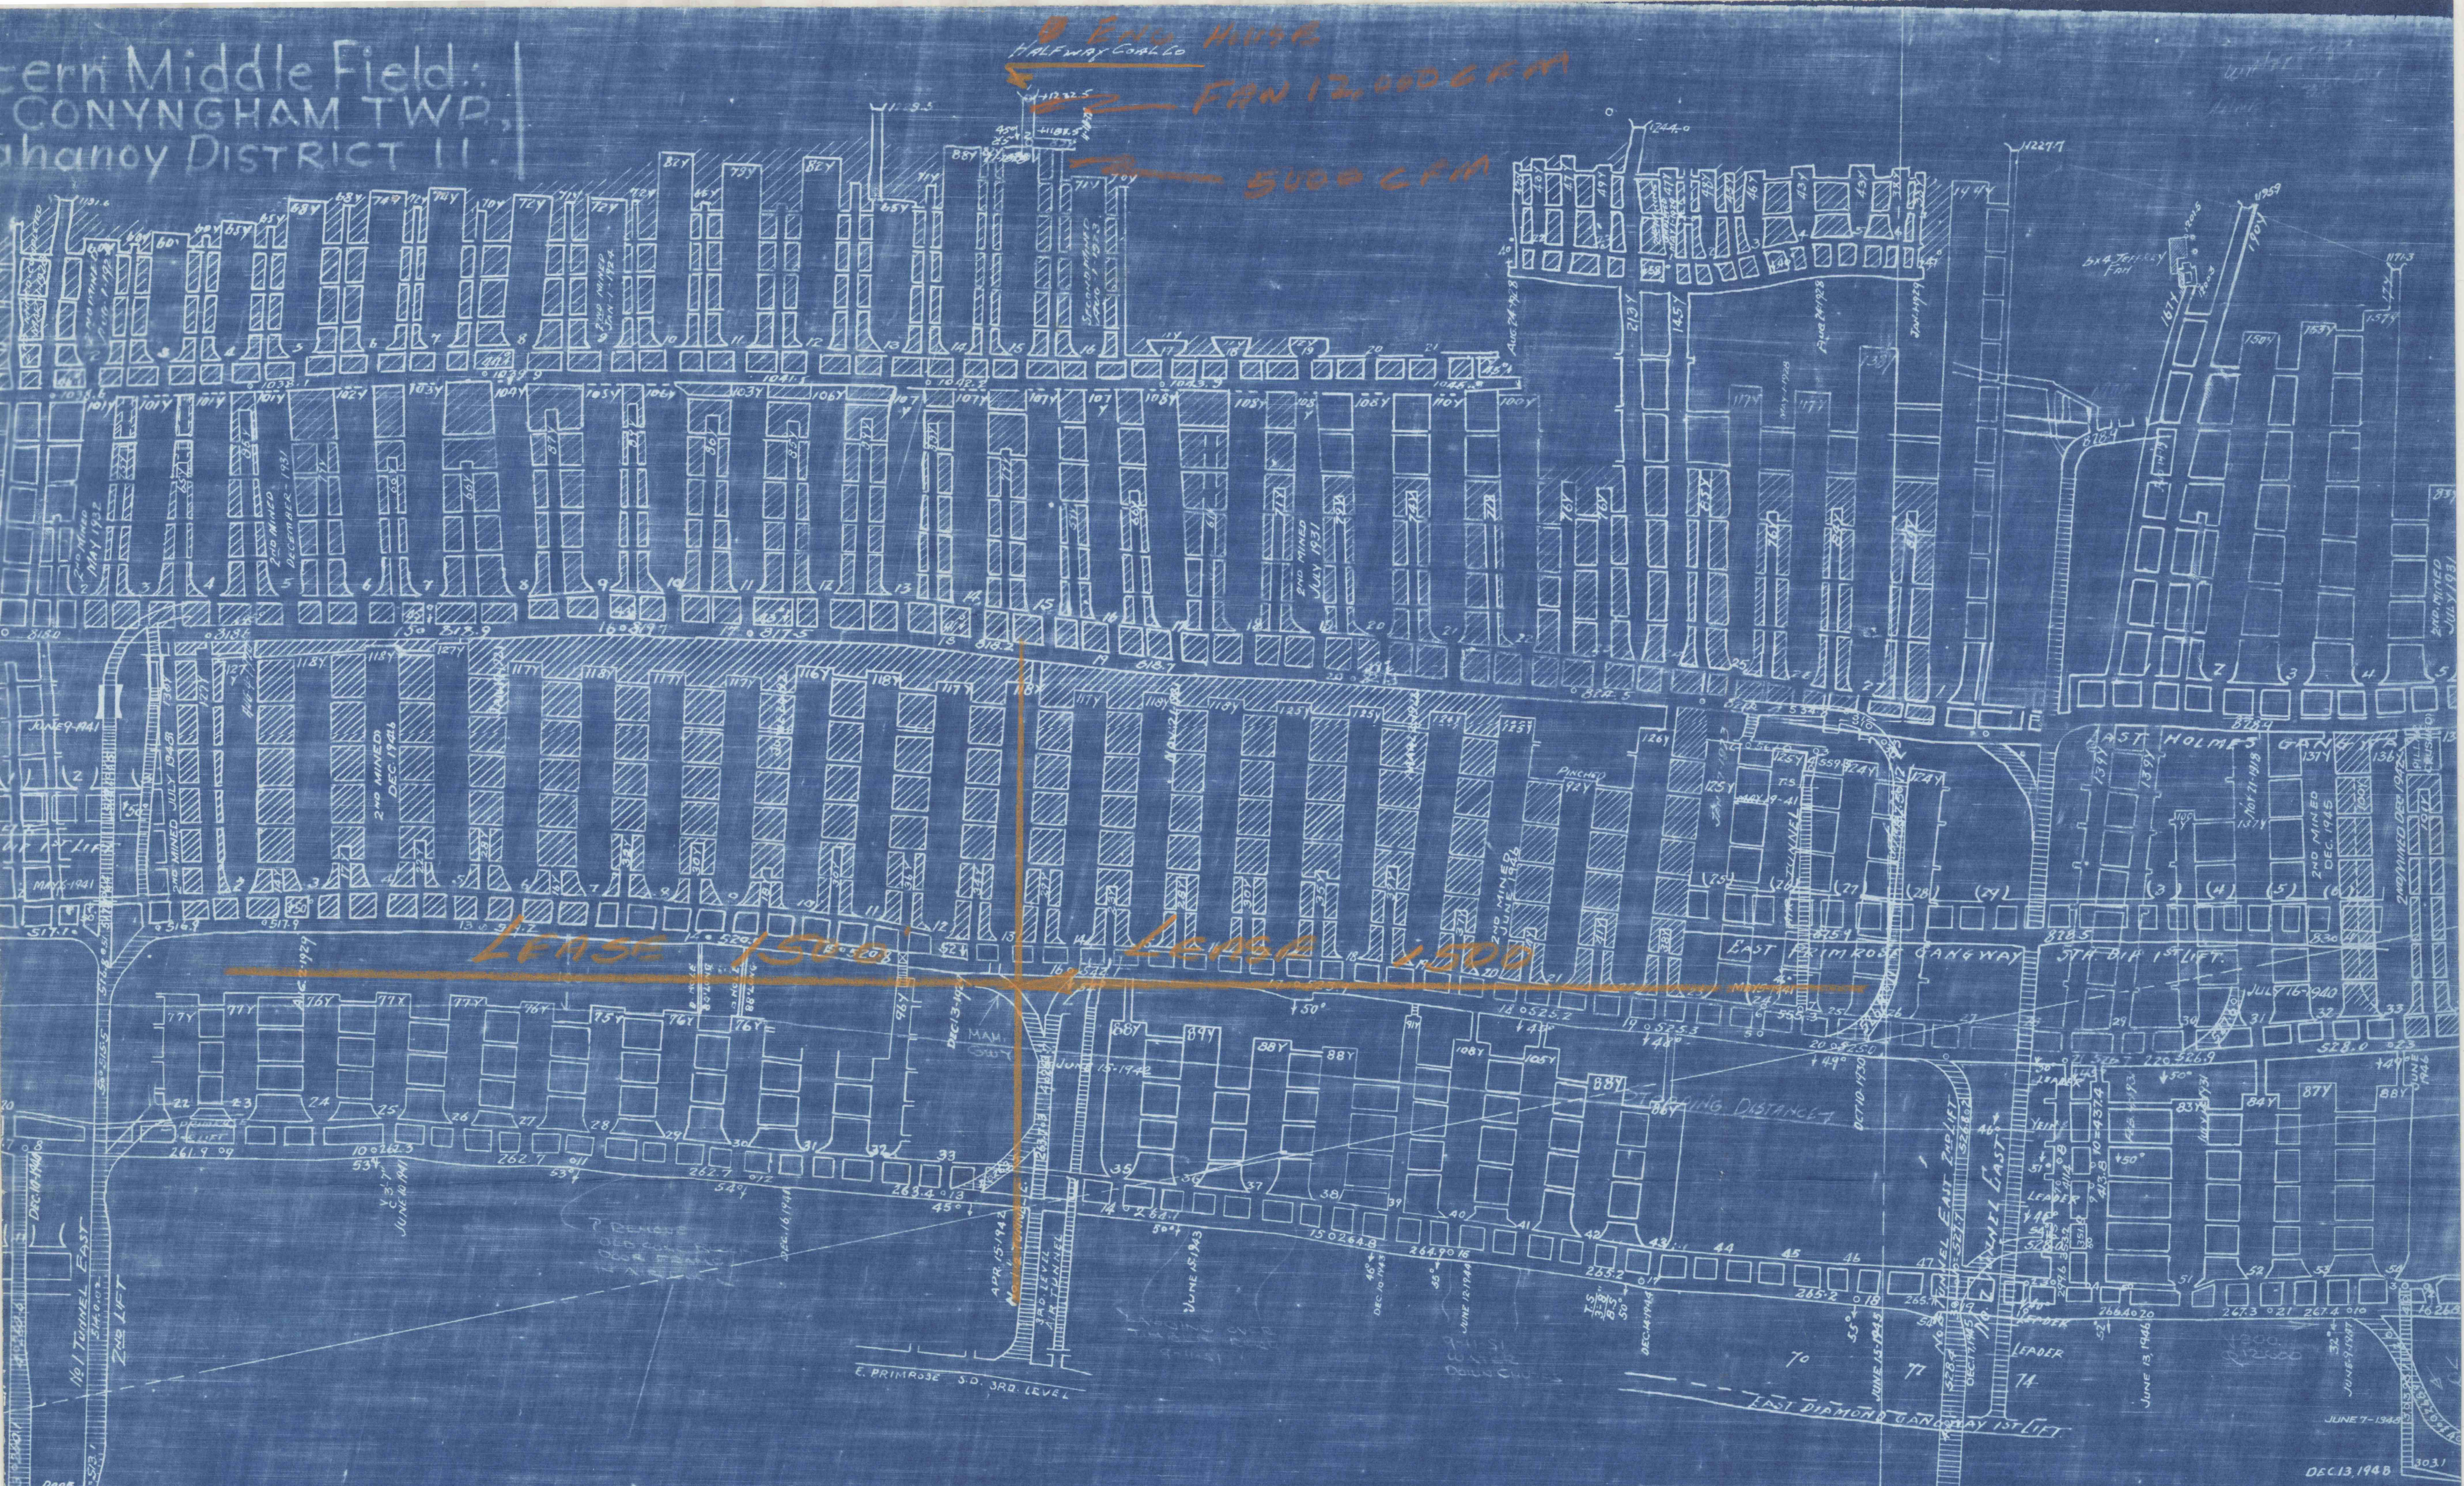