


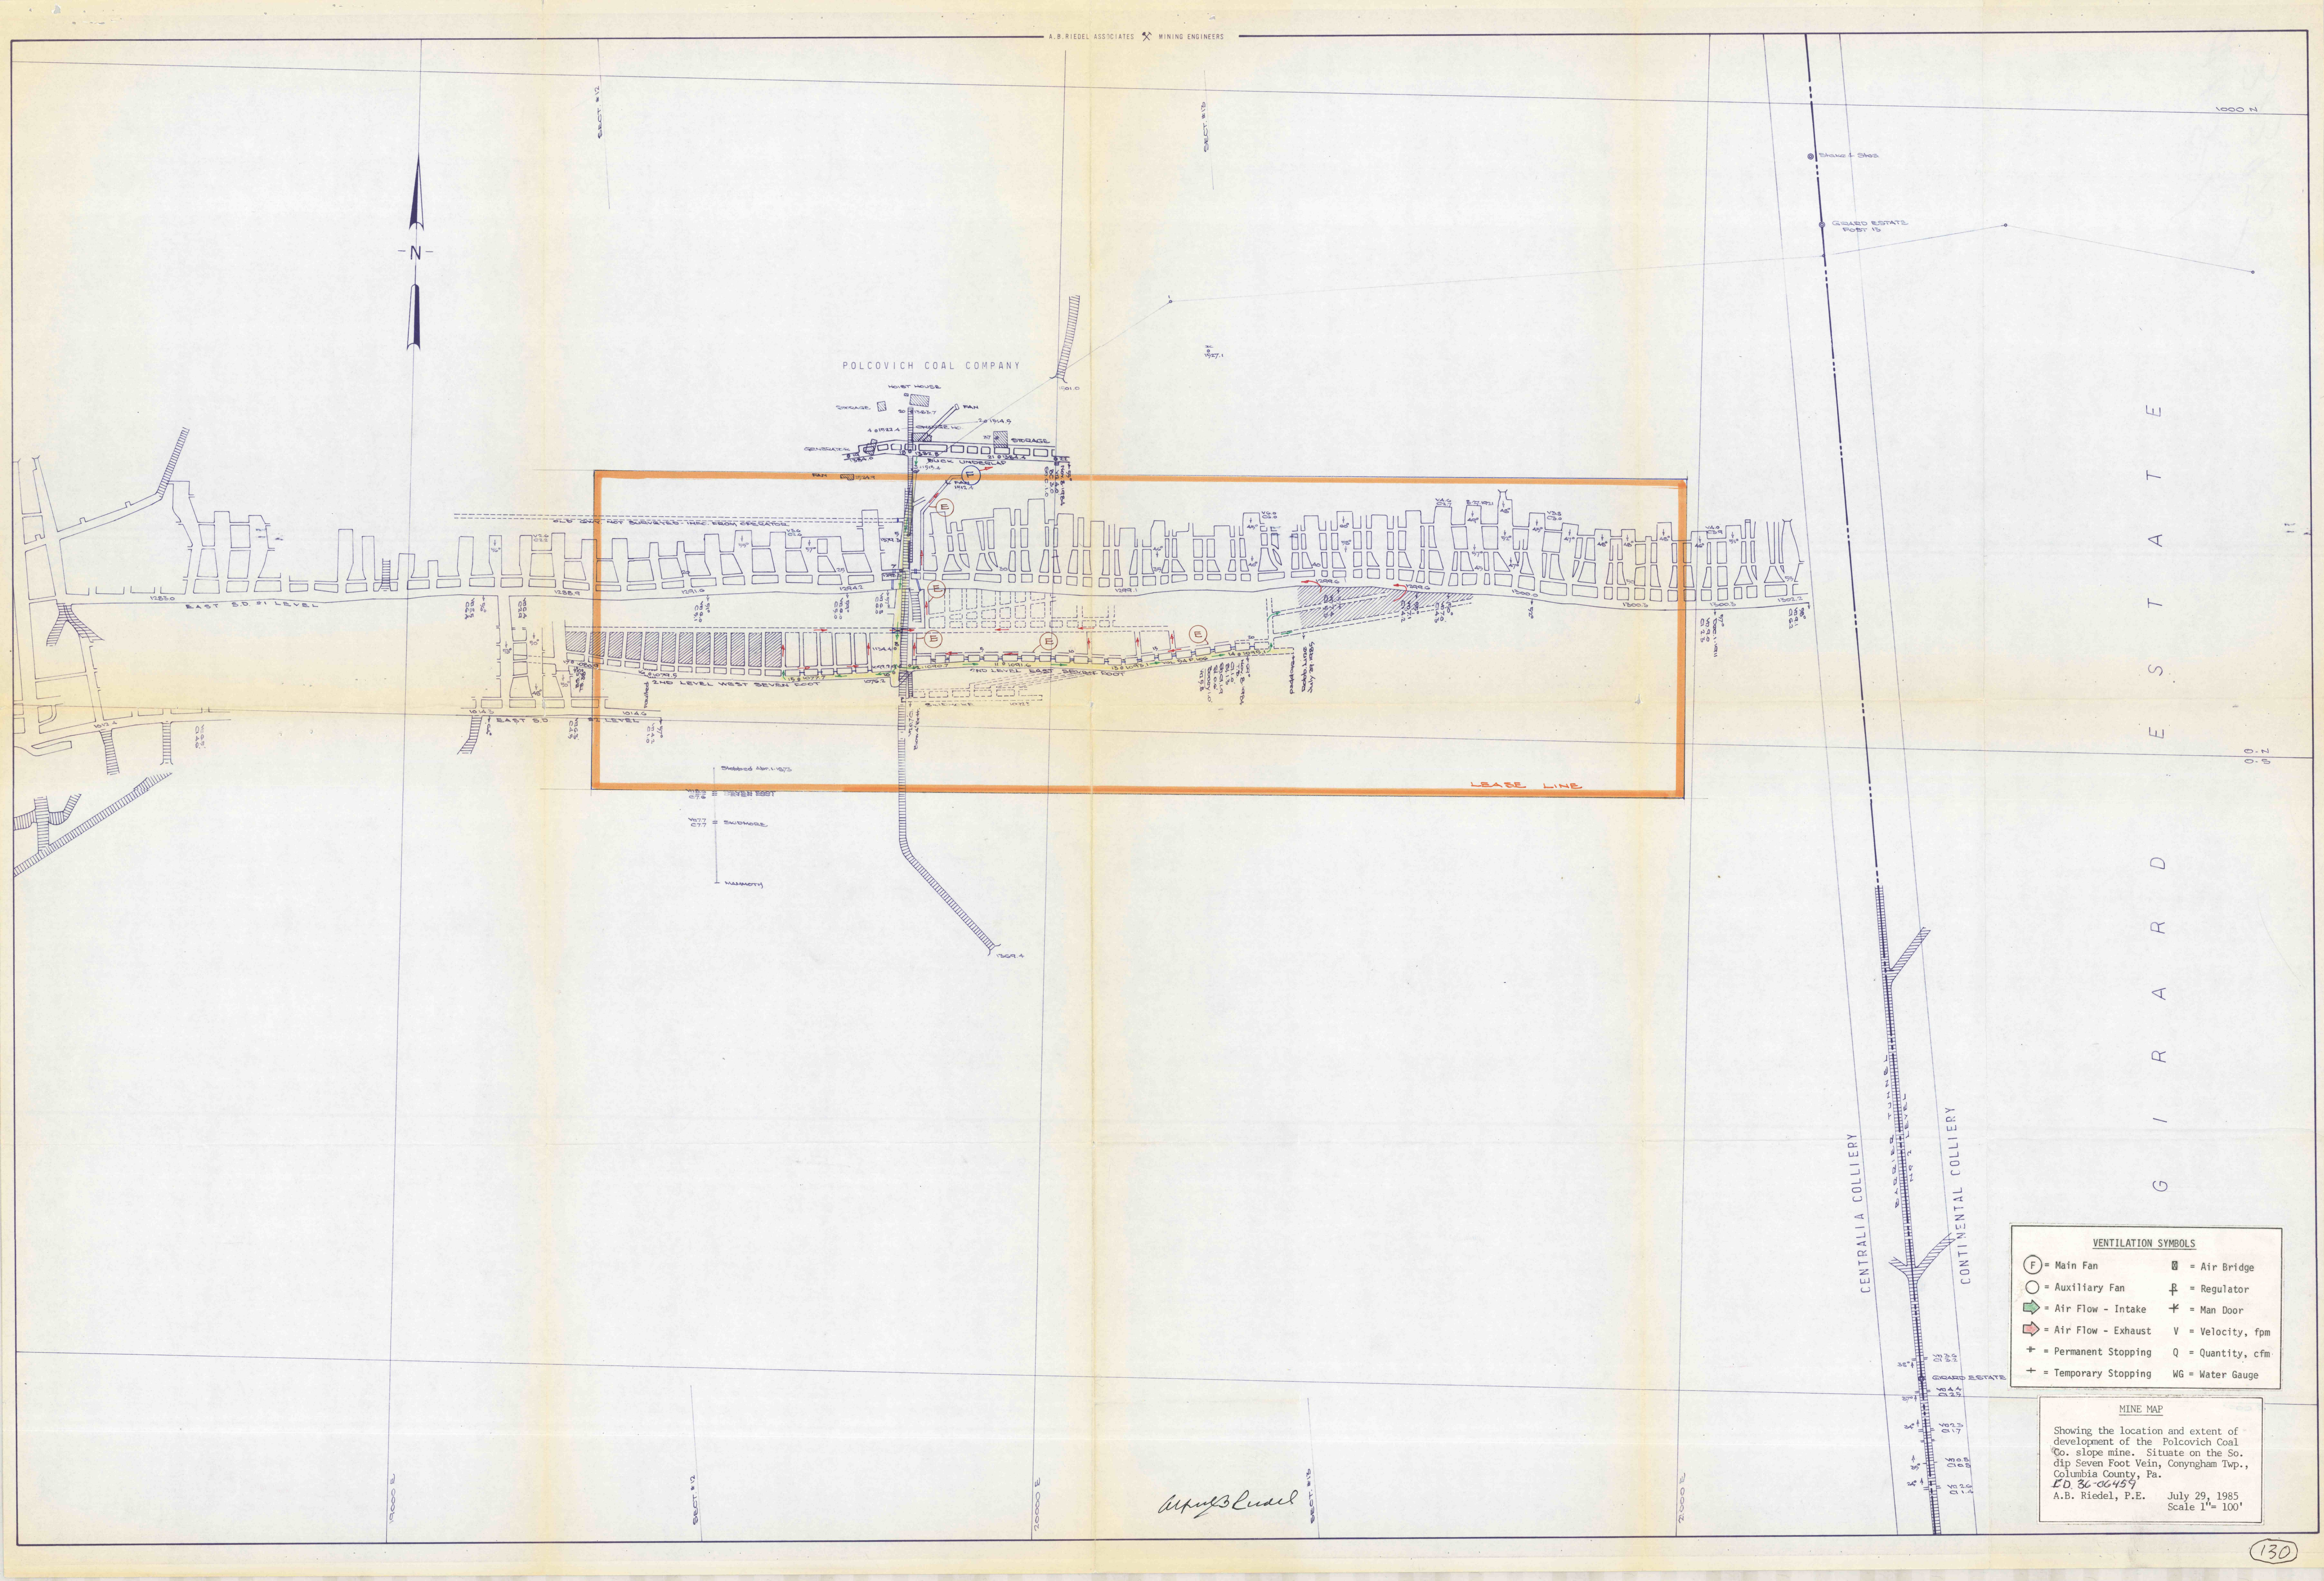

VENTILATION SYMBOLS			
(F) = Main Fan	□ = Air Bridge		
(A) = Auxiliary Fan	⊕ = Regulator		
→ = Air Flow - Intake	⊕ = Man Door		
→ = Air Flow - Exhaust	V = Velocity, fpm		
+ = Permanent Stopping	Q = Quantity, cfm		
+ = Temporary Stopping	WG = Water Gauge		

MINE MAP
 Showing the location and extent of development of the Polcovich Coal Co. slope mine. Situate on the So. dip Seven Foot Vein, Conyngham Twp., Columbia County, Pa.
 E.D. 86-06457
 A.B. Riedel, P.E. July 29, 1985
 Scale 1" = 100'