


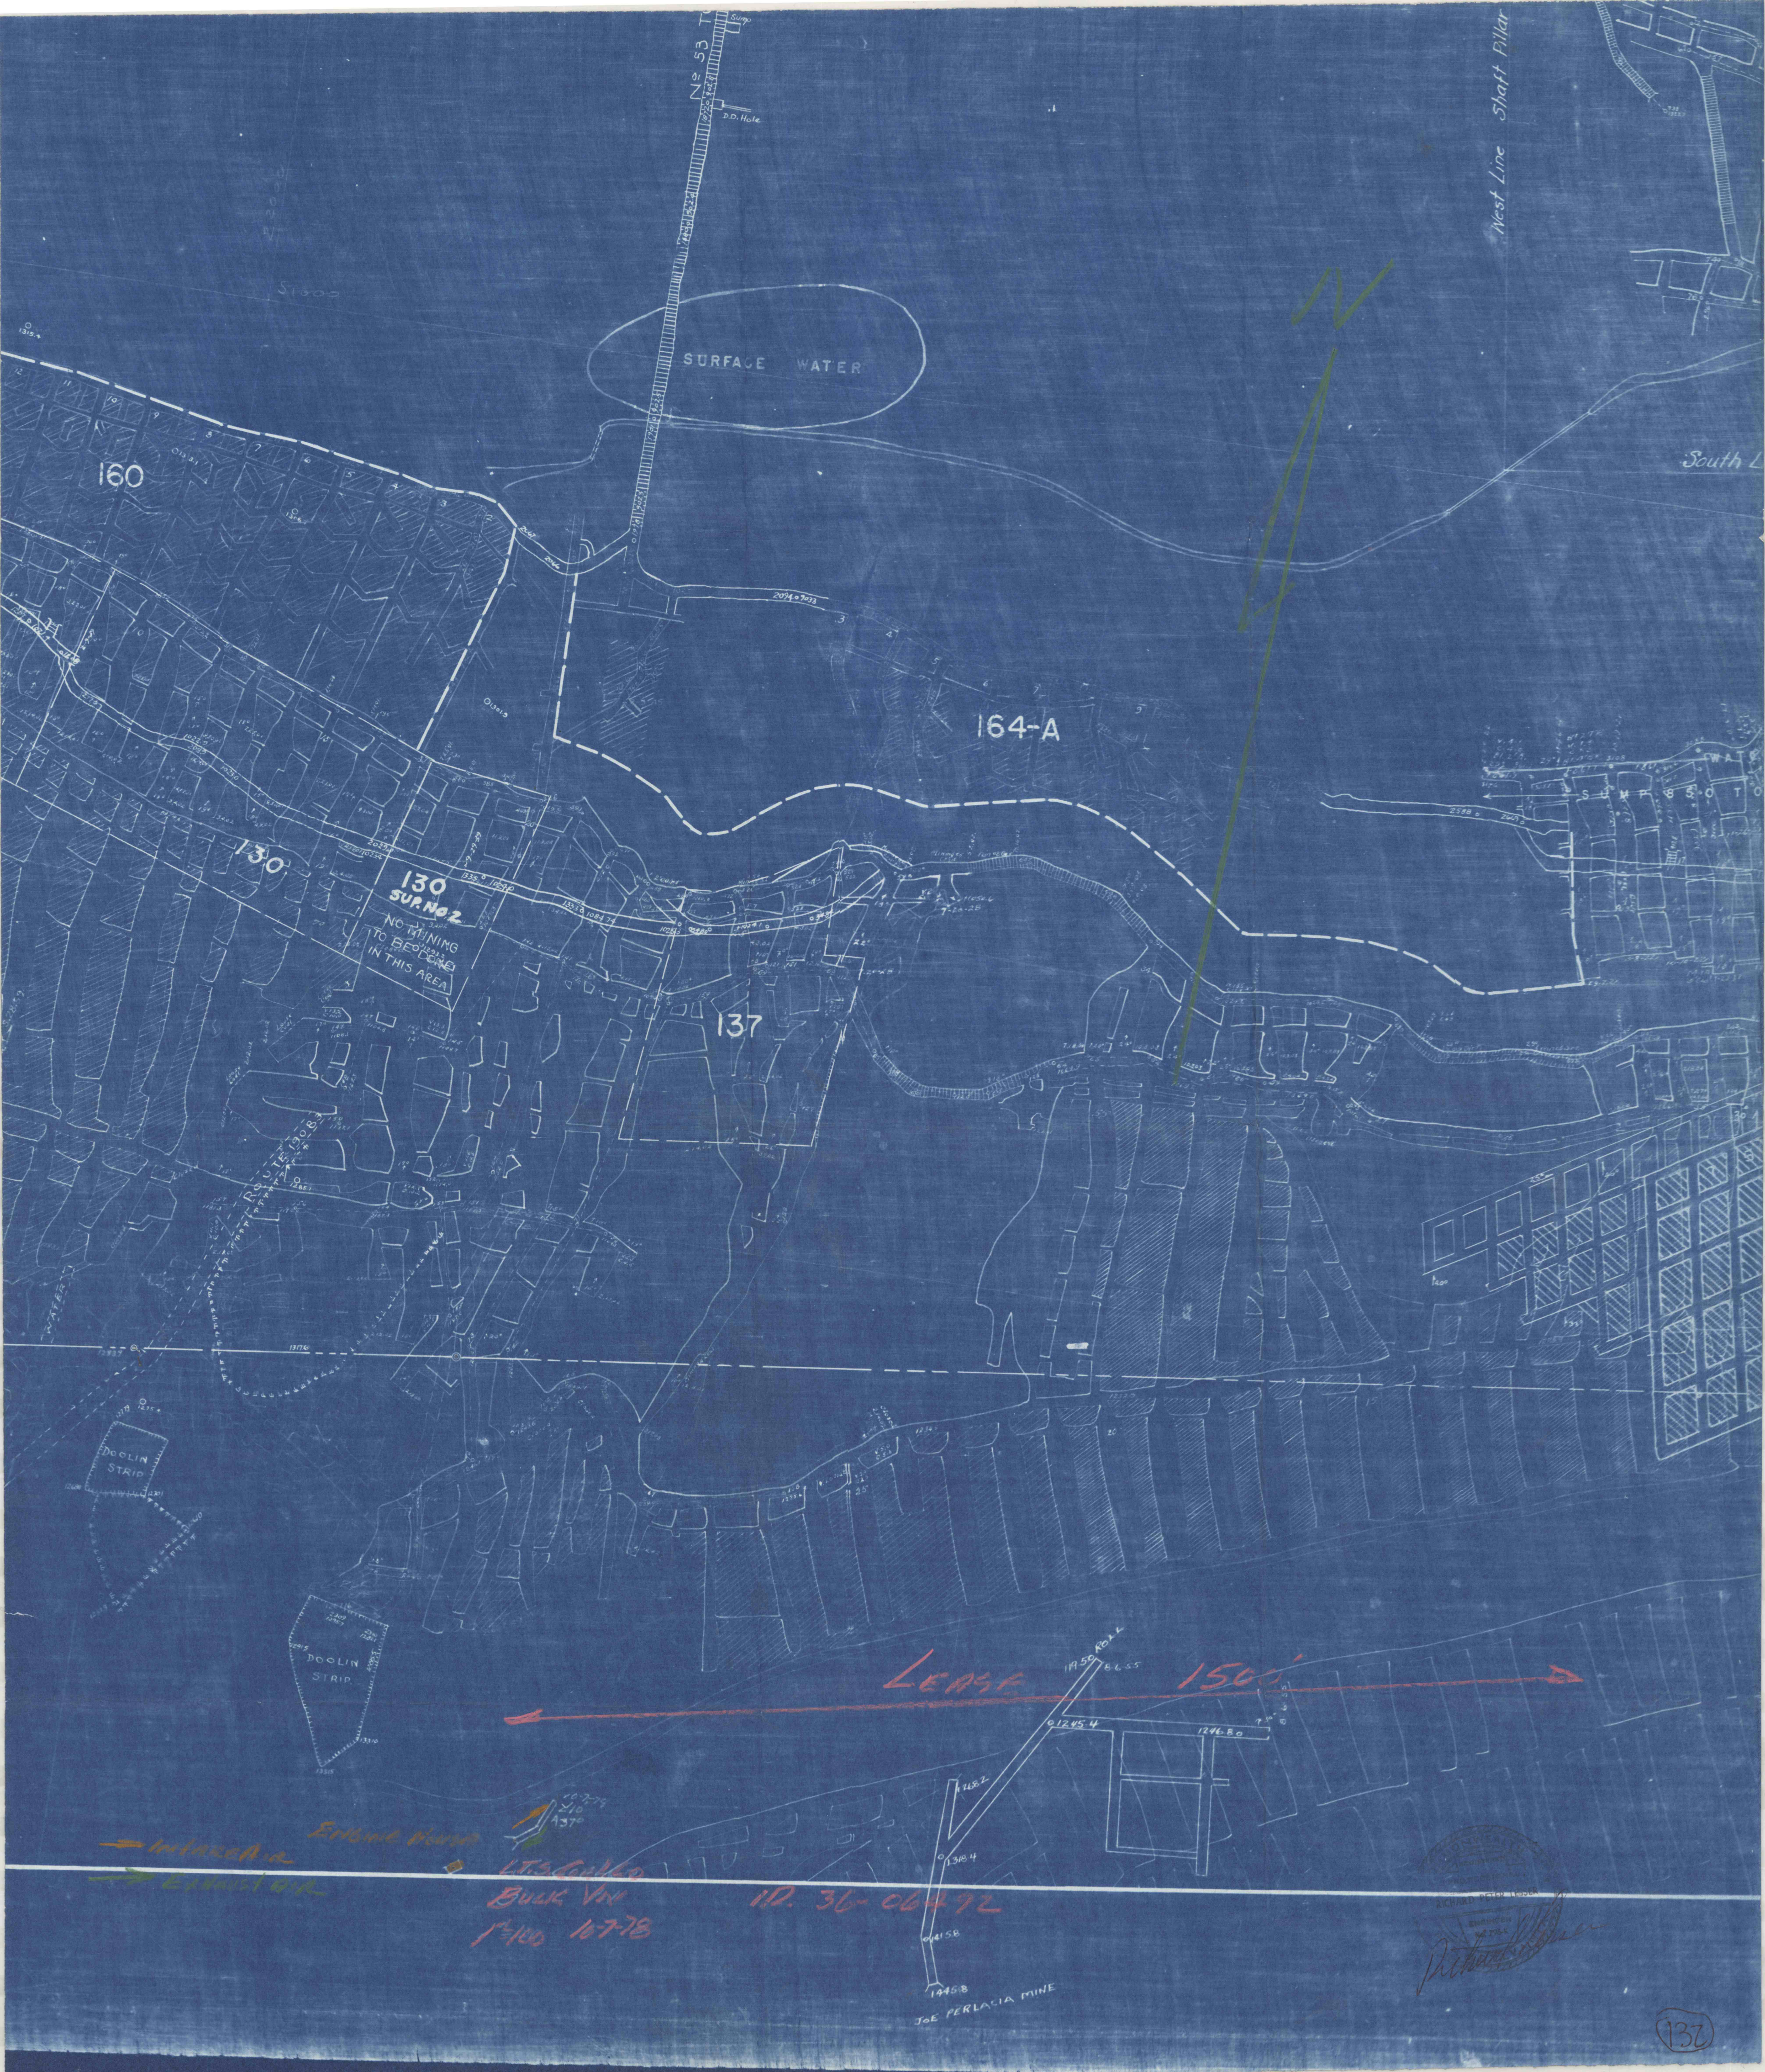

West Line Shaft Pillar

South L

SURFACE WATER

164-A

130
SUP. No. 2

NO MINING
TO BE DONE
IN THIS AREA

137

LEASE

1500'

DOOLIN STRIP

ENGINE HOUSE


LT. 300' 160'

BULK VLN

1-100 167-78

ID. 36-06492

JOE PERLACIA MINE

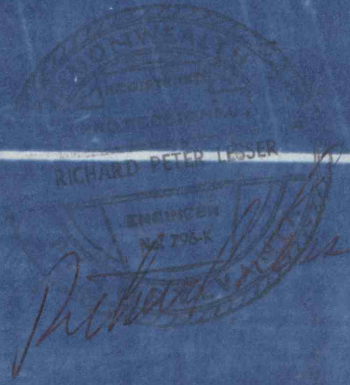

132