


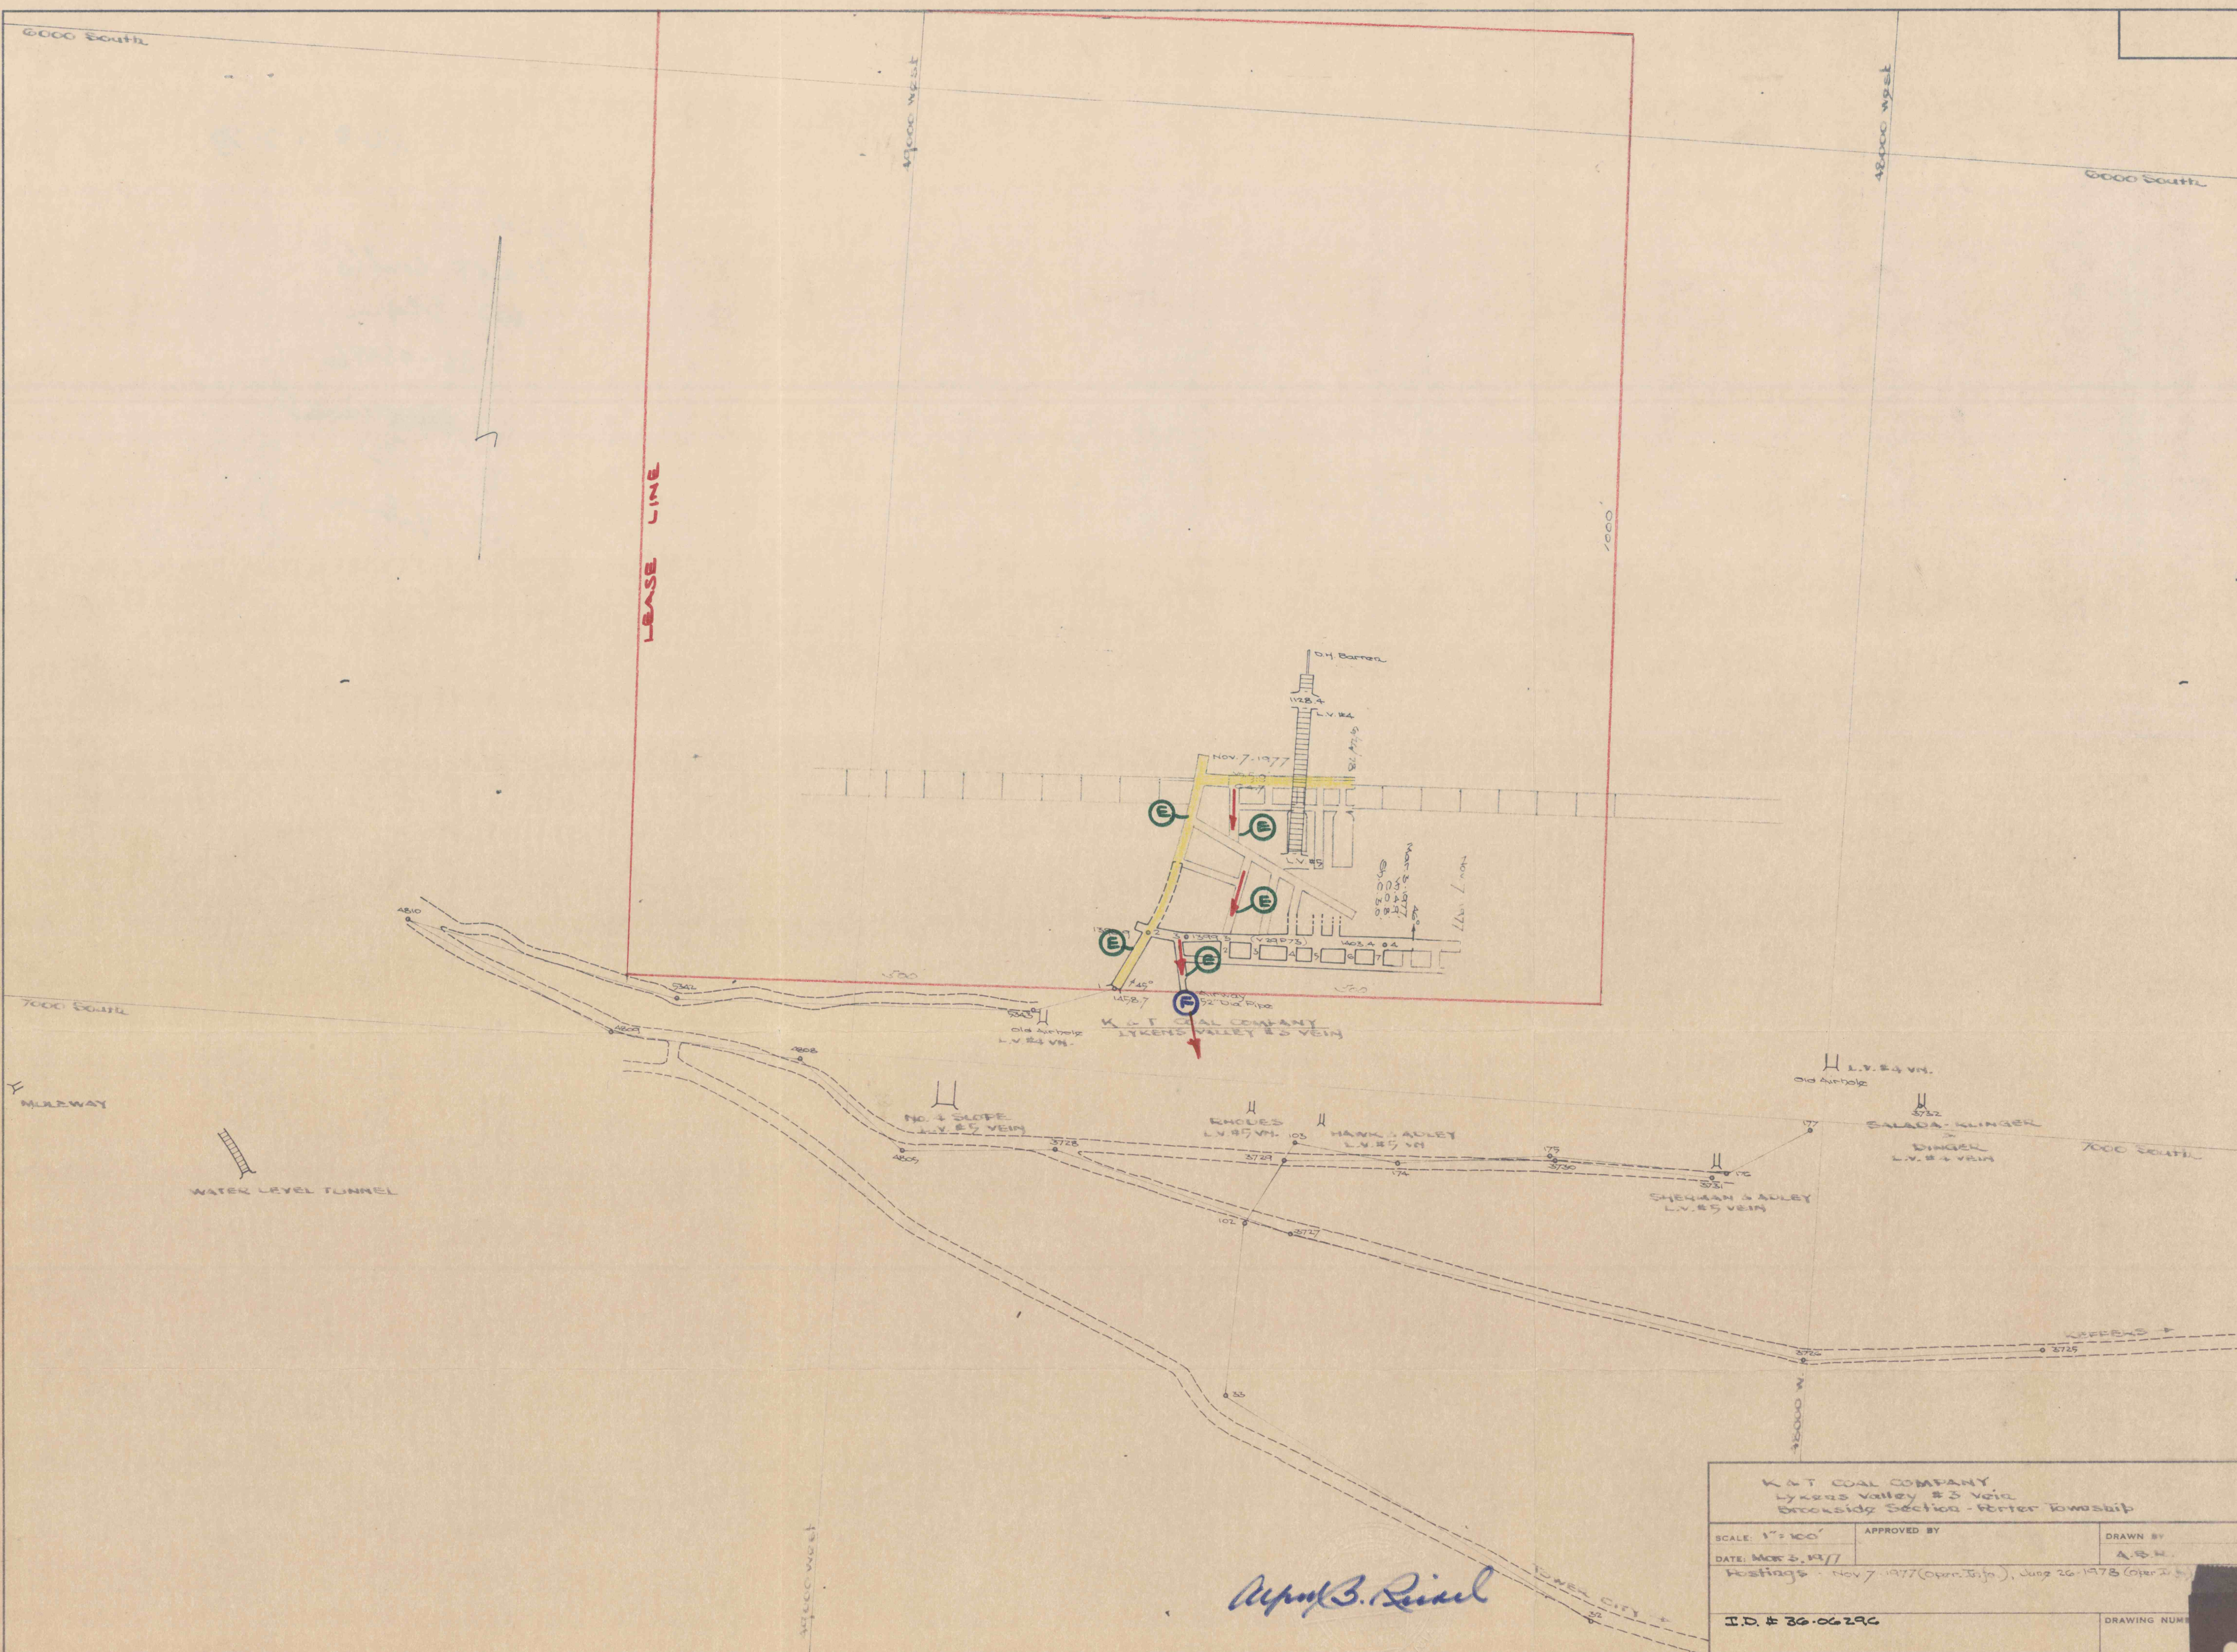

Appl B. Reisel

K & T COAL COMPANY Lykens Valley #3 vein Brookside Section - Porter Township		
SCALE: 1" = 100'	APPROVED BY	DRAWN BY
DATE: Mar 5, 1977		A.B.H.
Hostings - Nov 7, 1977 (Open Life), June 26, 1978 (Open Life)		
I.D. # 36-06296		DRAWING NUMBER