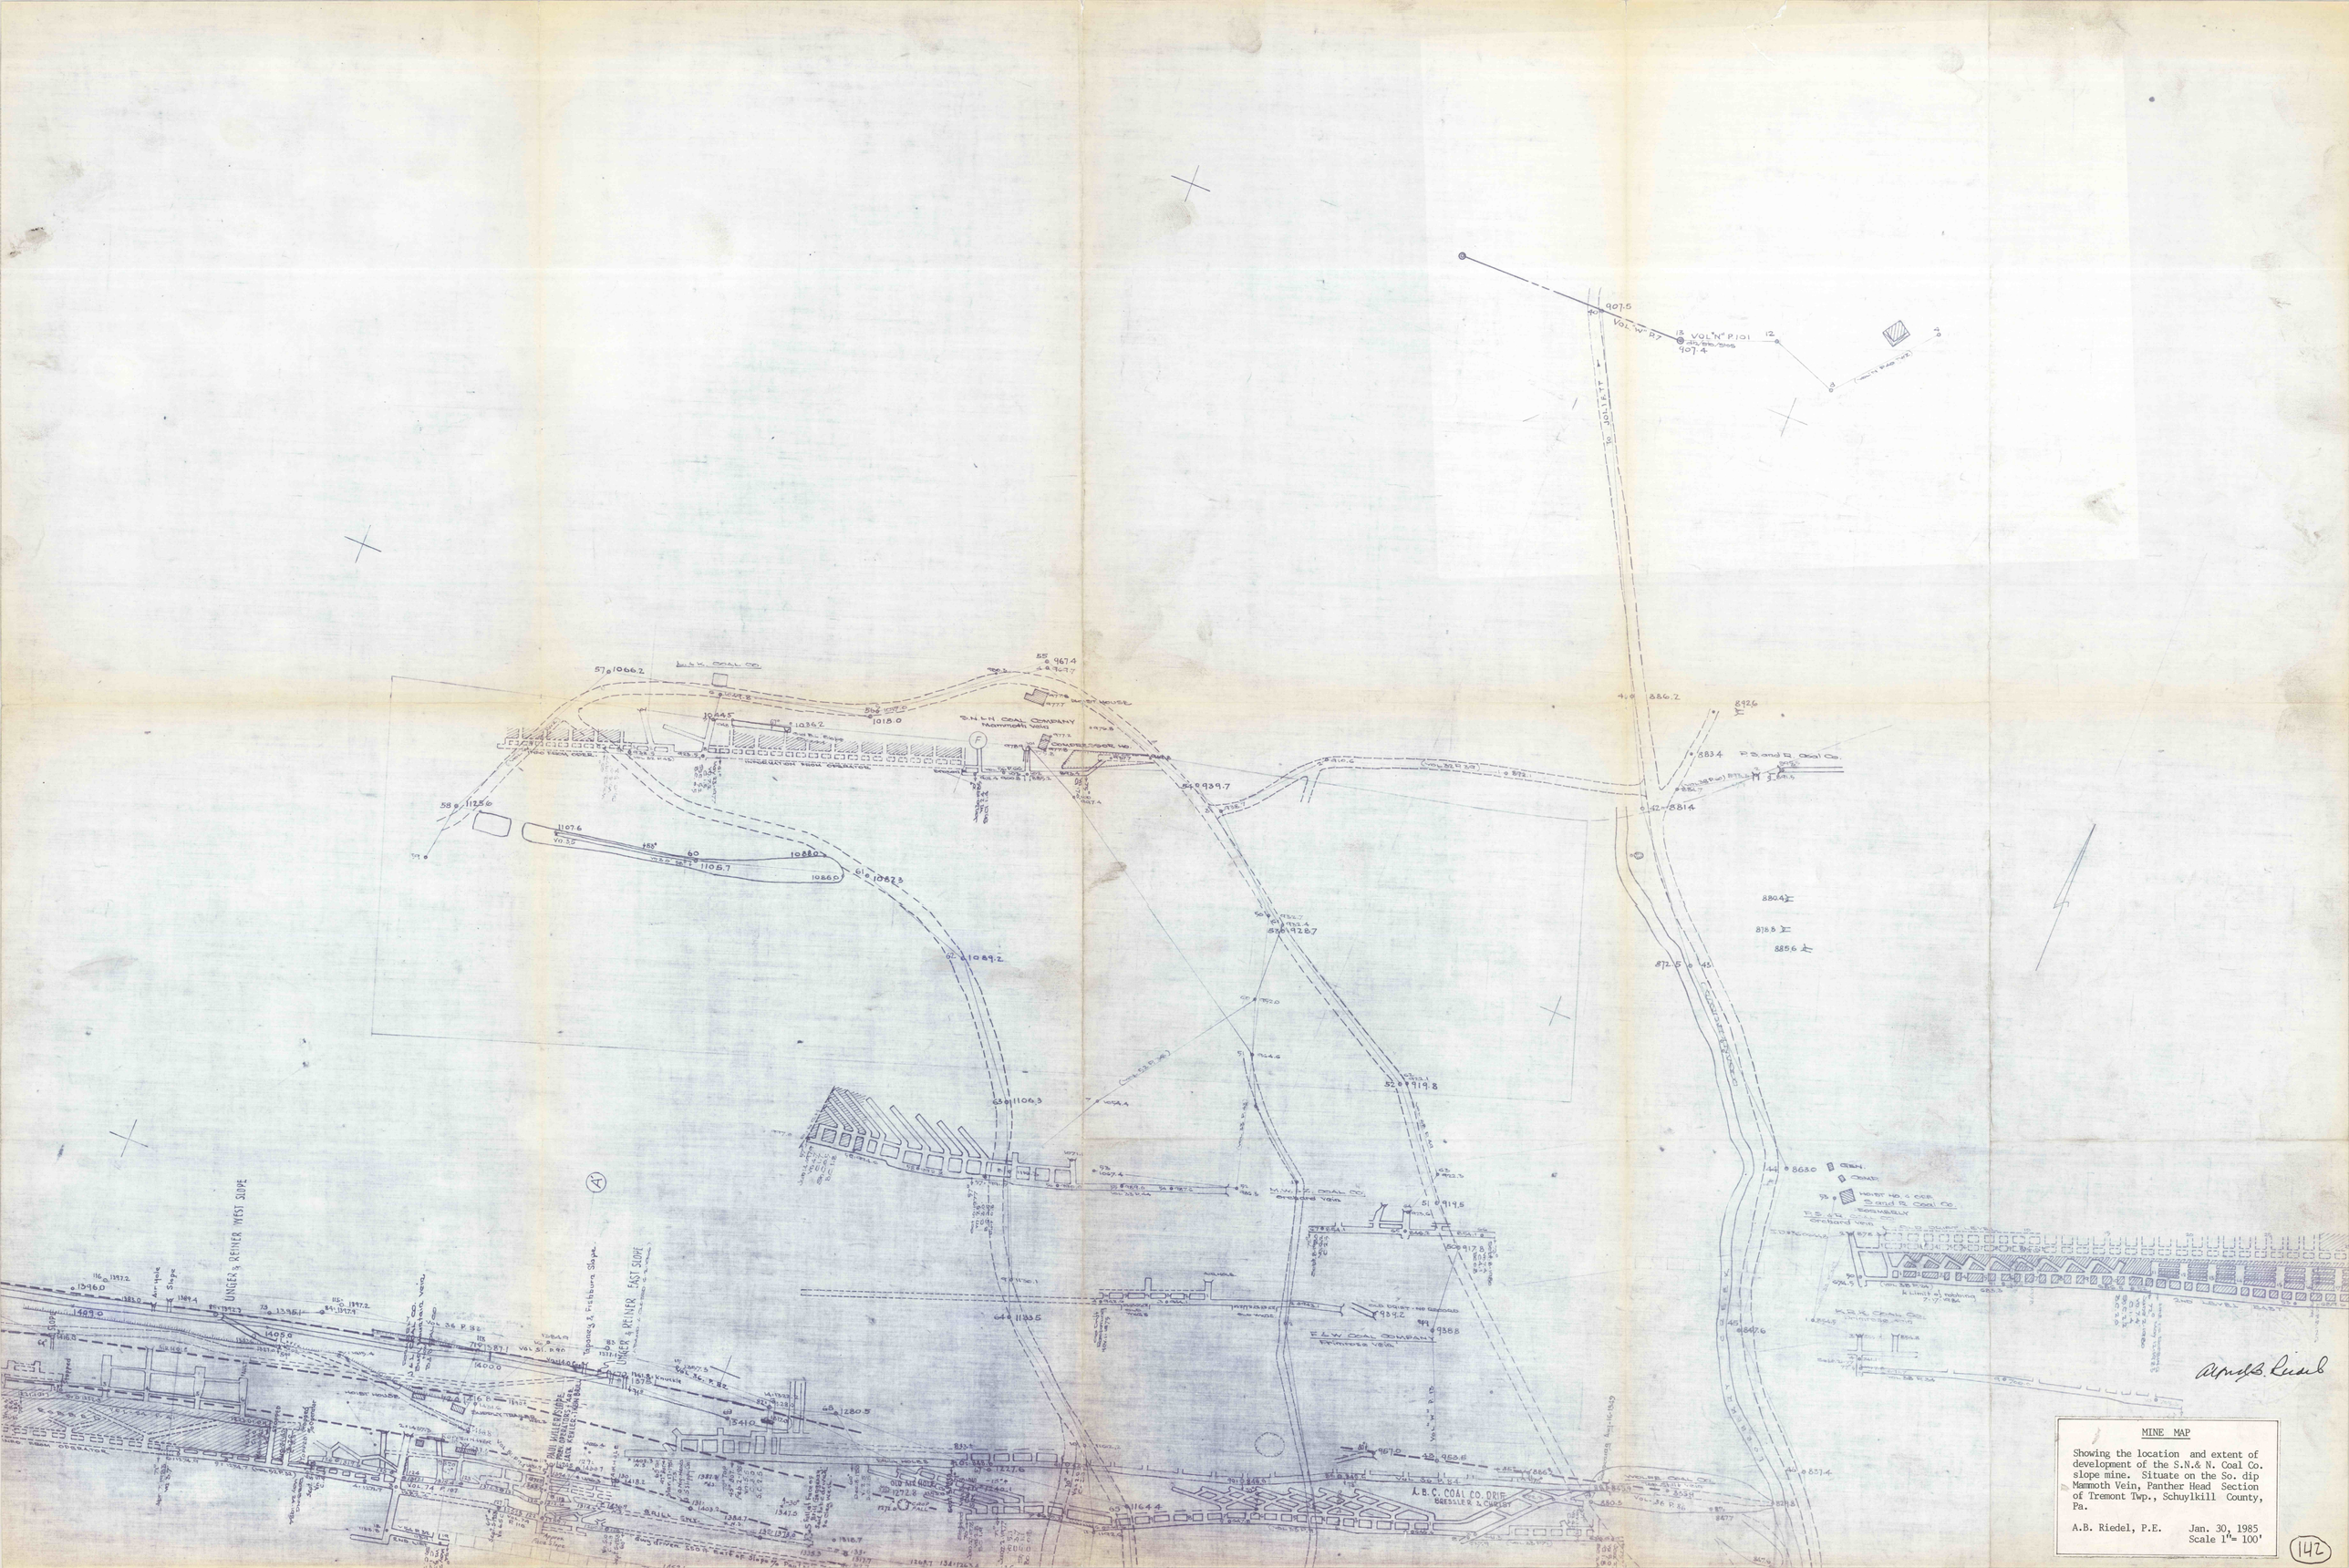

MINE MAP

Showing the location and extent of development of the S.N.& N. Coal Co. slope mine. Situate on the So. dip Mammoth Vein, Panther Head Section of Tremont Twp., Schuylkill County, Pa.

A.B. Riedel, P.E. Jan. 30, 1985
Scale 1"= 100'

142