



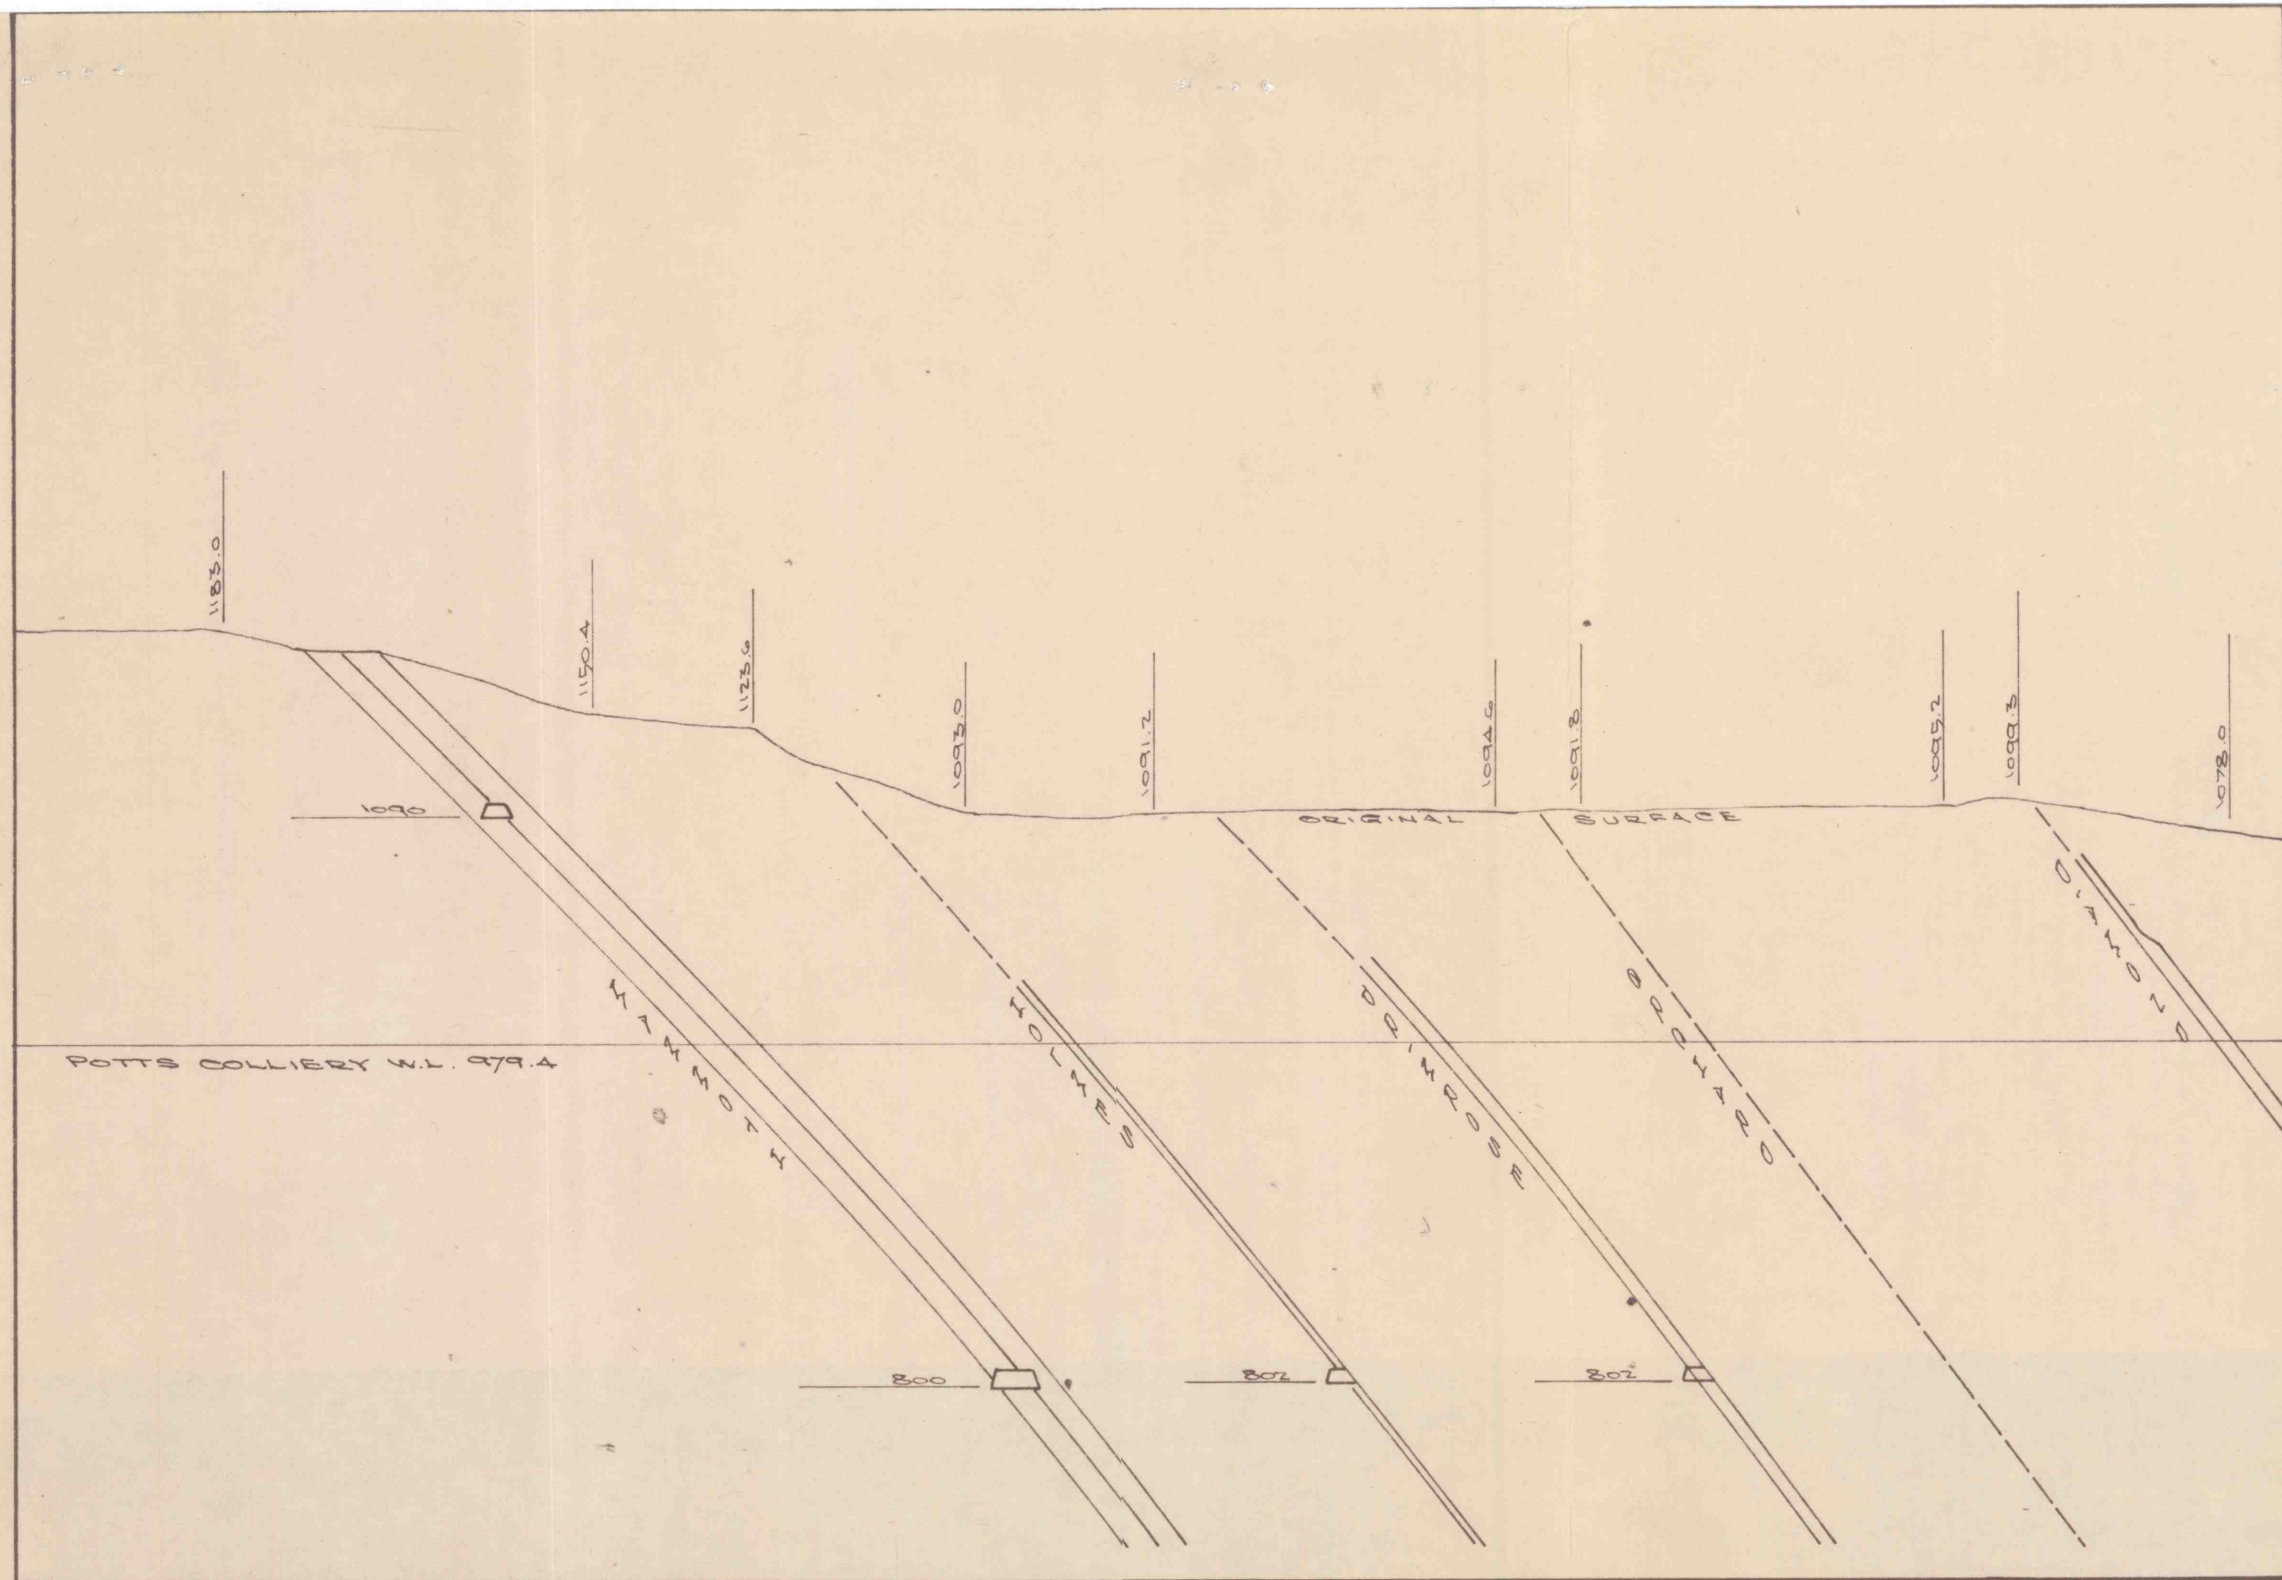

SECTION No 7 DATUM 700 AMT - LOOKING EAST SCALE 1"=100'

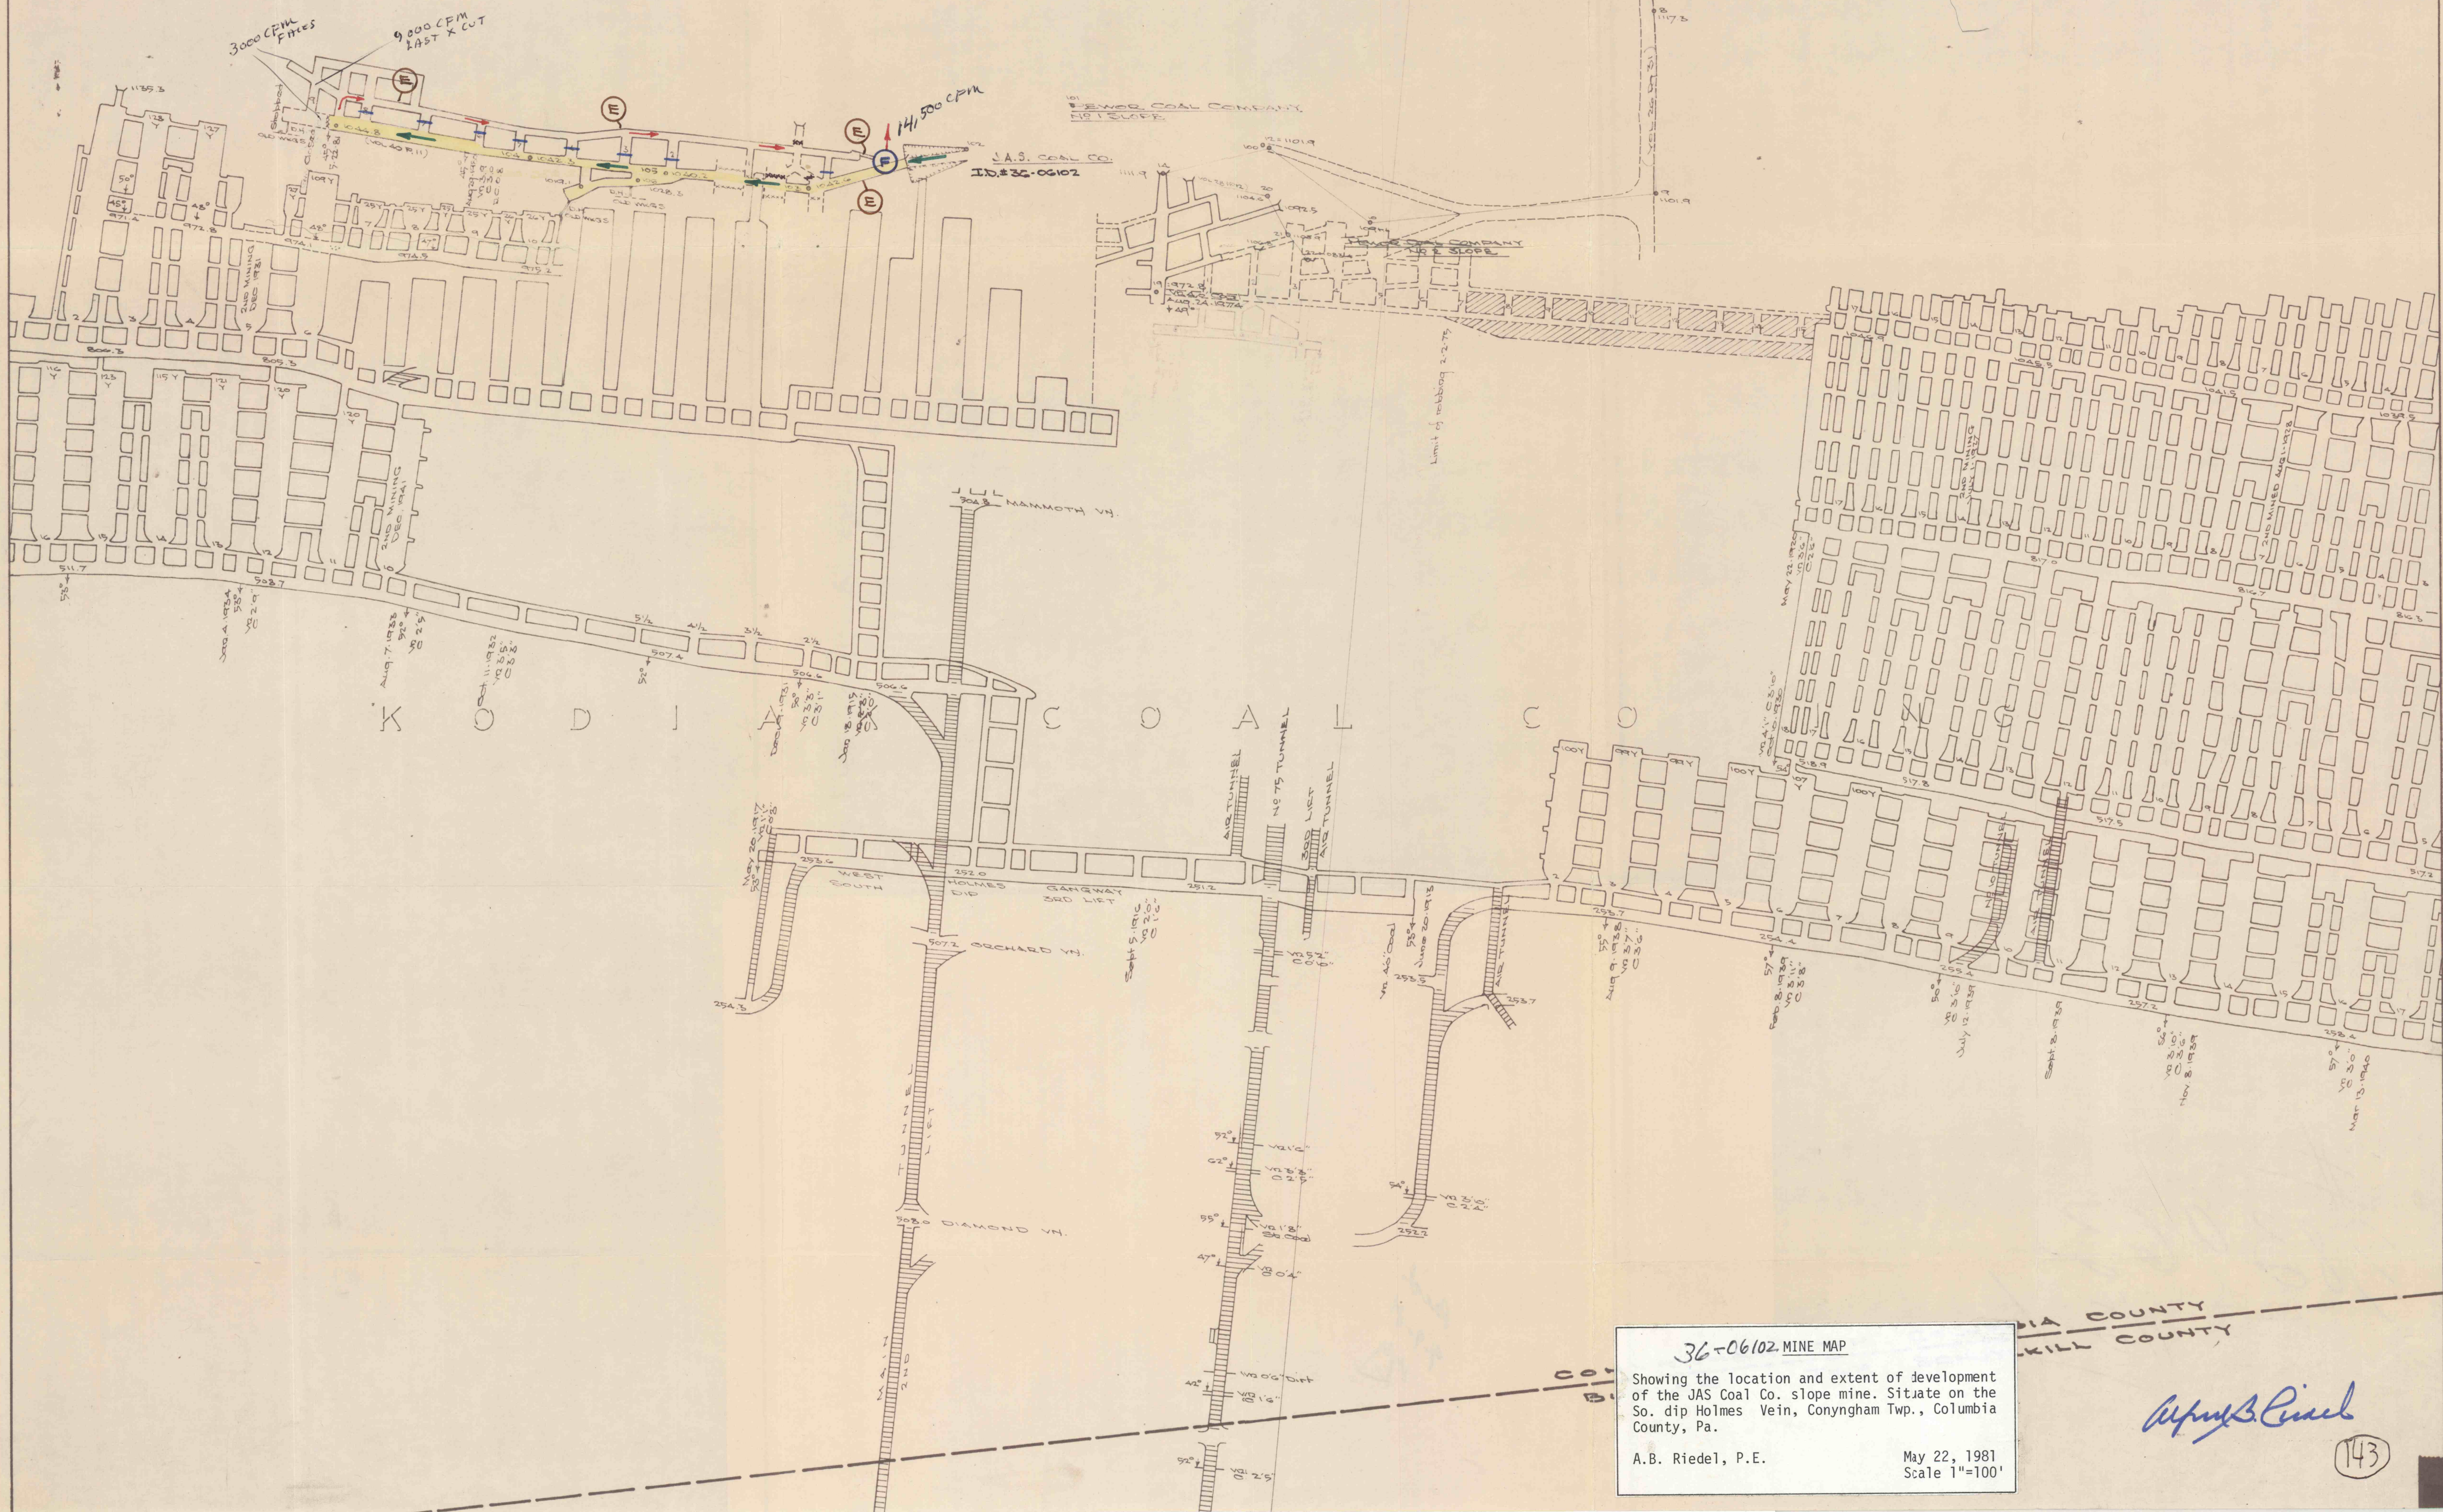

36-06102. MINE MAP
 Showing the location and extent of development
 of the JAS Coal Co. slope mine. Situate on the
 So. dip Holmes Vein, Conyngham Twp., Columbia
 County, Pa.
 A.B. Riedel, P.E. May 22, 1981
 Scale 1"=100'

Alfred B. Riedel