


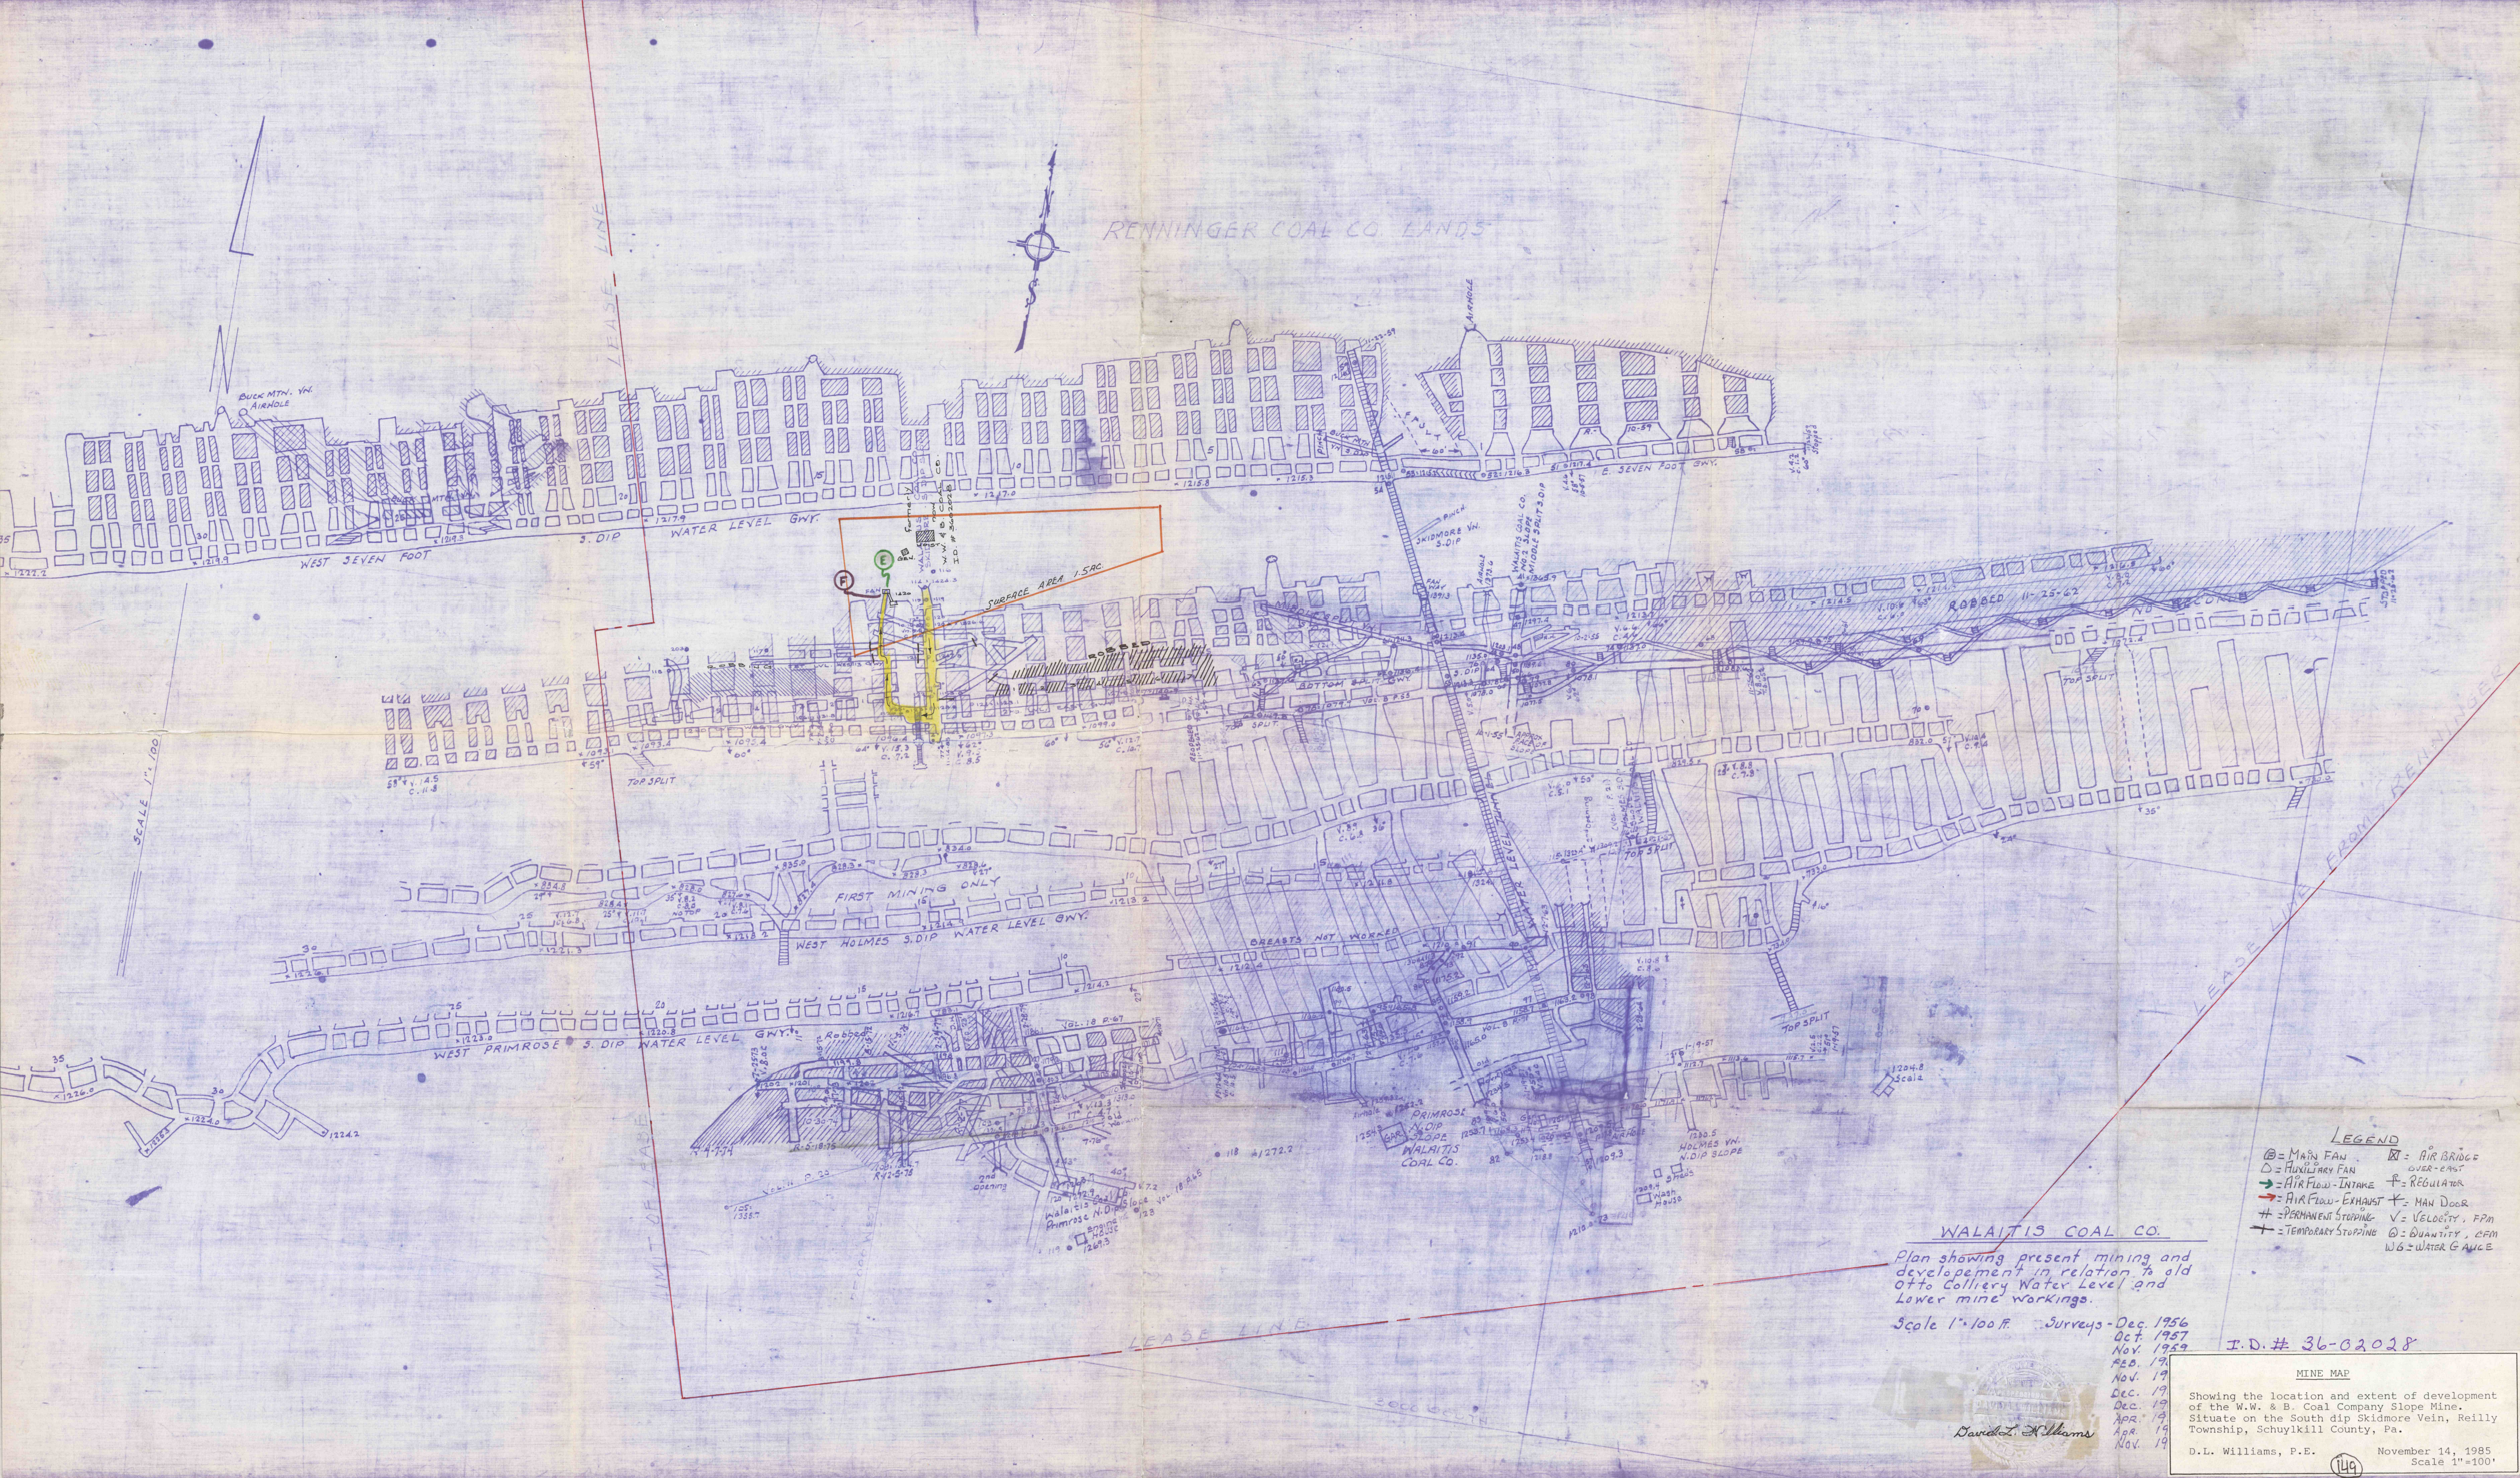

RENNINGER COAL CO. LANDS

SCALE 1" = 100'

- LEGEND**
- ⊙ = MAIN FAN
 - ⊙ = AUXILIARY FAN
 - = AIR FLOW - INTAKE
 - = AIR FLOW - EXHAUST
 - ⊕ = PERMANENT STOPPING
 - ⊕ = TEMPORARY STOPPING
 - ⊕ = AIR BRIDGE OVER-EAST
 - ⊕ = REGULATOR
 - ⊕ = MAN DOOR
 - V = VELOCITY, FPM
 - Q = QUANTITY, CFM
 - W.G. = WATER G. ANGE

WALAITIS COAL CO.

Plan showing present mining and development in relation to old Otto Colliery Water Level and Lower mine workings.

Scale 1" = 100' Surveys - Dec. 1956

- Oct. 1957
- Nov. 1959
- FEB. 1961
- Nov. 1961
- Dec. 1961
- Dec. 1961
- Apr. 1962
- Nov. 1962

I.D.# 36-02028

MINE MAP

Showing the location and extent of development of the W.W. & B. Coal Company Slope Mine. Situate on the South dip Skidmore Vein, Reilly Township, Schuylkill County, Pa.

D.L. Williams, P.E.

November 14, 1985 Scale 1" = 100'