


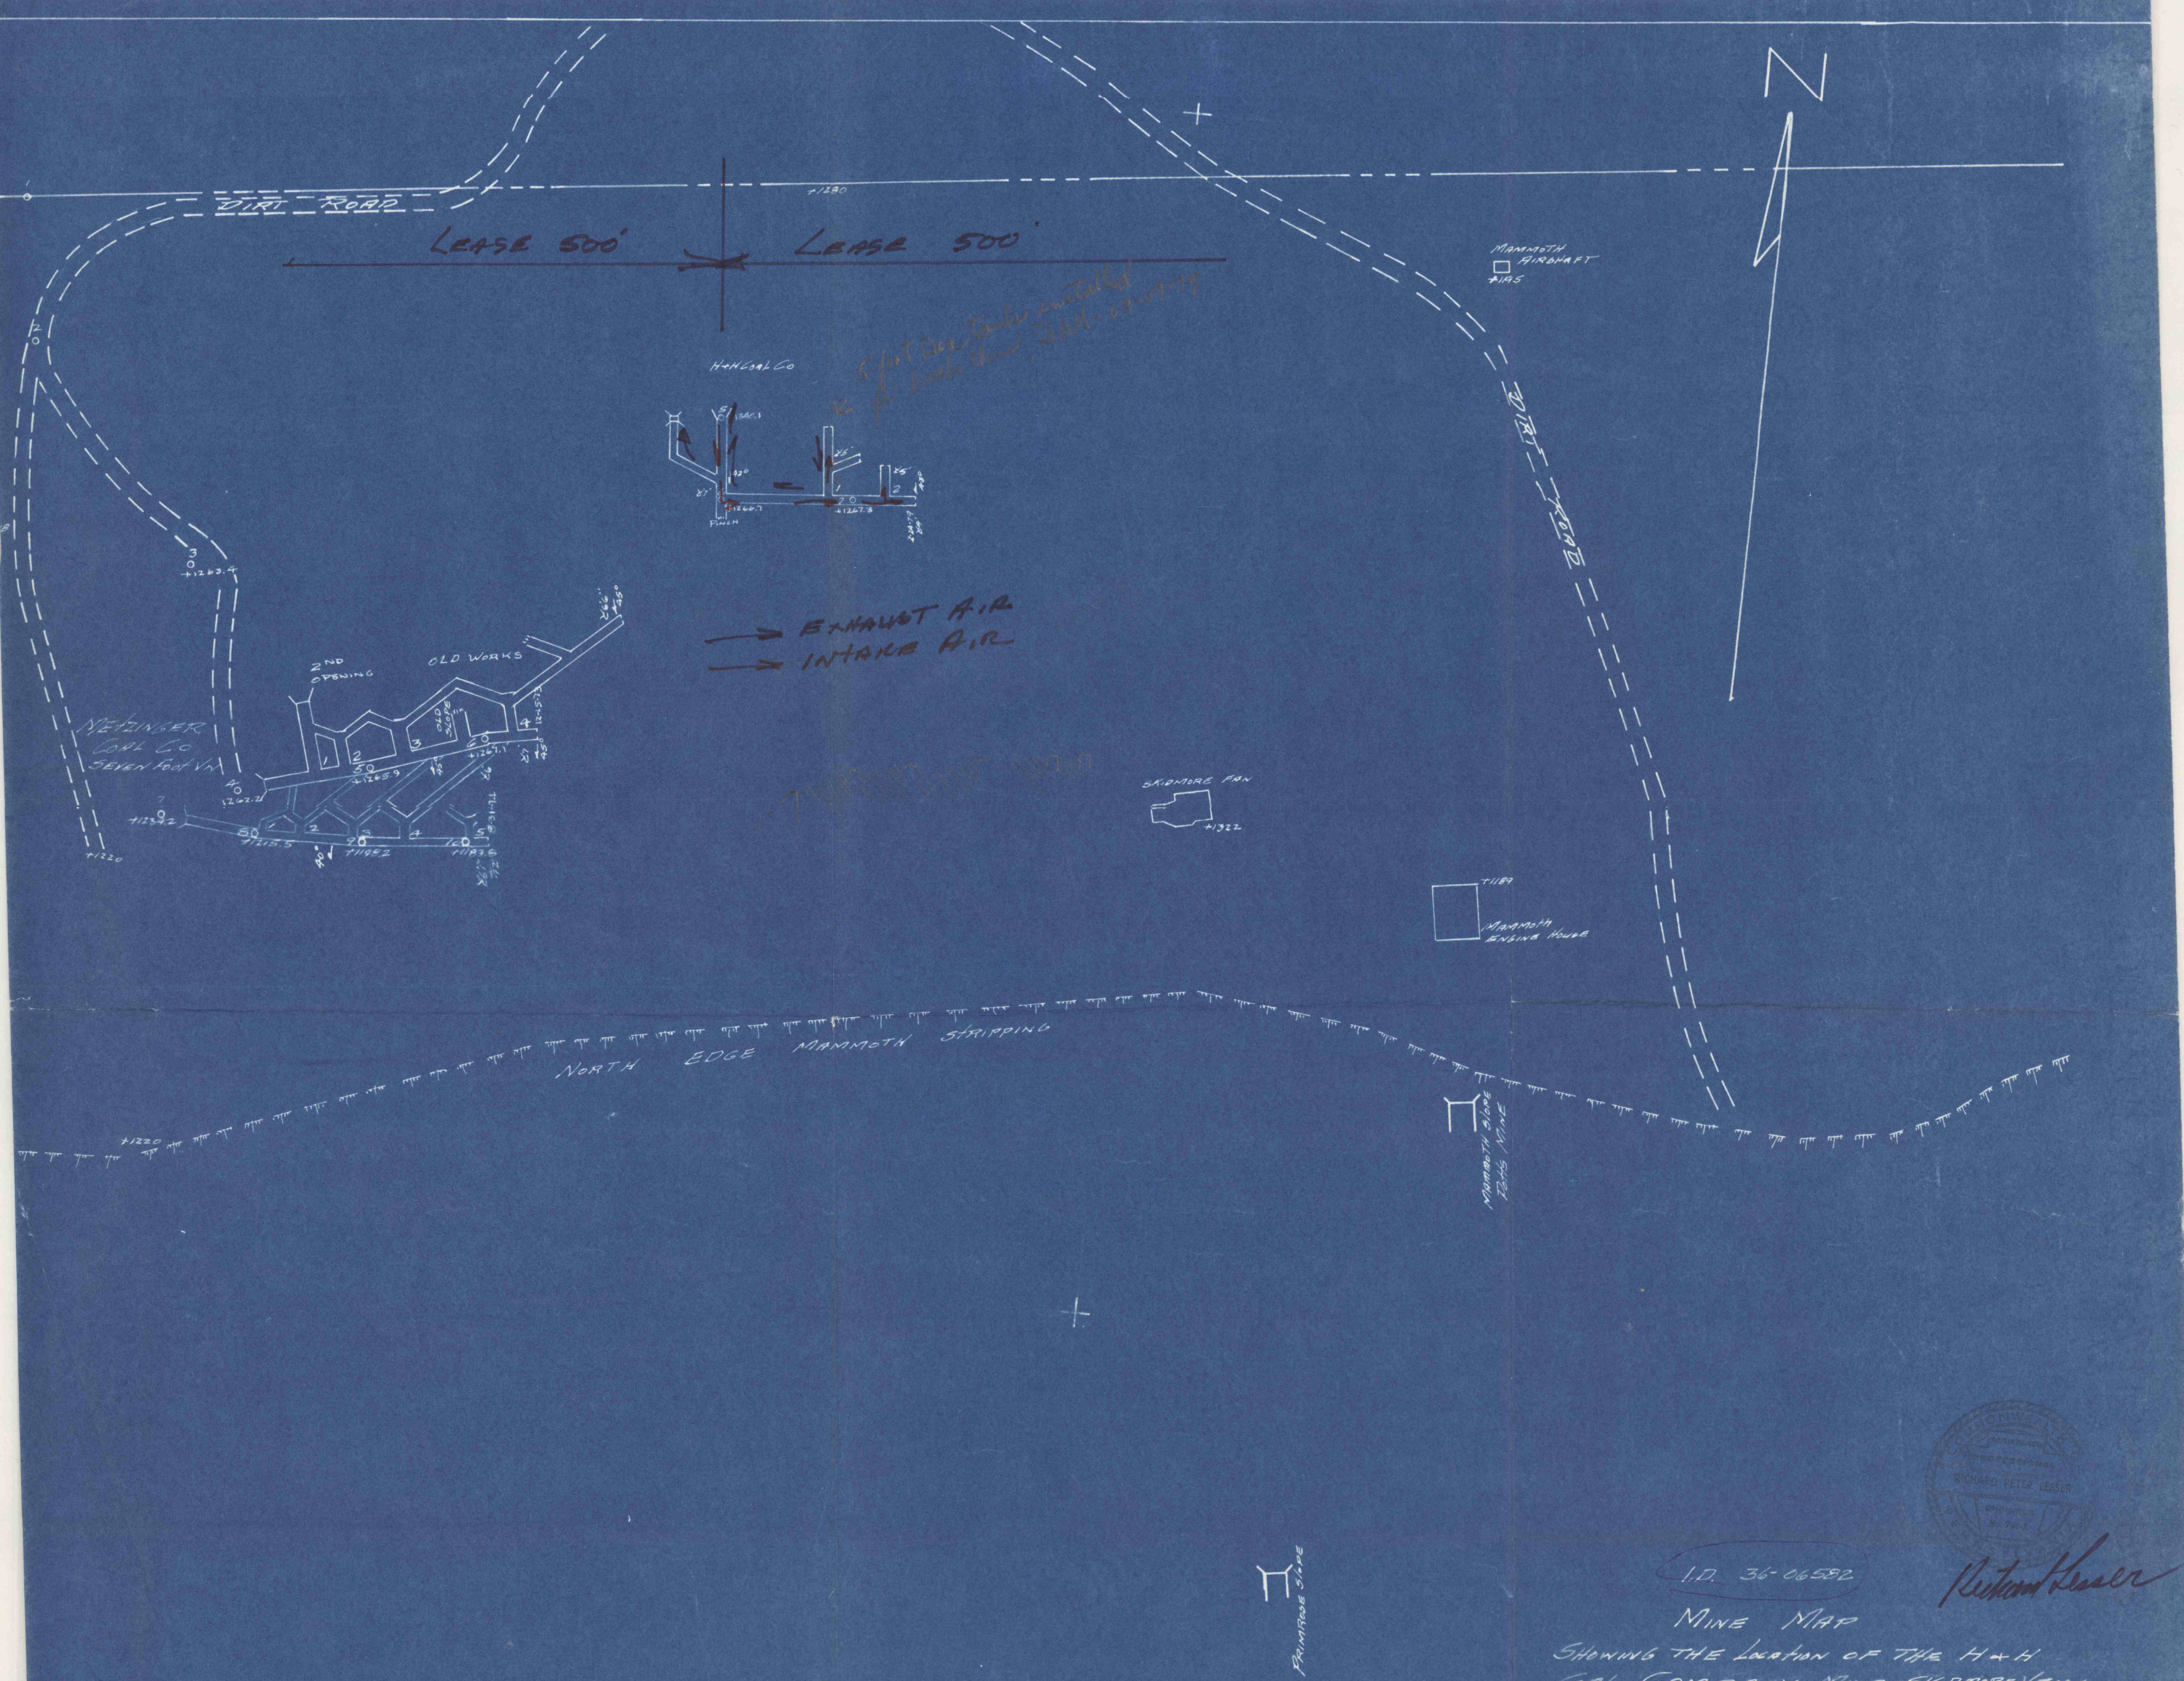


I.D. 36-06582

MINE MAP

SHOWING THE LOCATION OF THE H+H
COAL COMPANY MINE SHEDMORE VENT
ABANDONED POTTS MINE
CONYNGHAM TOWNSHIP, COLUMBIA CO, PENNA.

1"=100'

2-24-79

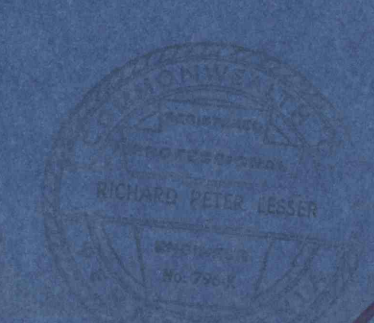

Richard Jesser