


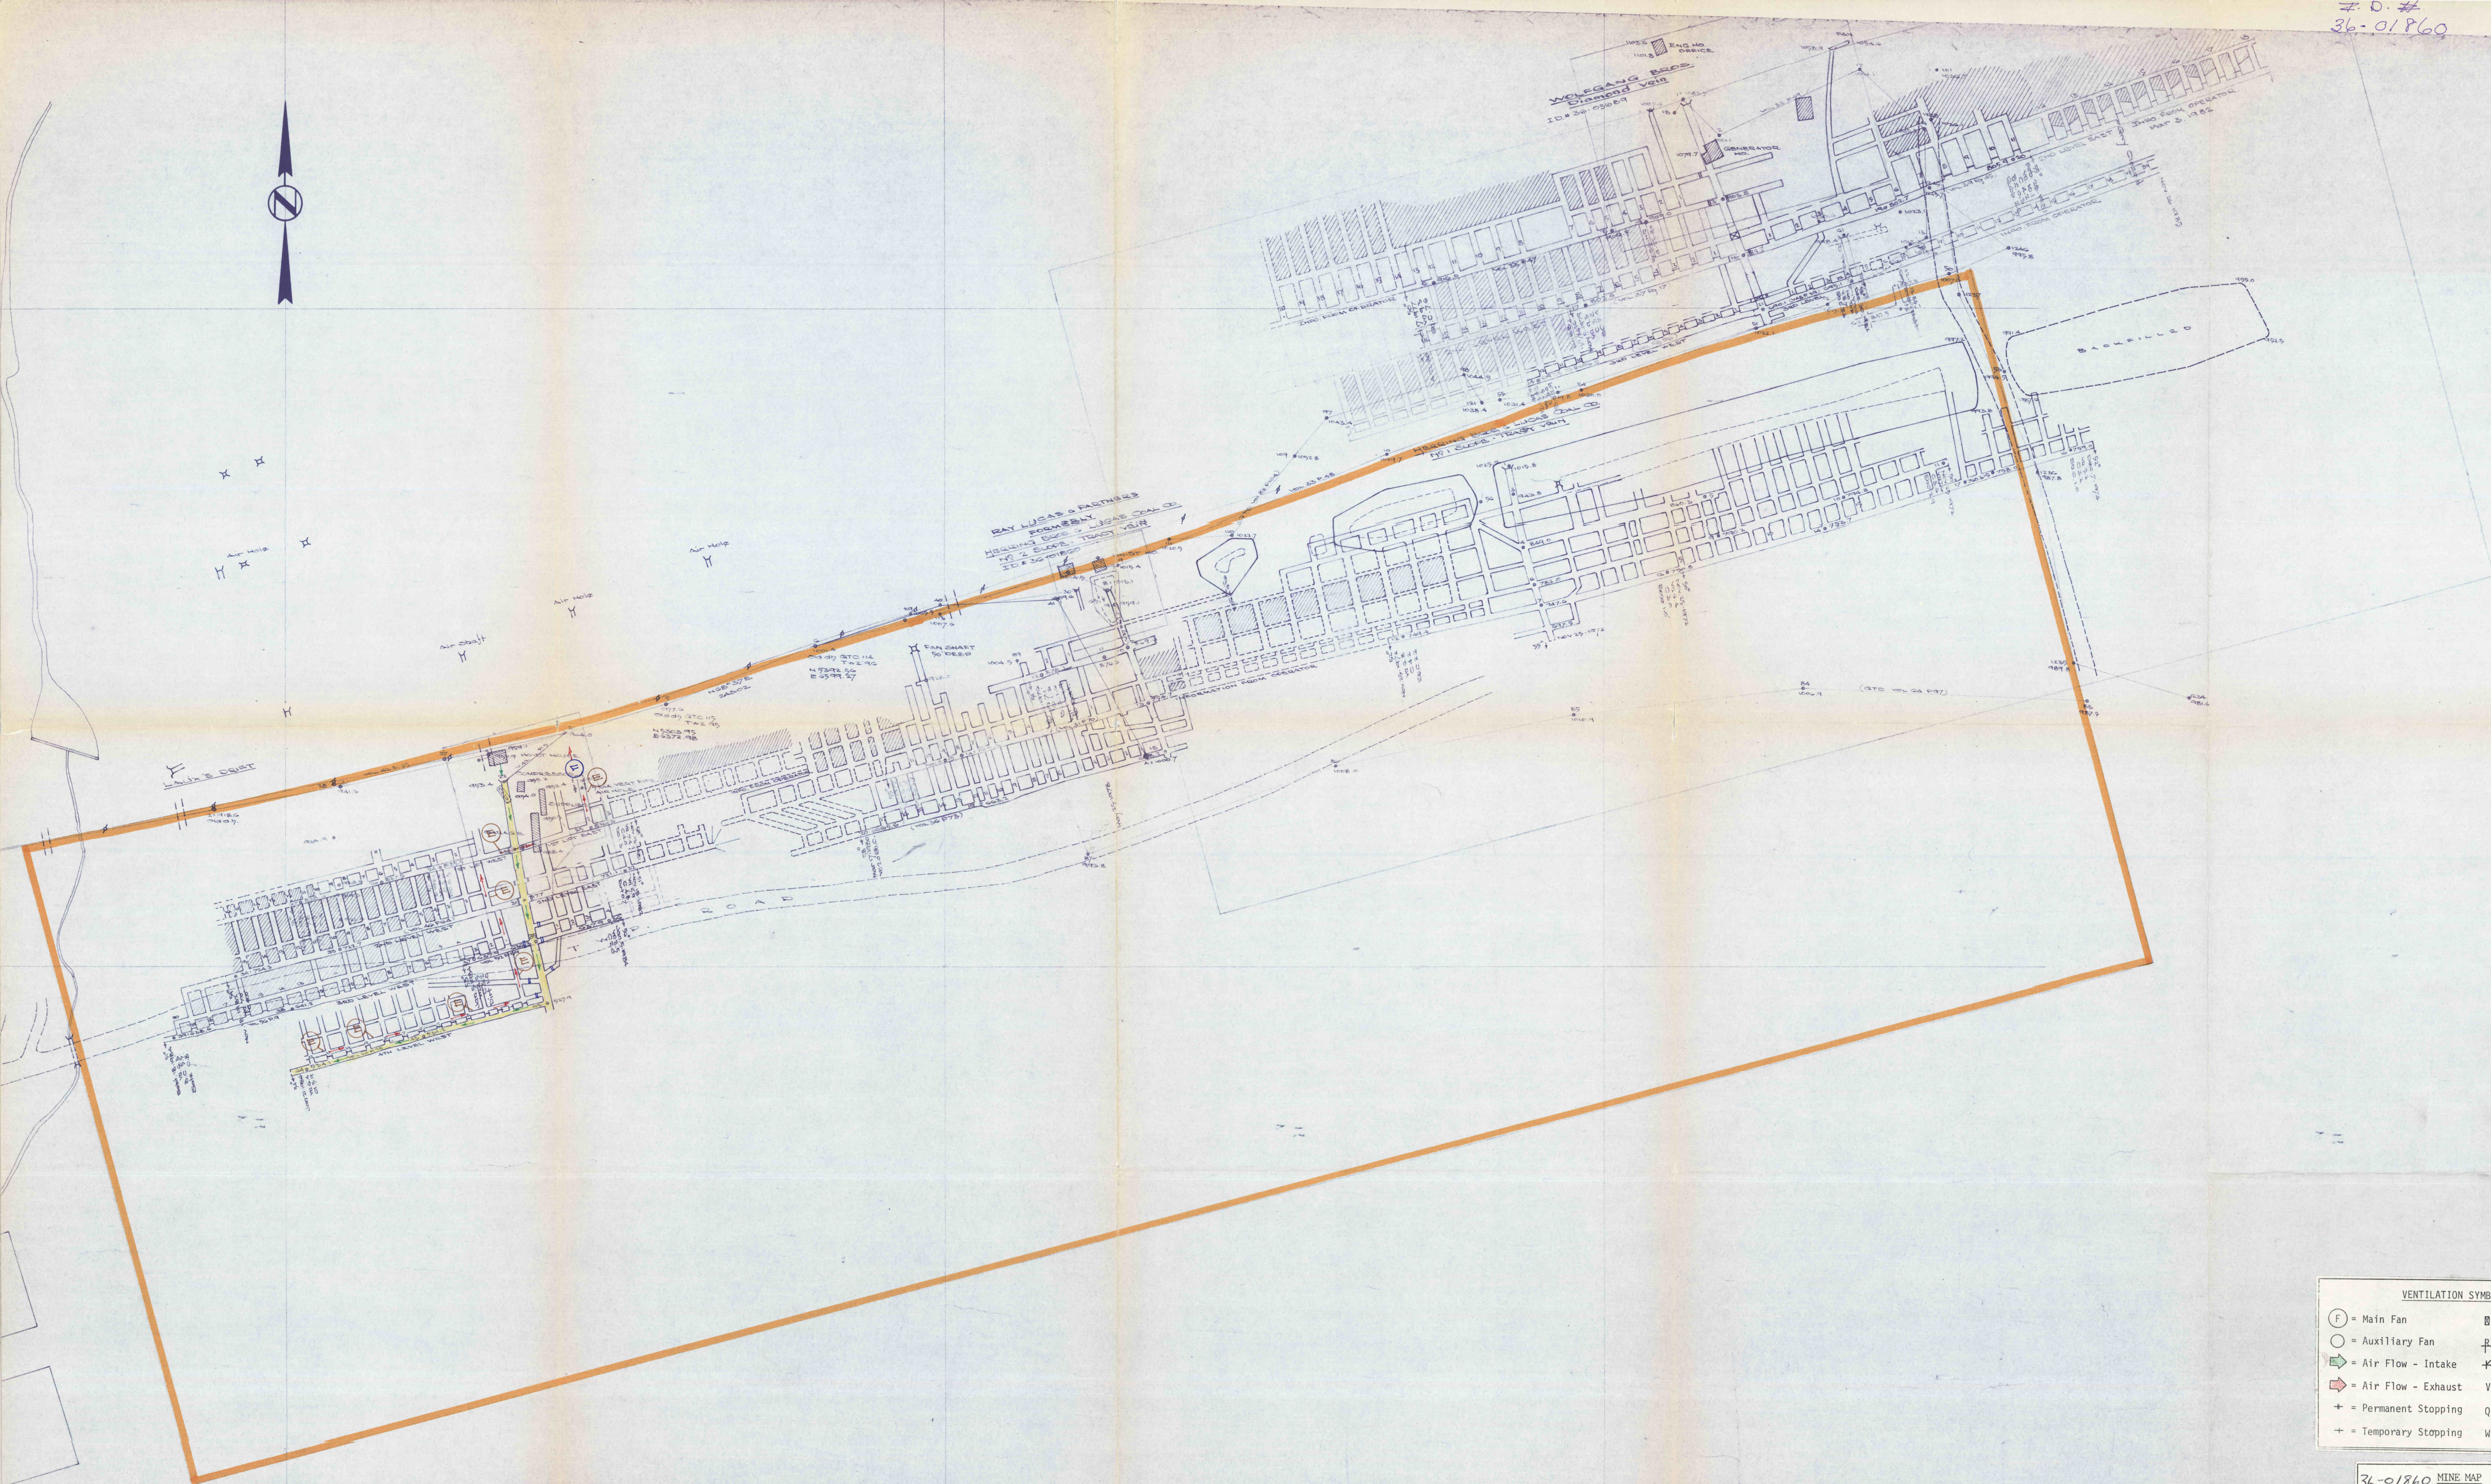

VENTILATION SYMBOLS			
(F) = Main Fan	[Symbol] = Air Bridge	[Symbol] = Regulator	
(A) = Auxiliary Fan	[Symbol] = Man Door	V = Velocity, fpm	
[Symbol] = Air Flow - Intake	Q = Quantity, cfm	WG = Water Gauge	
[Symbol] = Air Flow - Exhaust			
+ = Permanent Stopping			
+ = Temporary Stopping			

36-01860 MINE MAP
Showing the location and extent of development of the Lucas and Partners Coal Company slope mine. Situate on the So. dip Tracy Vein, Frailey Twp., Schuylkill County, Pa.
A.B. Riedel, P.E. Jan. 21, 1986
Scale 1"= 100'

April 3, 1986