
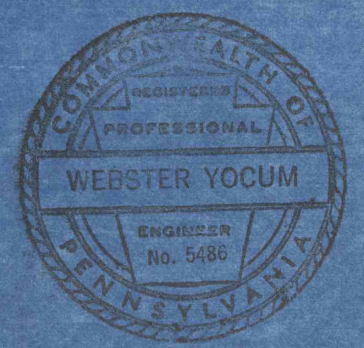


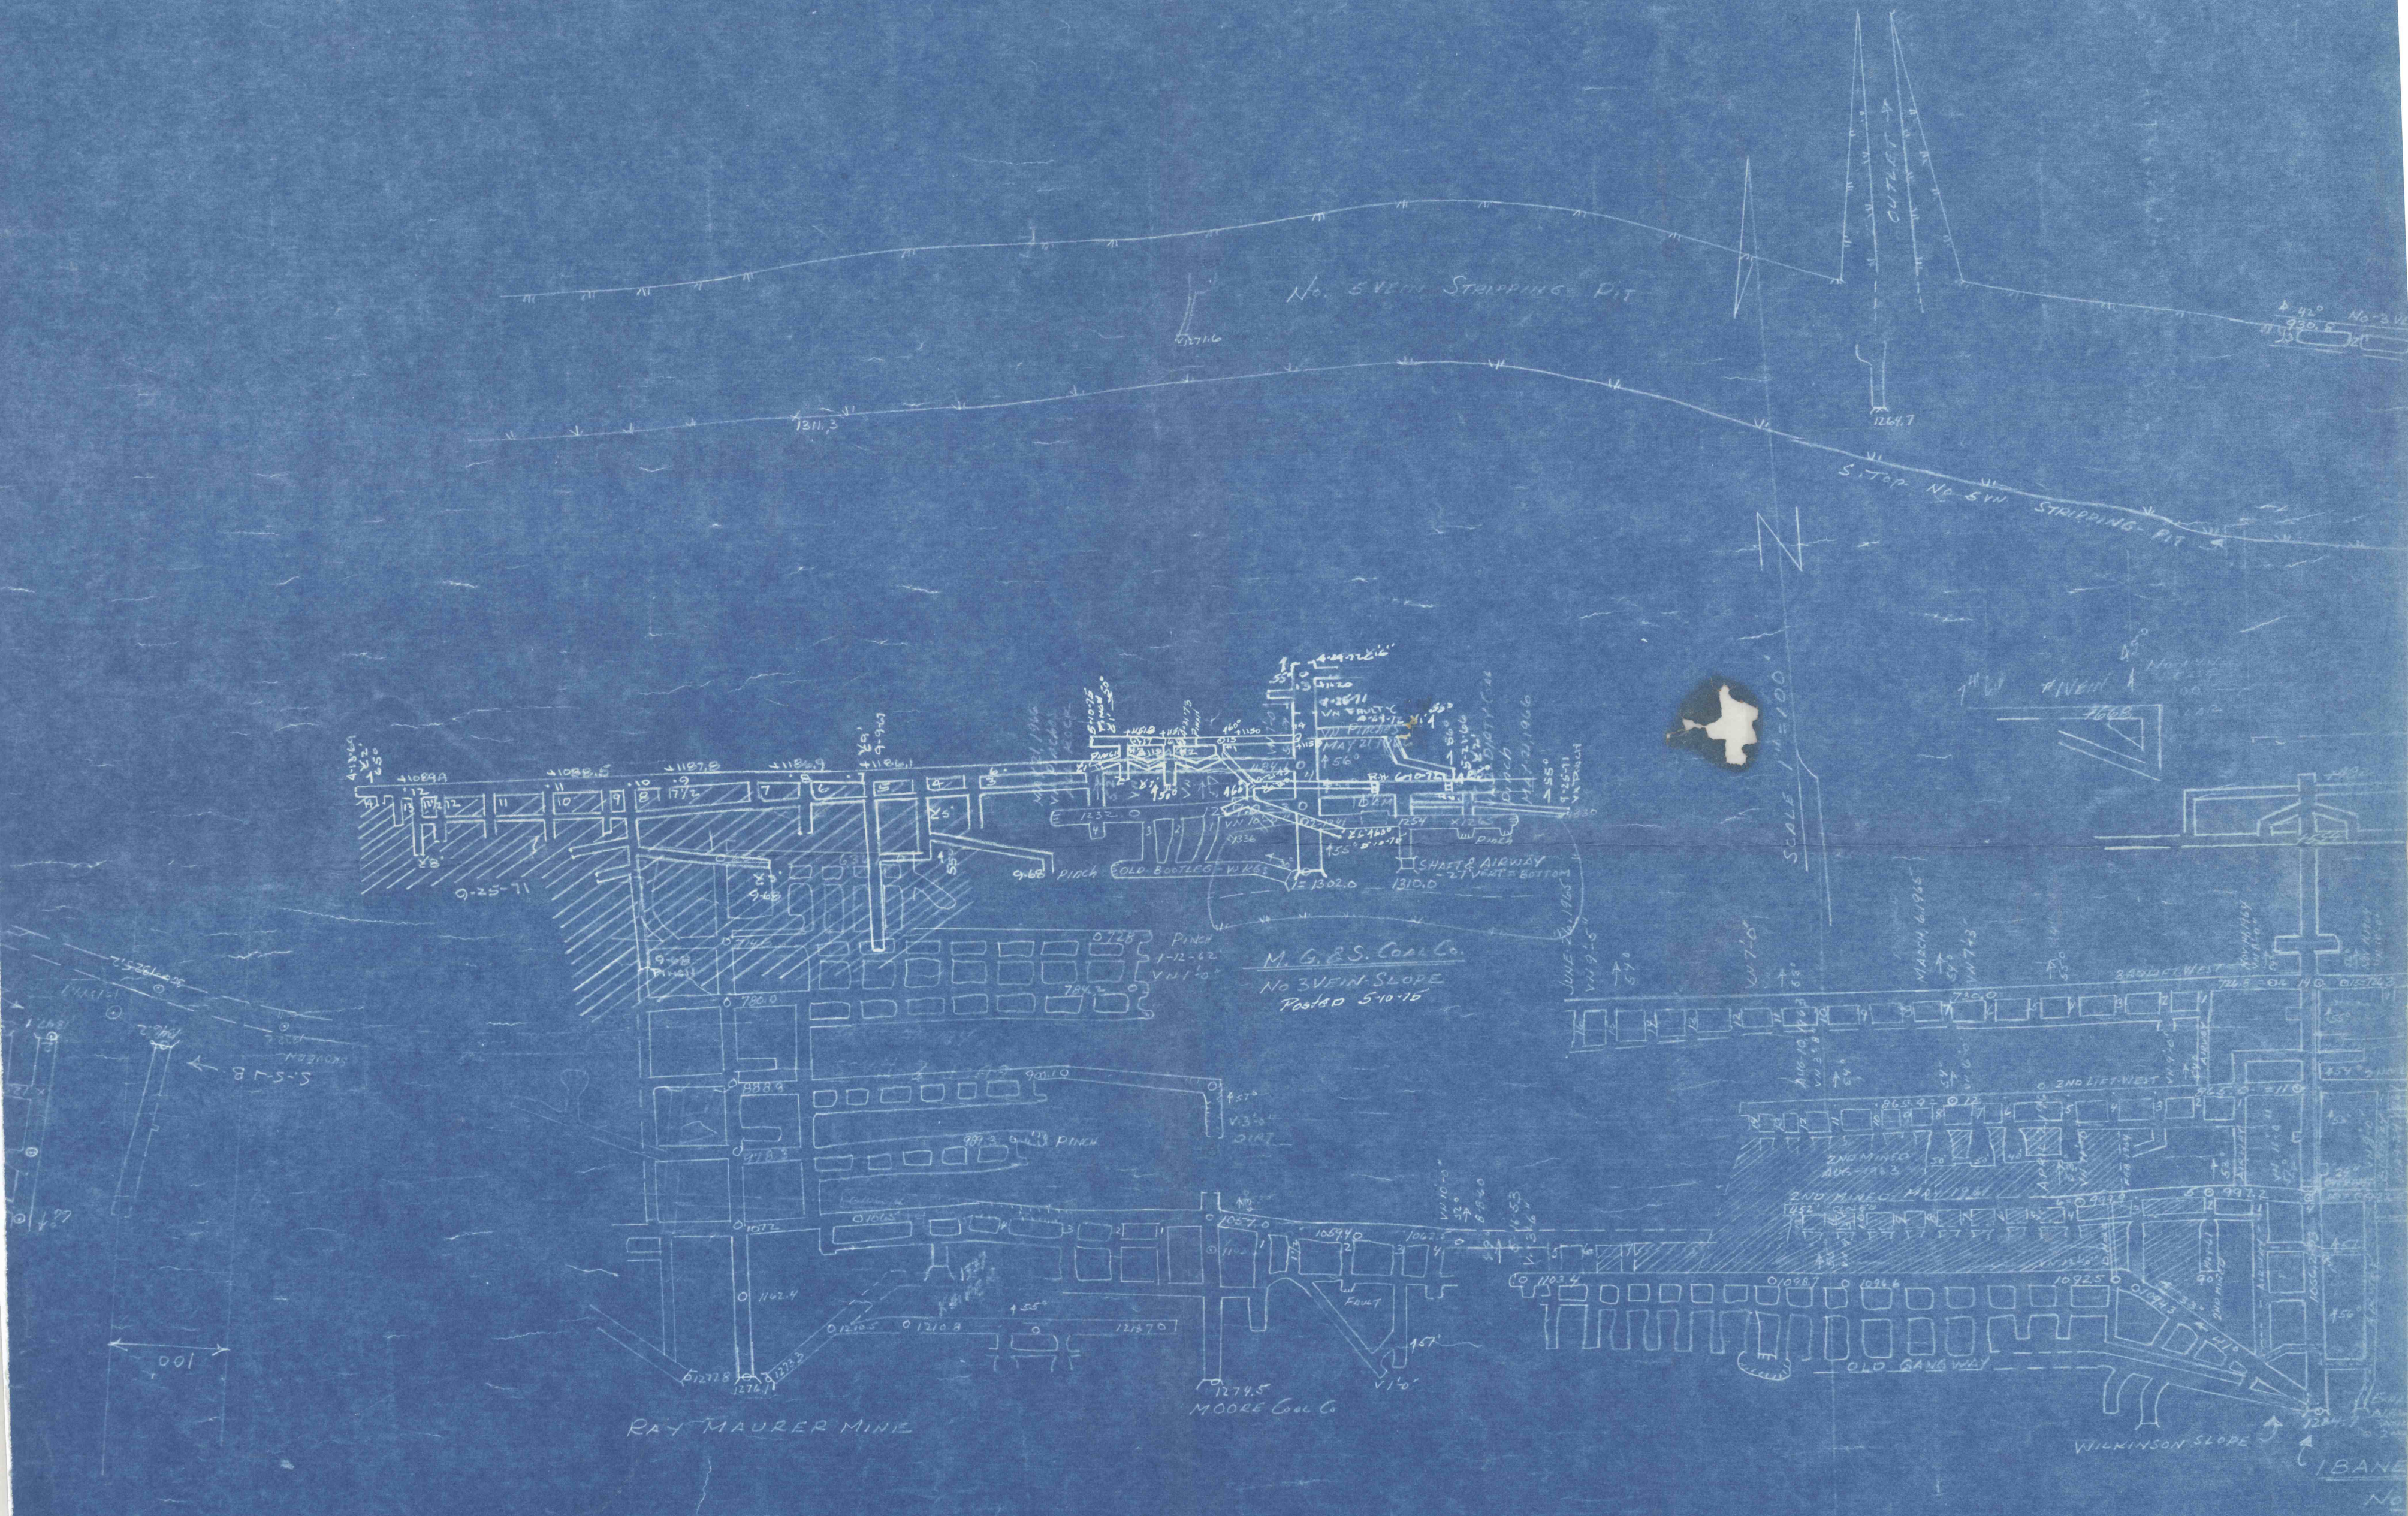

W. M. MERRITT 163