


No. 7 Mine
 PINE LINE COAL COMPANY
 SHAMOKIN, NORTH CO. PA.
 ID 36-02213

NOLAWICK WORKINGS
 NO 9 1/2 VEIN

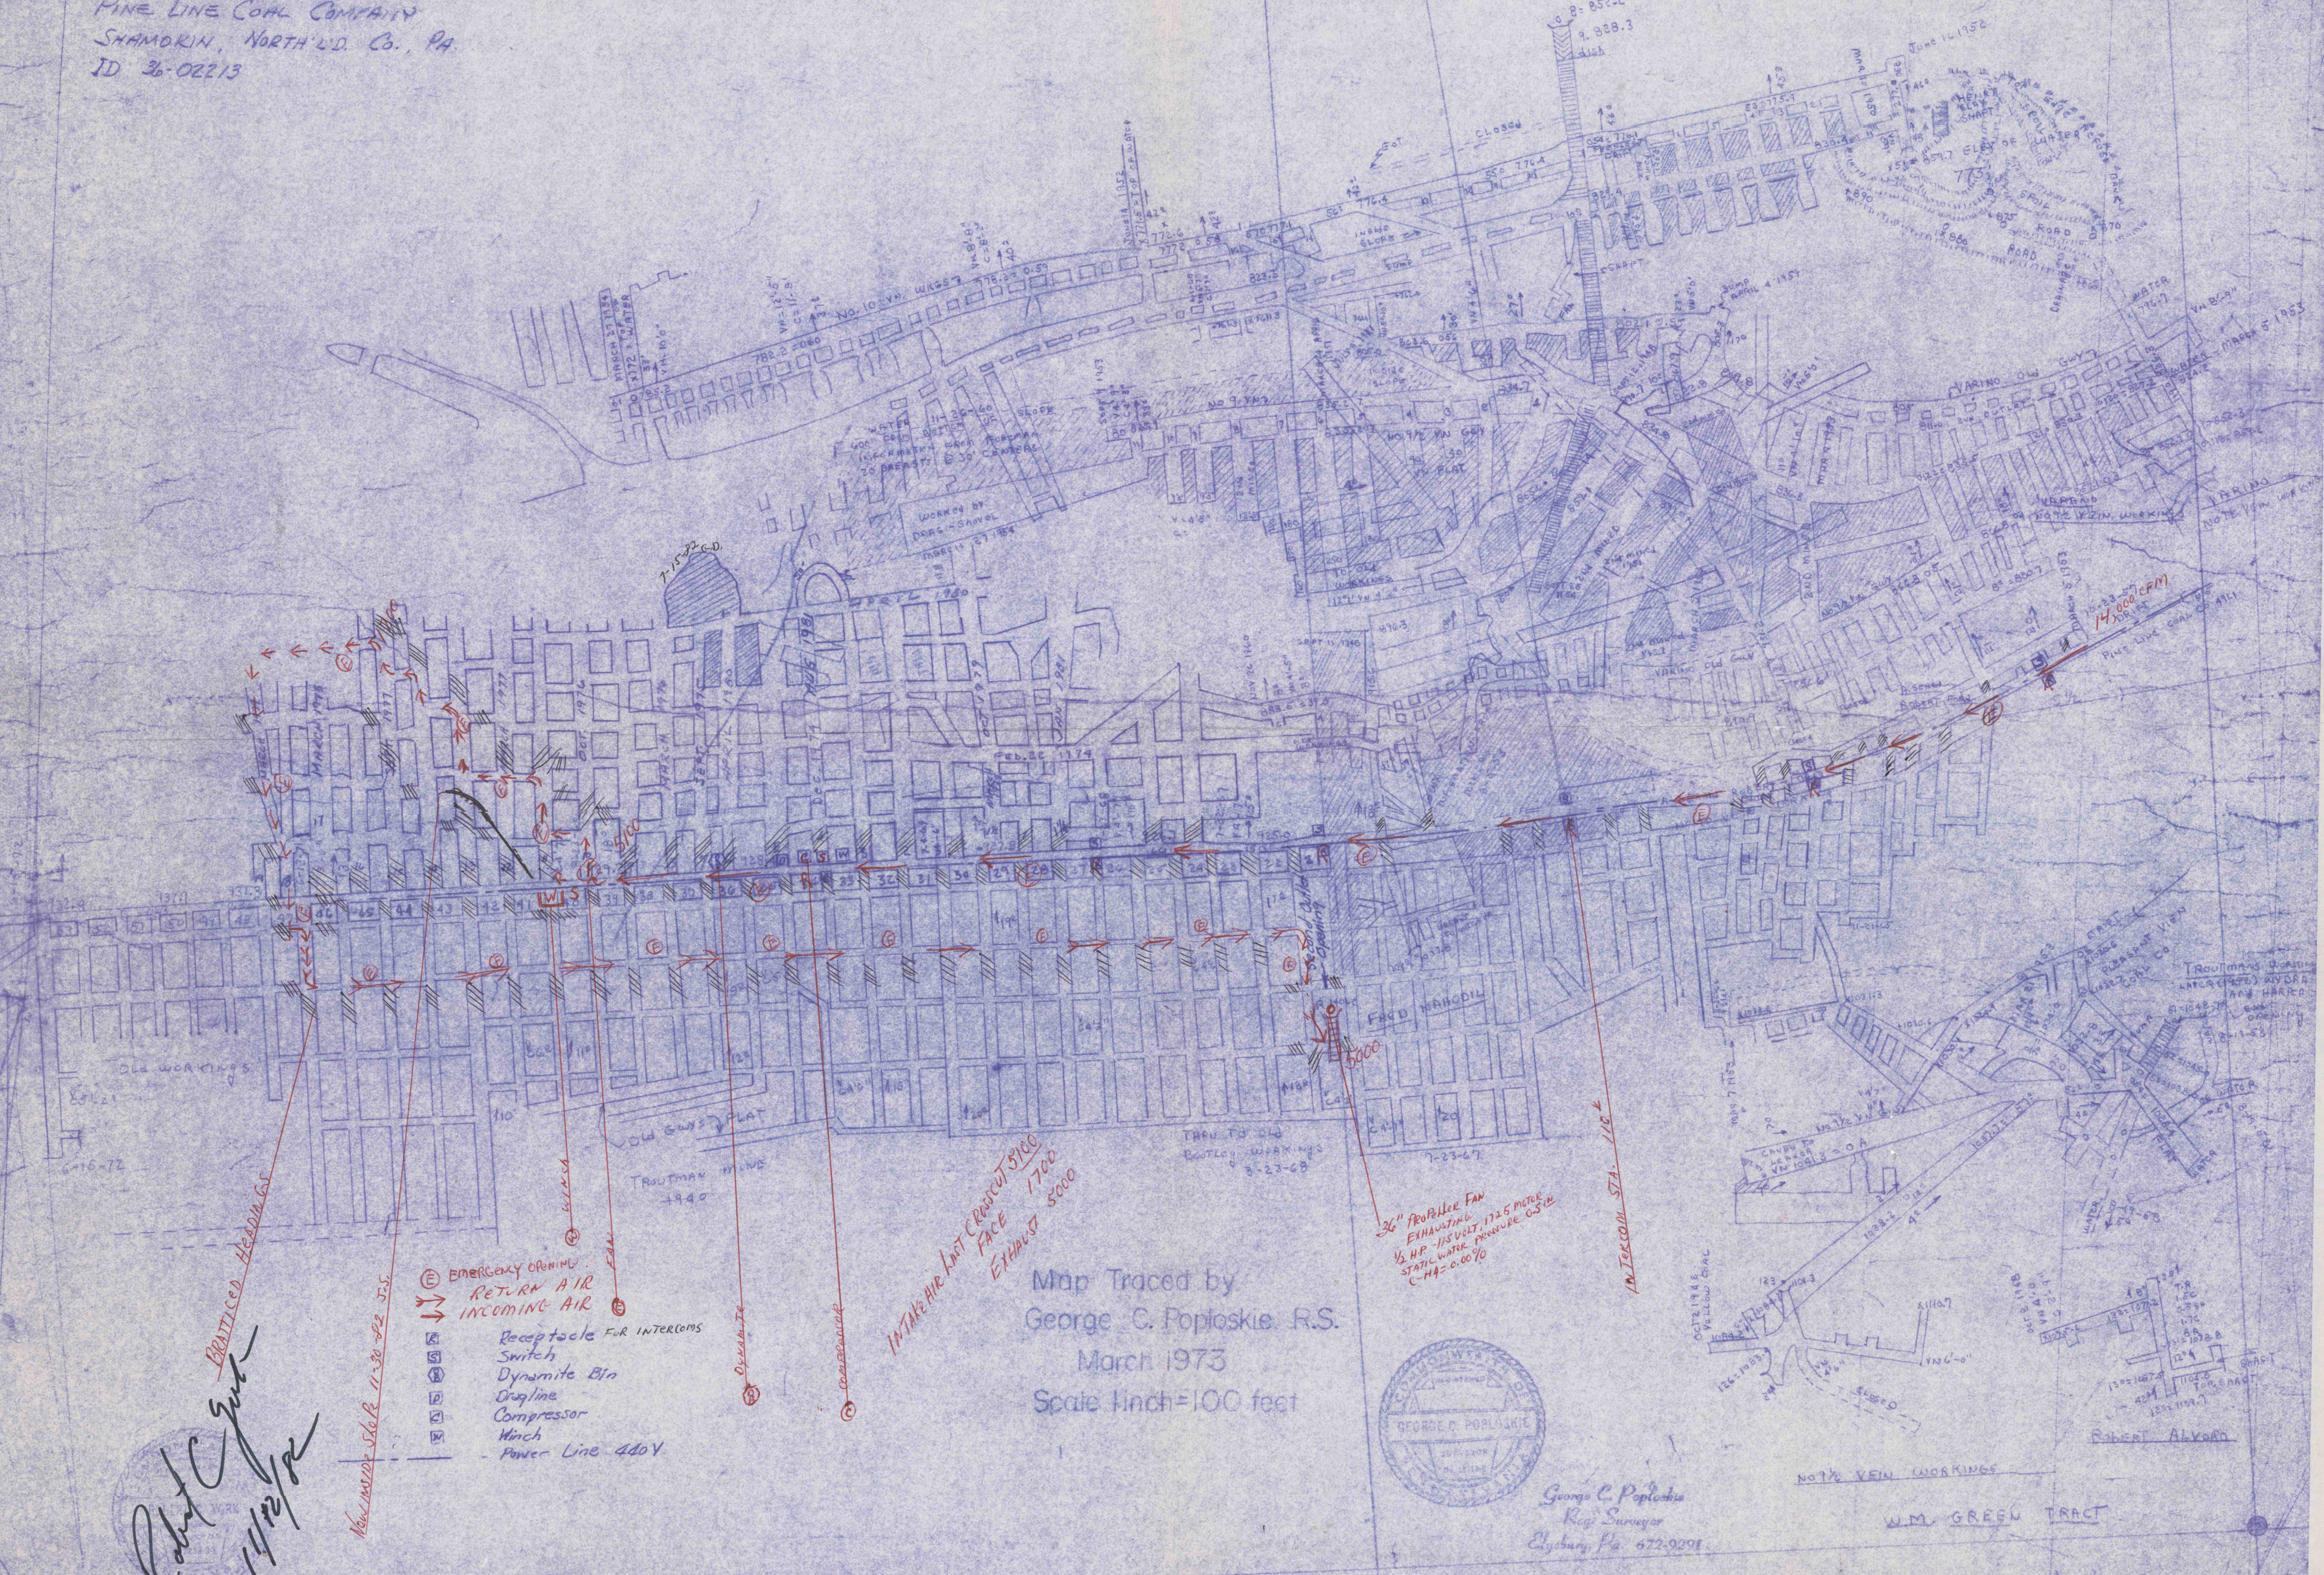

- ⊕ Emergency Opening
- ↔ RETURN AIR
- ↔ INCOMING AIR
- ⊠ Receptacle for INTERCOMS
- ⊠ Switch
- ⊠ Dynamite Bin
- ⊠ Dragline
- ⊠ Compressor
- ⊠ Winch
- ⊠ Power Line 480V

Intake Air Last Crosscut 5100
 Face 1700
 Exhaust 5000

36" Propeller Fan
 Exhausting
 1/2 HP - 115 VOLT, 1725 RPM
 Static Water Pressure 65 PSI
 C-H2 = 0.0070



George C. Poploskie
 Registered Professional Surveyor
 Elyburg, Pa. 672-9291

U.M. GREEN TRACT