


PETER PETERY TRACT

GRANT TRACT

TREVORTON ESTATE TRACT

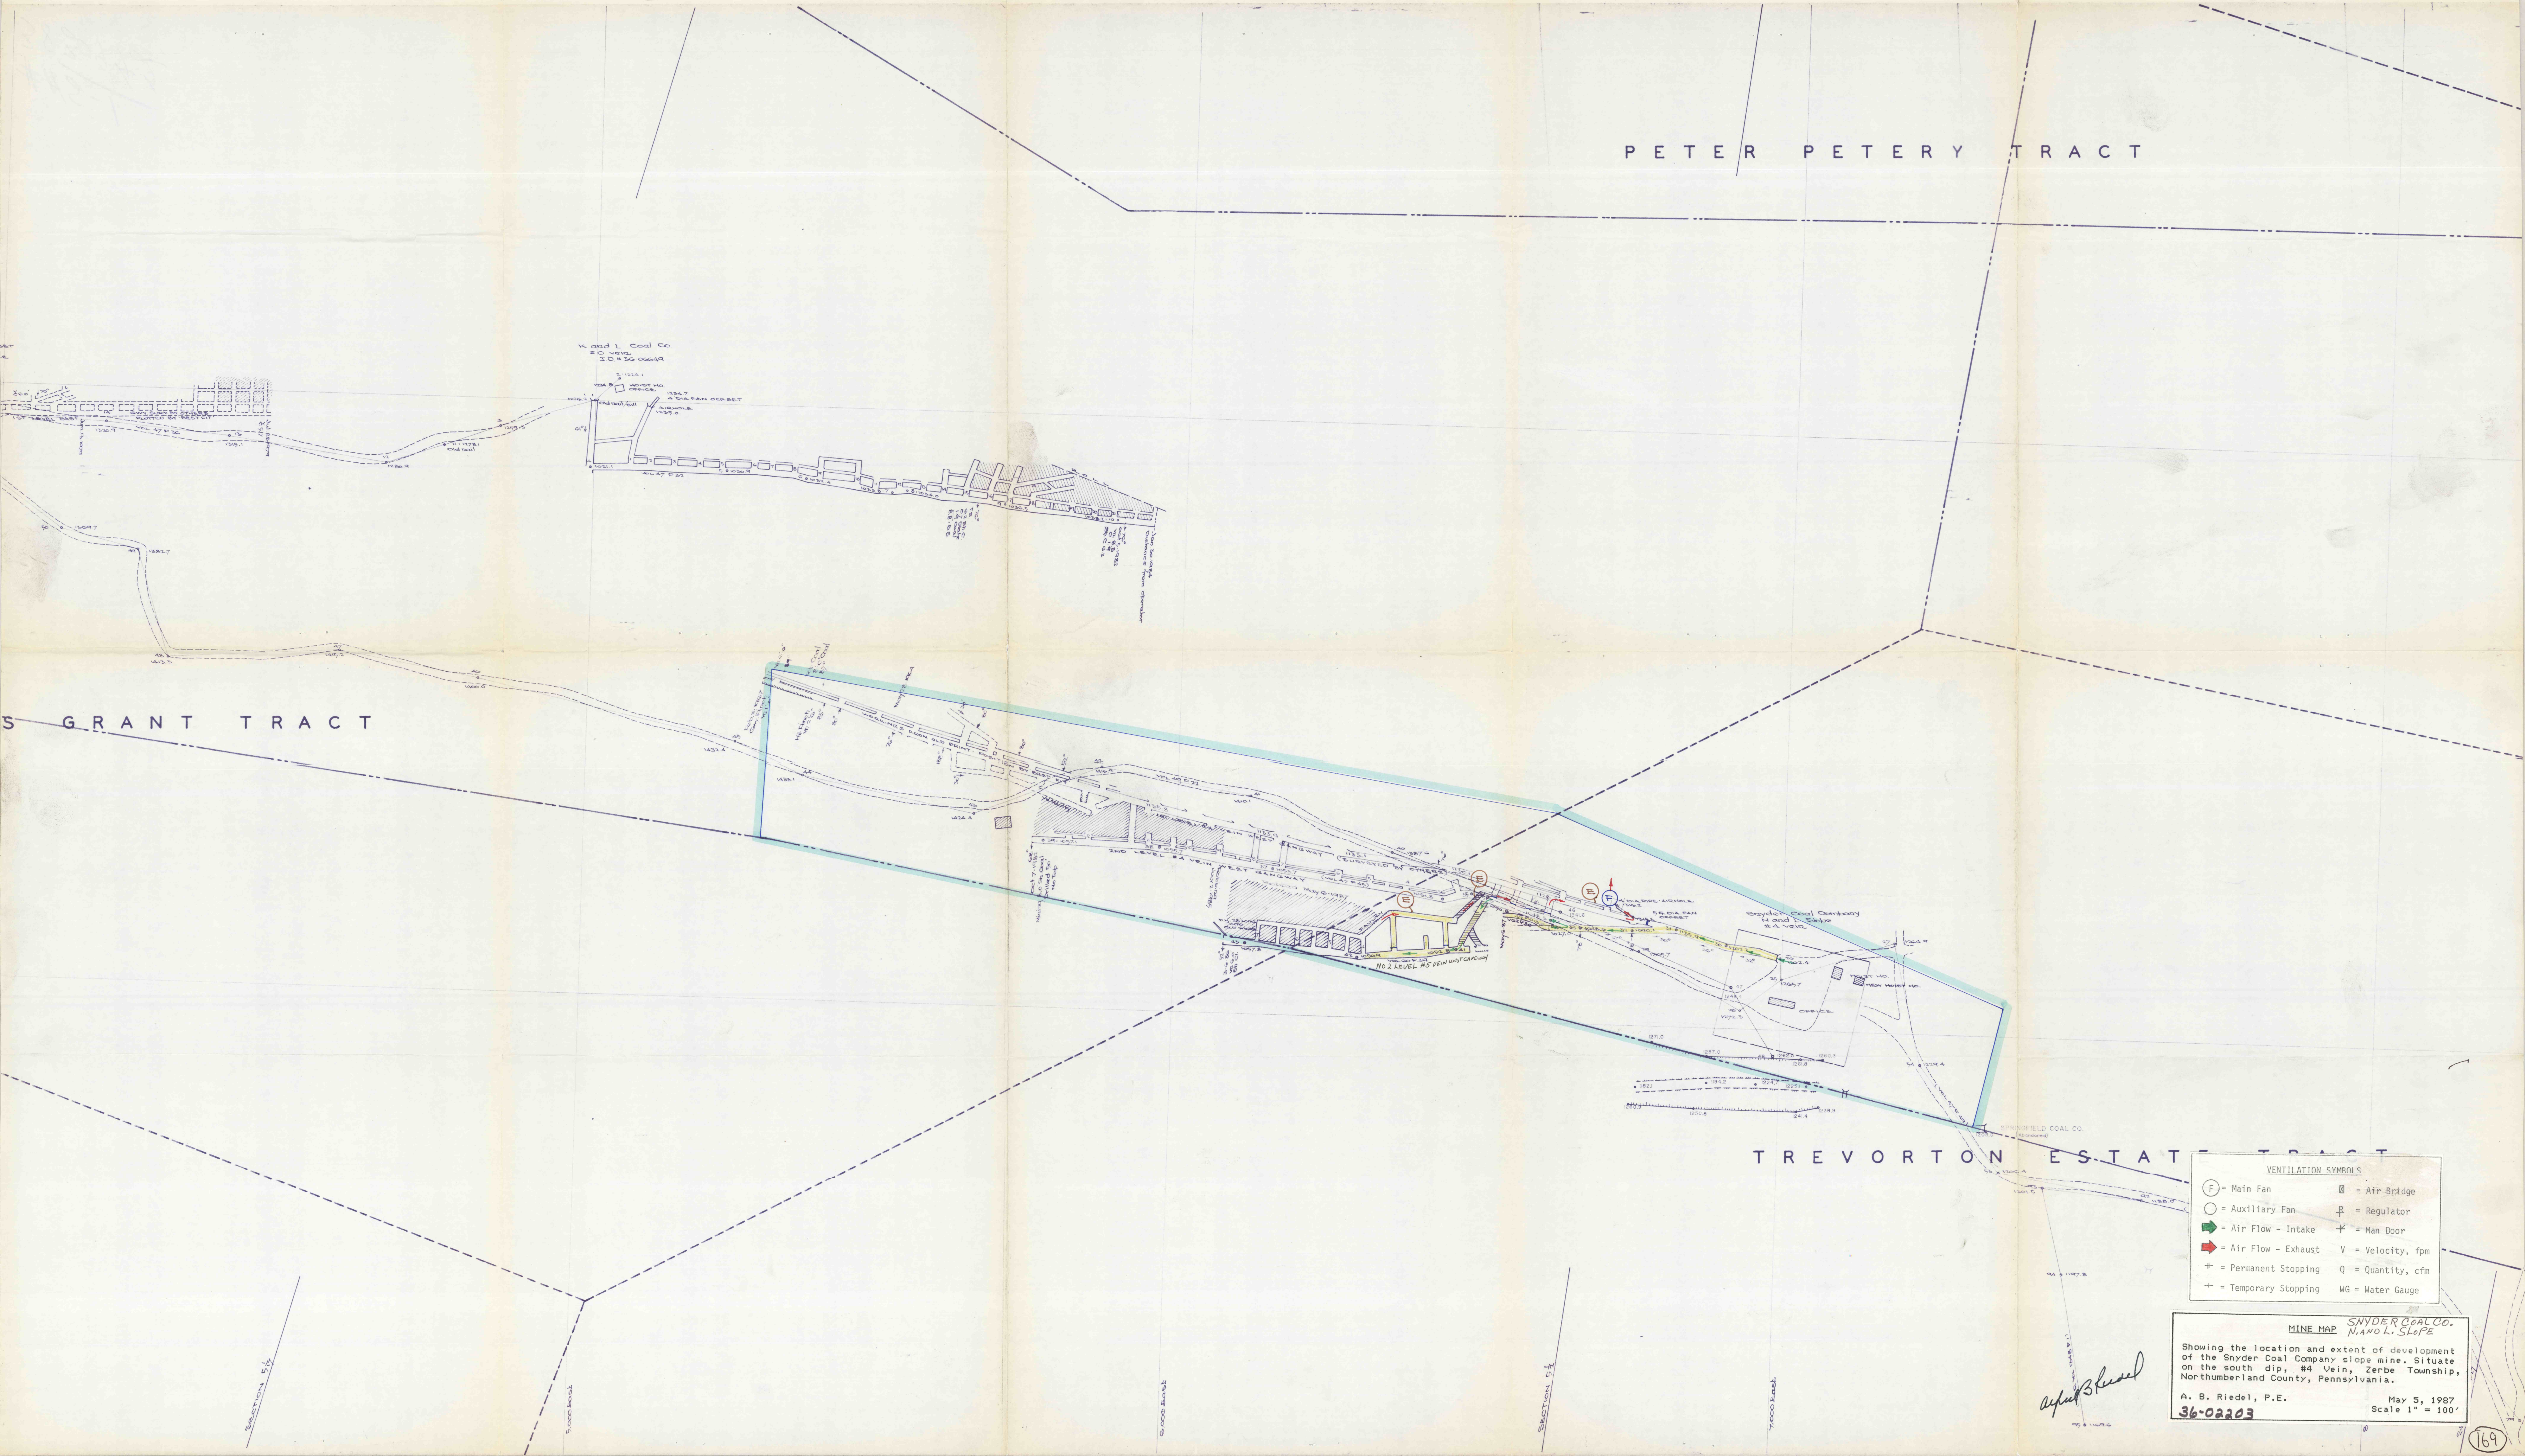

VENTILATION SYMBOLS			
(F) = Main Fan	(A) = Air Bridge	(V) = Velocity, fpm	(Q) = Quantity, cfm
(A) = Auxiliary Fan	(R) = Regulator	(WG) = Water Gauge	
(I) = Air Flow - Intake	(E) = Air Flow - Exhaust	(M) = Man Door	
(P) = Permanent Stopping	(T) = Temporary Stopping		

MINE MAP SNYDER COAL CO.
NAND L. SLOPE
Showing the location and extent of development
of the Snyder Coal Company slope mine. Situate
on the south dip, #4 vein, Zerbe Township,
Northumberland County, Pennsylvania.
A. B. Riedel, P.E. May 3, 1987
36-02203 Scale 1" = 100'