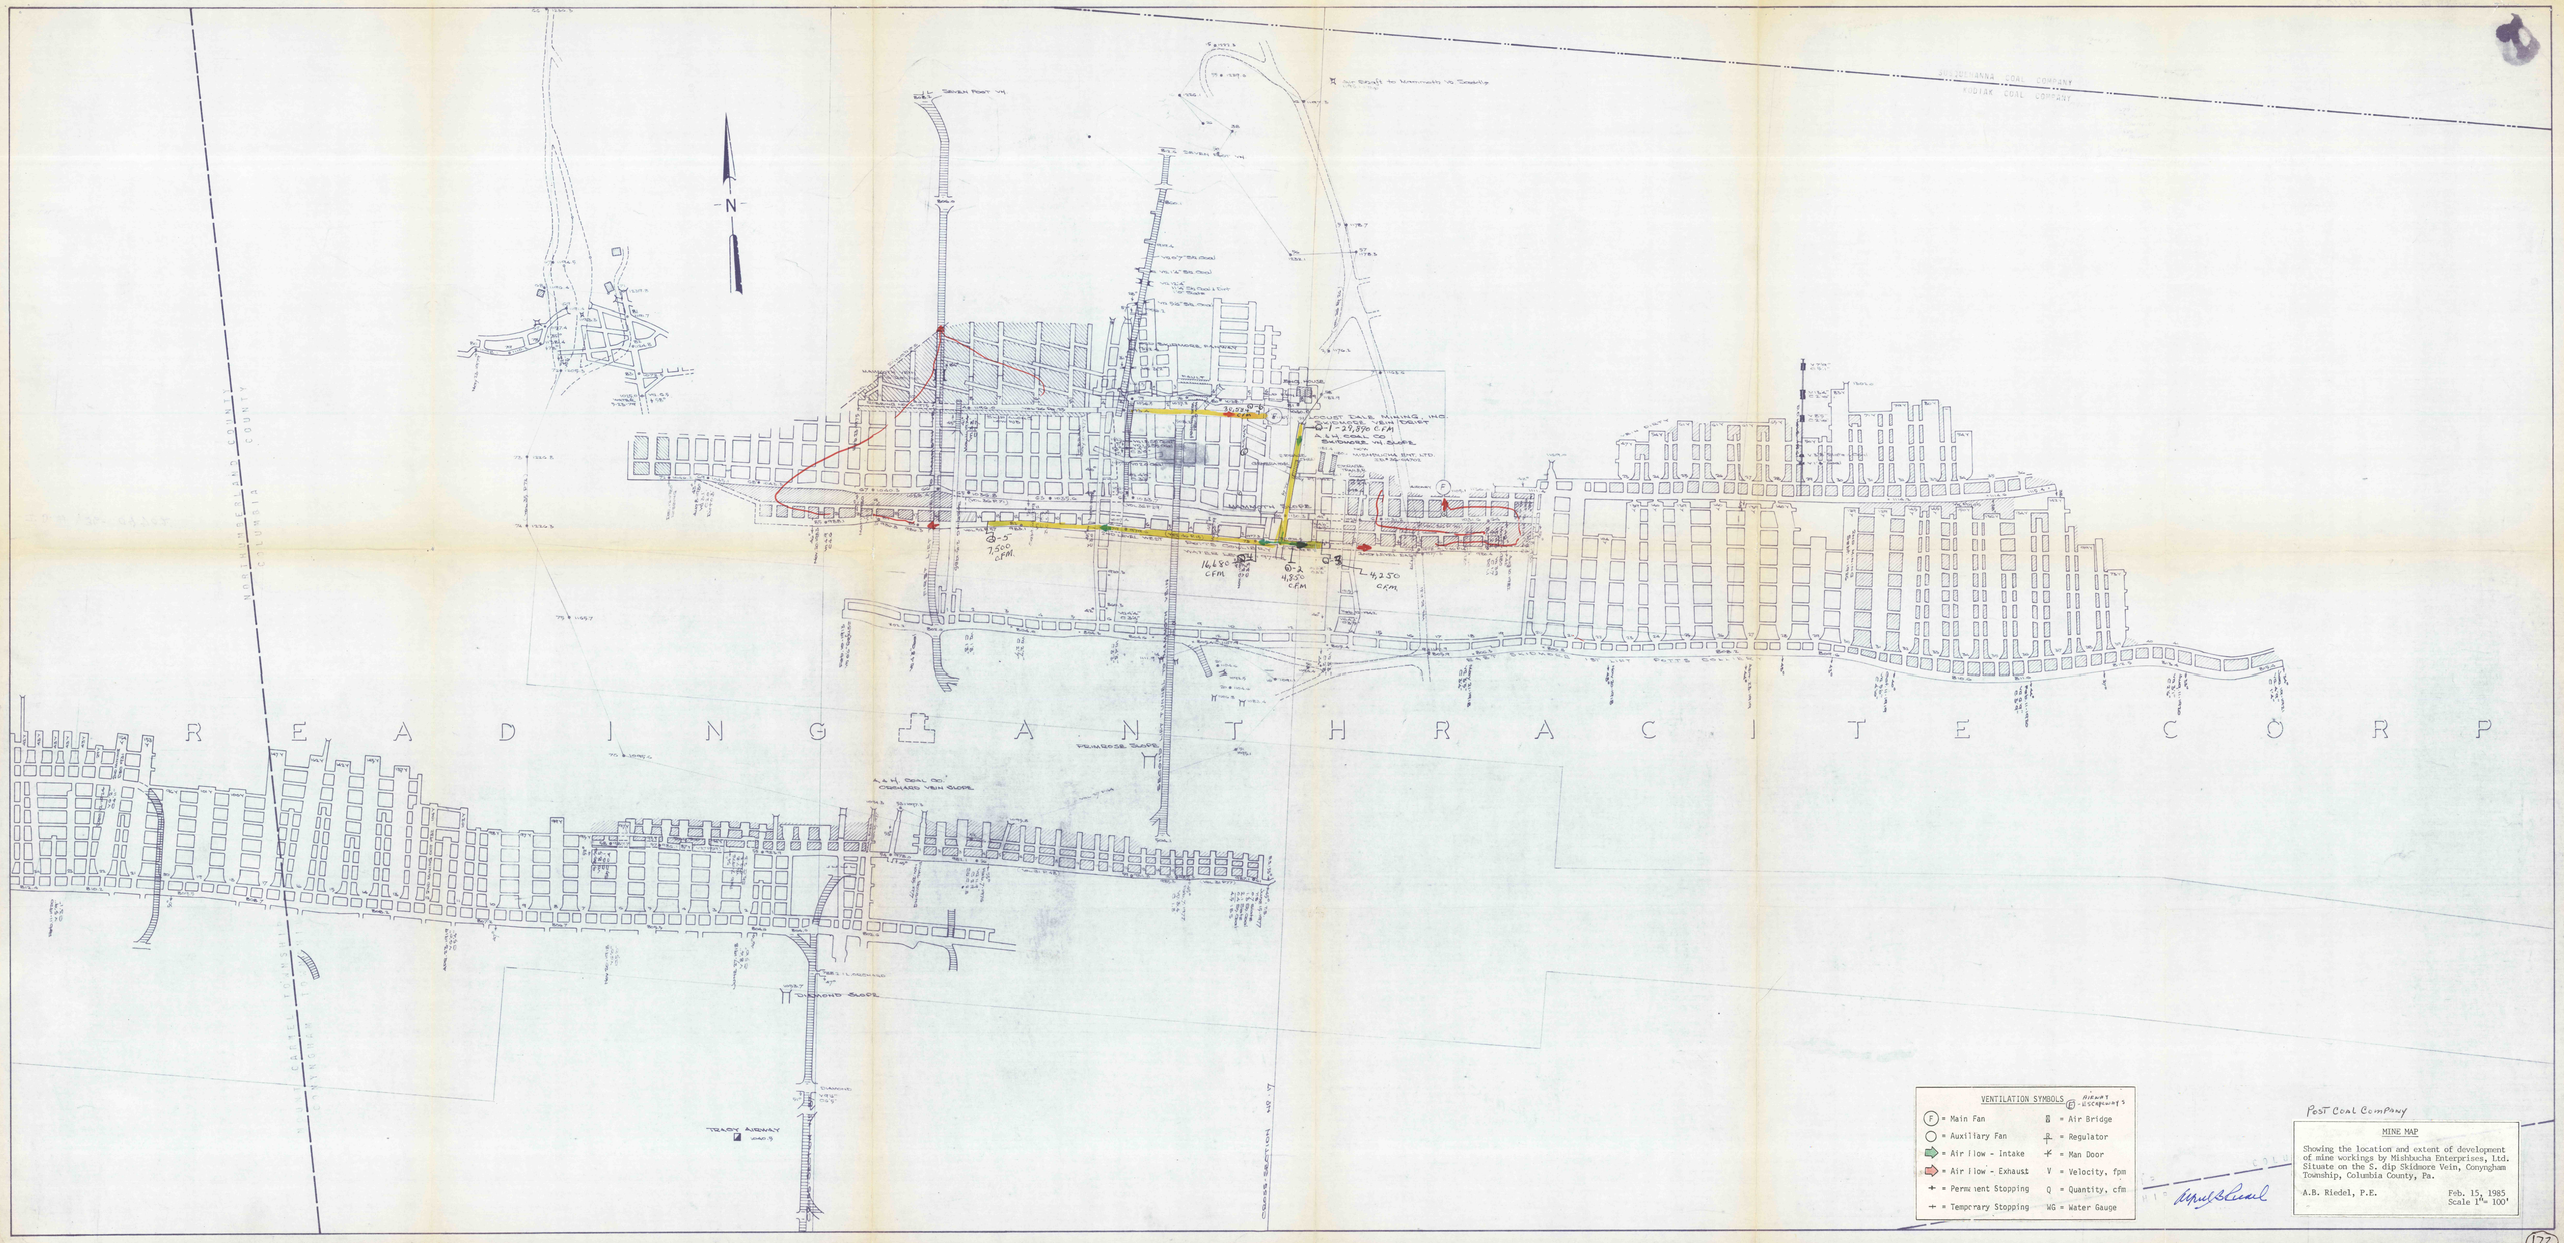
N
R E A D I N G A N T H R A C I T E C O R P
NORTHUMBERLAND COUNTY
COLUMBIA
A.&H. COAL CO.
TRACY AIRWAY
CONYNGHAM SECTION
SUSQUEHANNA COAL COMPANY
Q-1 27,896 CFM
Q-5 7,500 CFM
16,680 CFM
Q-2 4,950 CFM
L 4,250 CFM
VENTILATION SYMBOLS
= Main Fan
= Auxiliary Fan
= Air Flow - Intake
= Air Flow - Exhaust
= Permanent Stopping
= Temporary Stopping
= Air Bridge
= Regulator
= Man Door
V = Velocity, fpm
Q = Quantity, cfm
WG = Water Gauge
Post Coal Company
MINE MAP
Showing the location and extent of development of mine workings by Misbocha Enterprises, Ltd. Situate on the S. dip Skidmore Vein, Conyngham Township, Columbia County, Pa.
A.B. Riedel, P.E.
Feb. 15, 1985
Scale 1" = 100'