


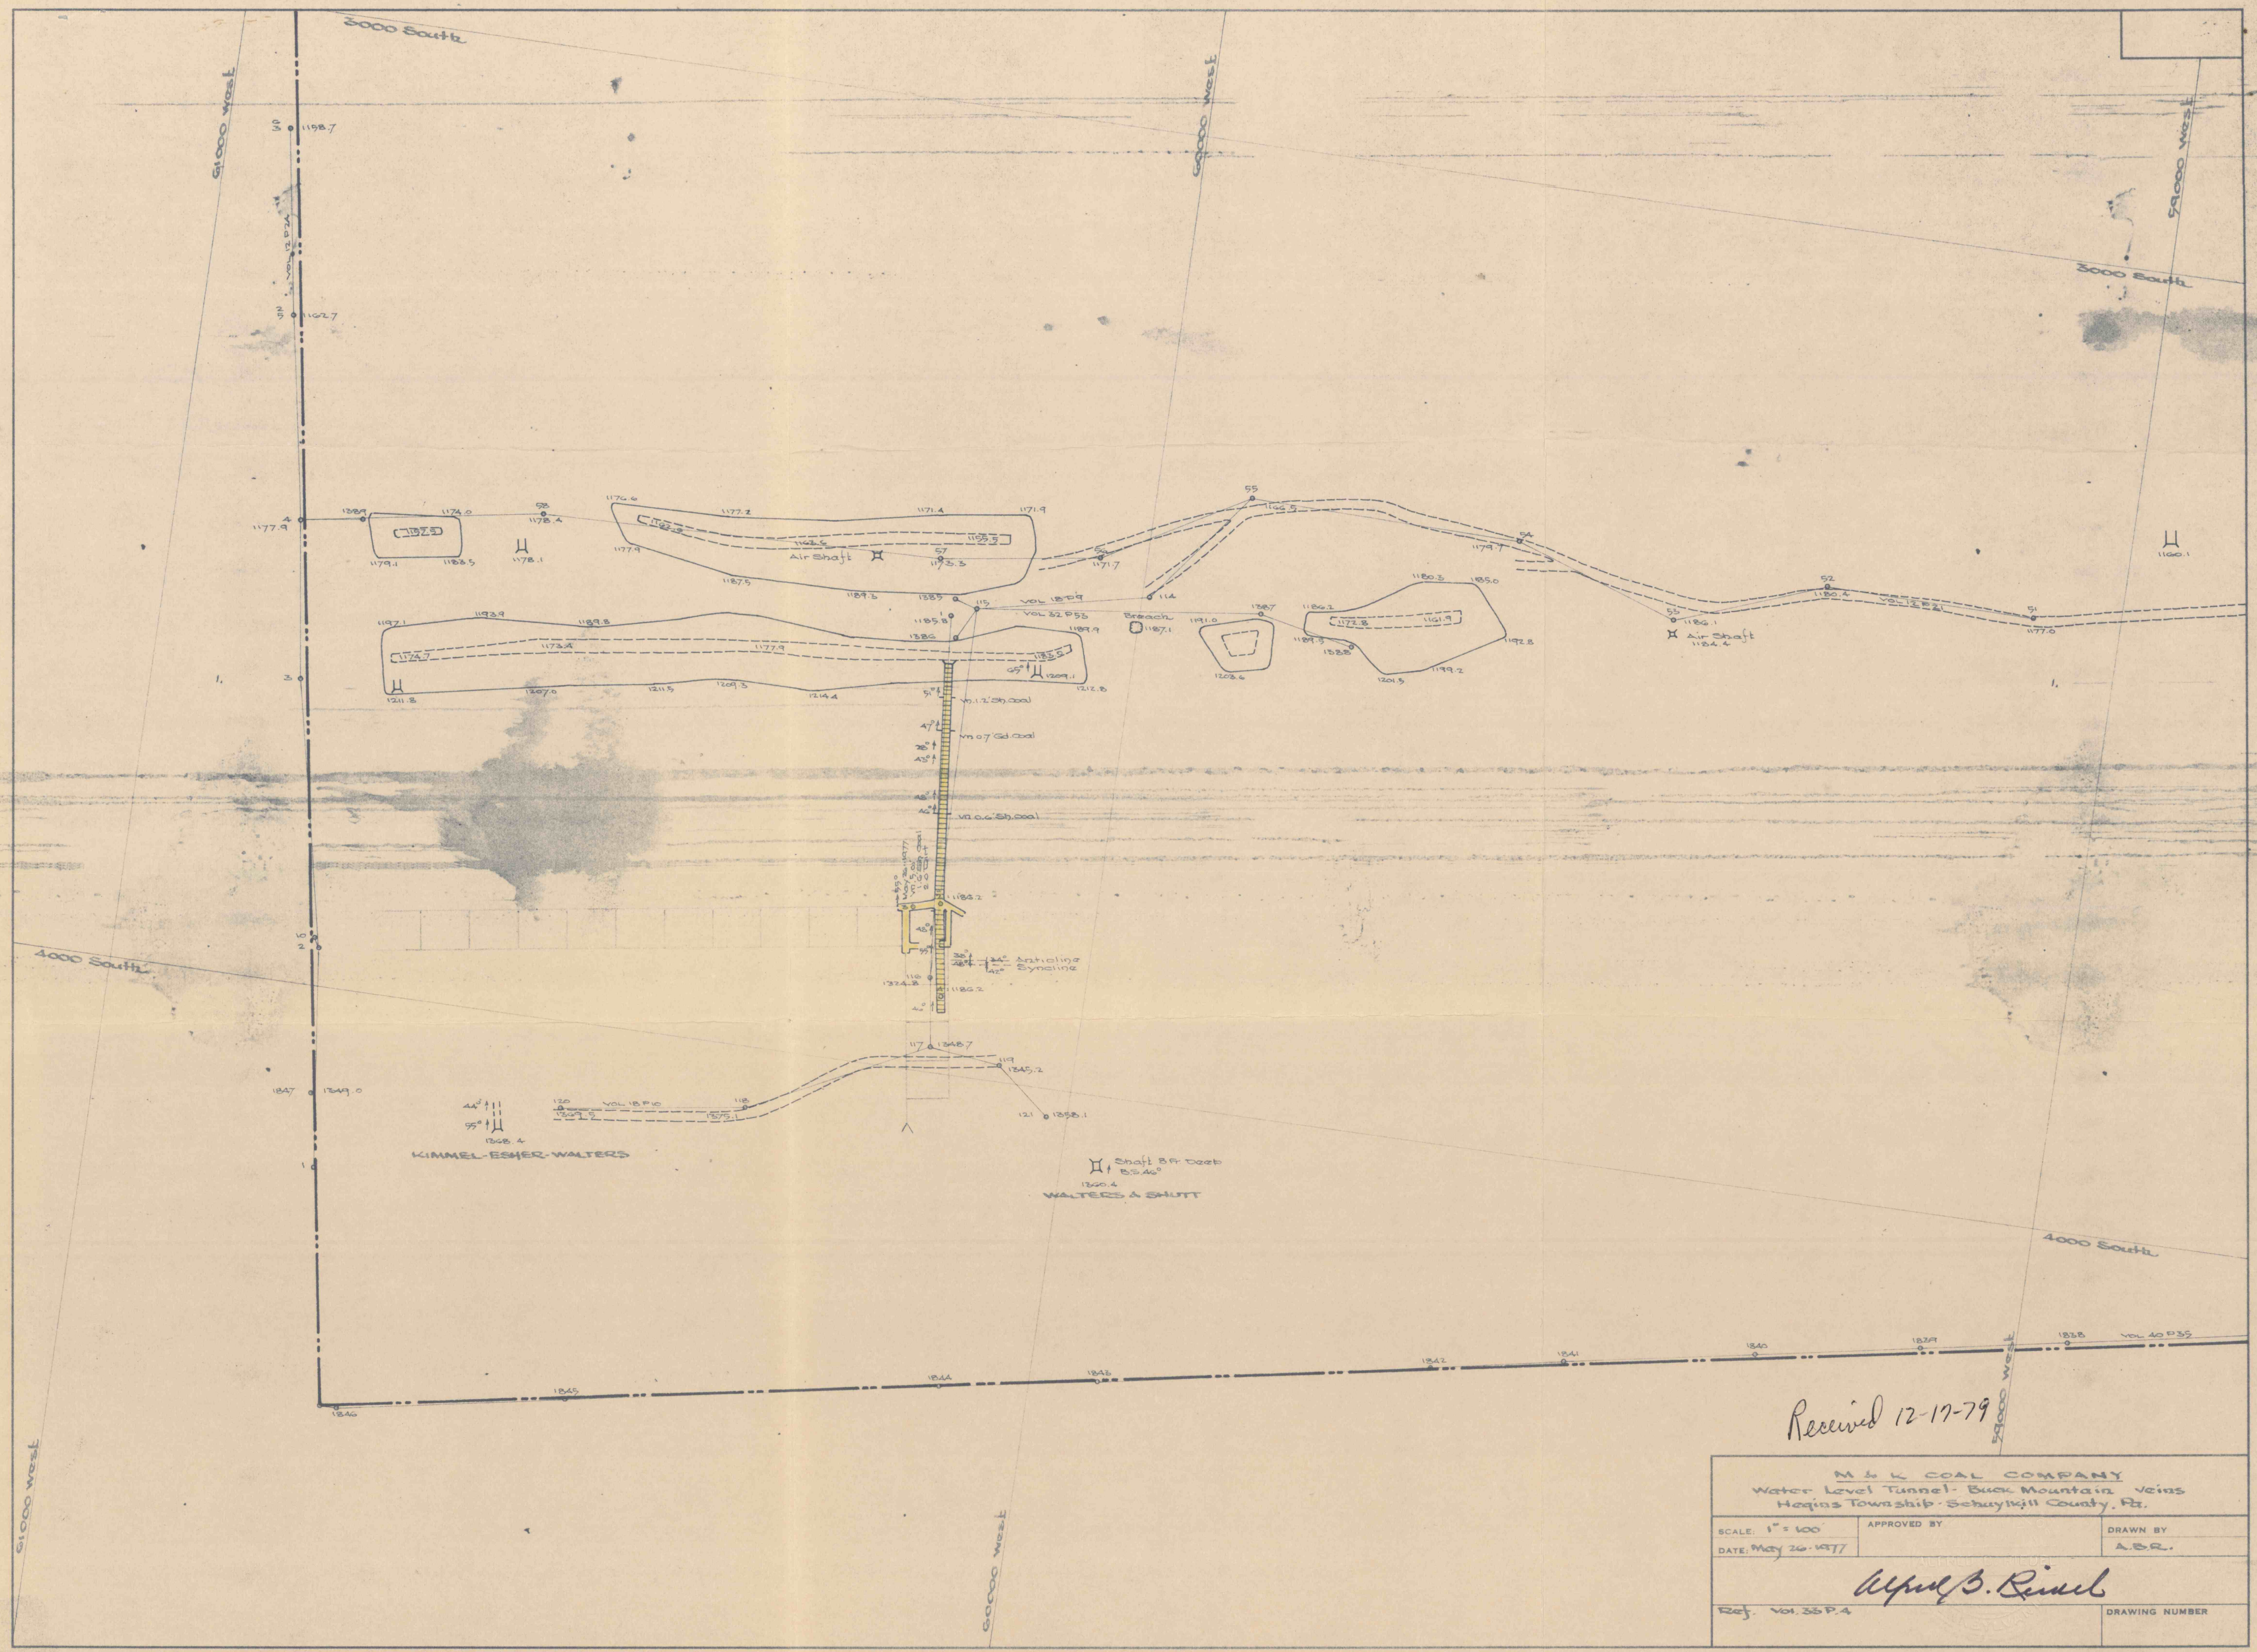

Received 12-17-79

M & K COAL COMPANY		
Water Level Tunnel - Buck Mountain Veins		
Hogans Township - Schuylkill County, Pa.		
SCALE: 1" = 100'	APPROVED BY	DRAWN BY
DATE: May 26, 1977		A.B.R.
Ref. Vol. 35 P. 4		
DRAWING NUMBER		

