


W E S T E R N B I T U M I N O U S M I N I N G C O M P

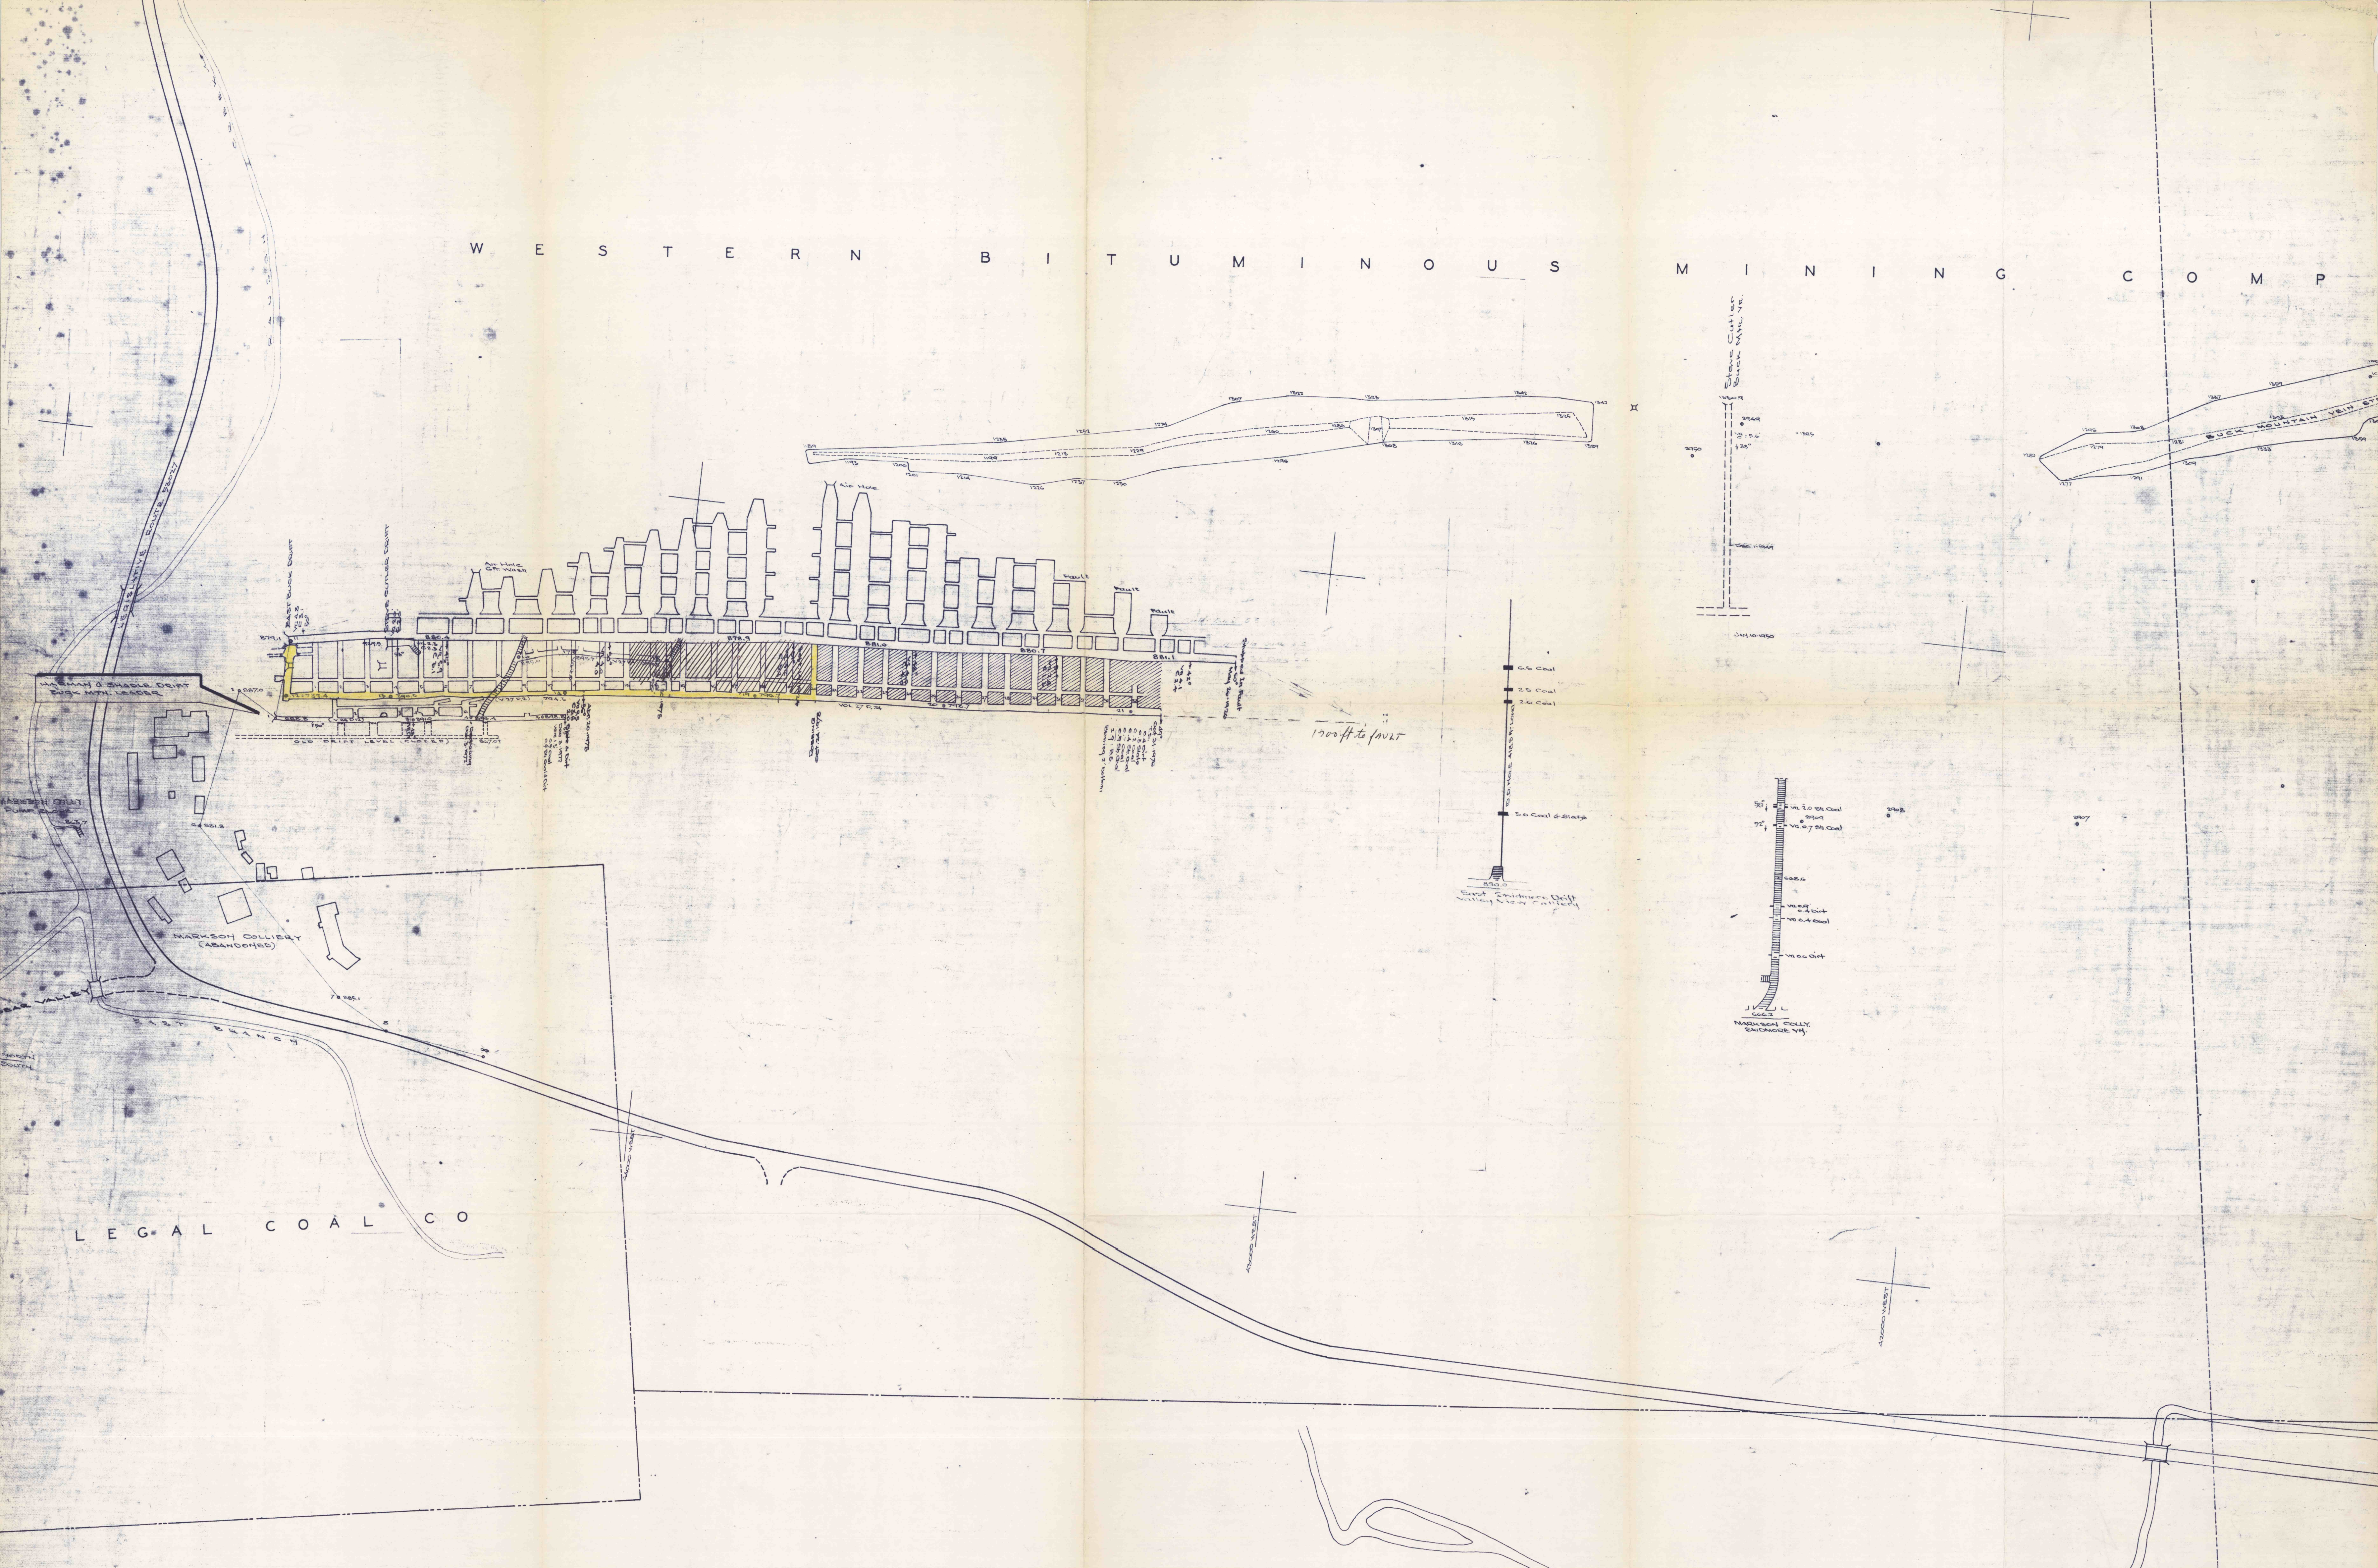

April B. Riedel

MINE MAP
Showing the location and extent of development of the Harman & Shadle Coal Company Slope Mine. Situated on the So. dip Buck Mountain Vein, Hegins Twp., Schuylkill County, Pa.
A.B. Riedel, P.E. Oct. 24, 1978
Scale 1"=100'