



 

RESERVATION HILLAR

- + TEMPORARY STOPPING
- # PERMANENT STOPPING
- ⌵ REGULATOR
- ∇ AIR BRIDGE
- + AIR CURRENT
- o EXHAUST FAN

MINE MAP
PORTER TWP. SCH. CO. PA.
SHOWING WILLIAMSON SHALE CO. SKIDMORE
VEIN WORKINGS ON LAND OF WILSON COAL CO.
SURVEYED AUG-21-1914 SCALE 1"=100'
POSTED JAN. 23-1915

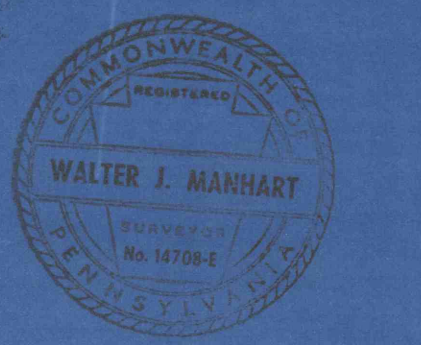


Williamson Coal Co.
36-02033

SKIDMORE