


THOMAS REESES JR. TRACT

WILLIAM LANE TRACT

MARY LANE TRACT

No. 5 Vein Workings - Hickory Swamp Area
Coal Township, Northumberland County

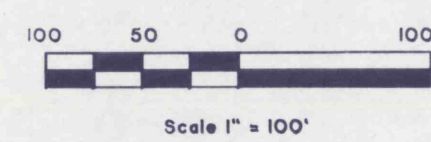

No. 1 SLOPE

VENTILATION SYMBOLS

 = Main Fan	 = Air Bridge
 = Auxiliary Fan	 = Regulator
 = Air Flow - Intake	 = Man Door
 = Air Flow - Exhaust	V = Velocity, fpm
+ = Permanent Stopping	Q = Quantity, cfm
+ = Temporary Stopping	WG = Water Gauge

L. F. W. Cool Company INC, NO 2 Slope
36-07171 MINE MAP
Showing the location and extent of development
of the ~~two~~ ~~one~~ ~~one~~ # 5 Vein workings.
Situate in the Hickory Swamp Area of Coal Twp.,
Northumberland County, PA. ID# 36-07171

A.B. Riedel P.E. July 27, 1988
Scale 1" = 100'

April 3. Russell