

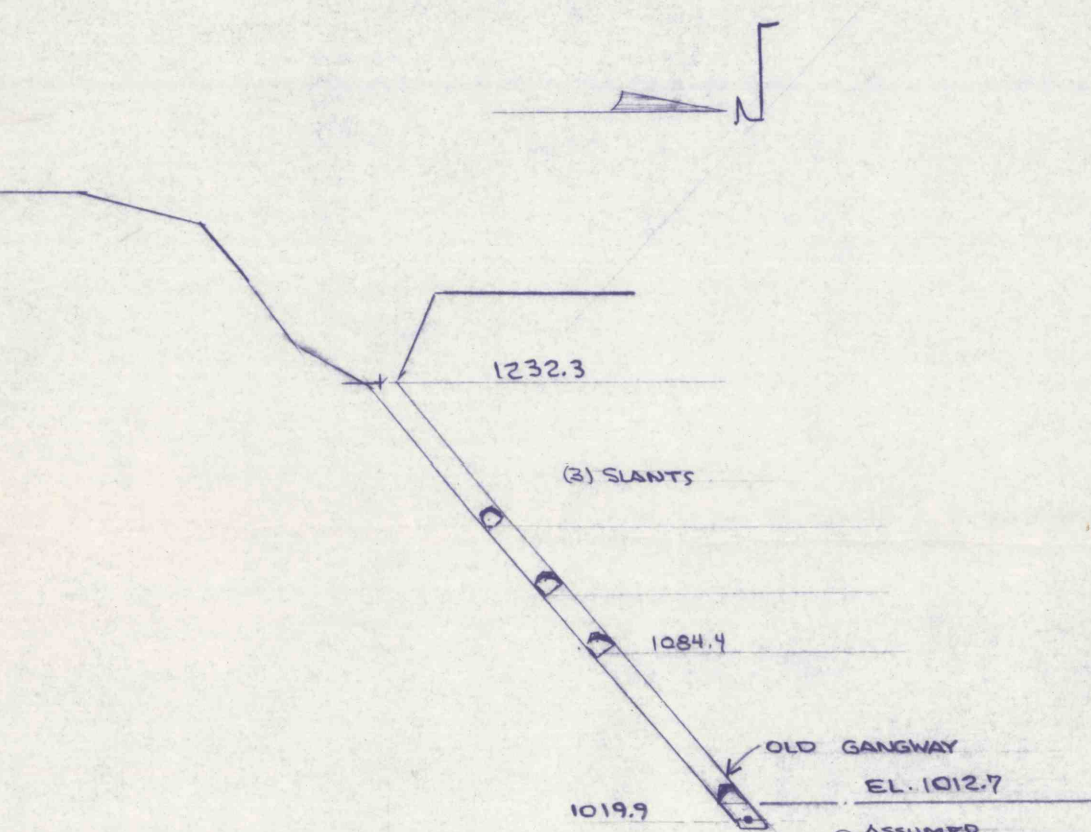
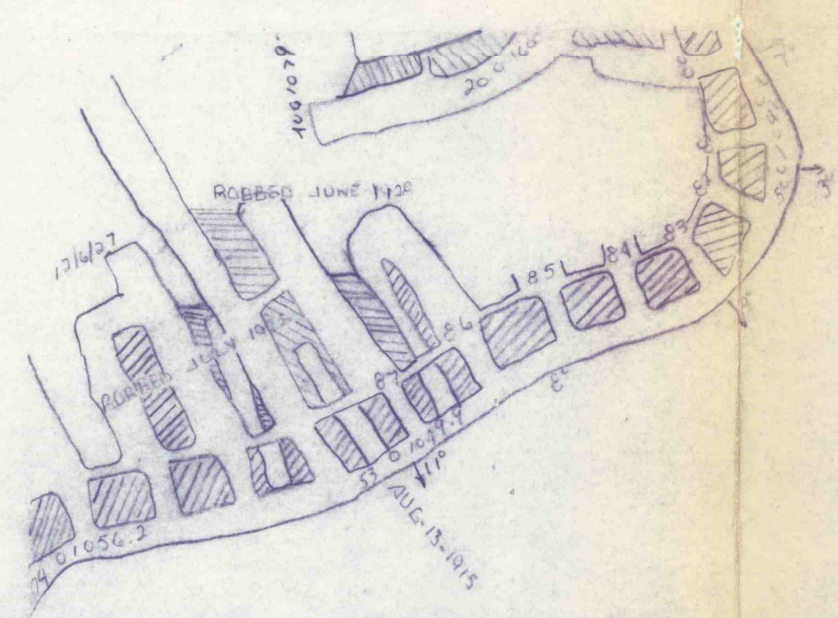
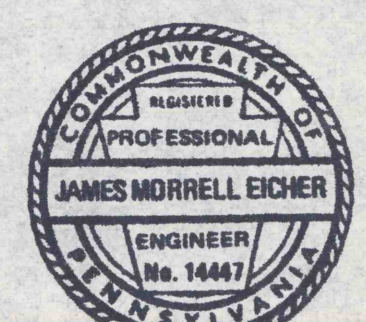


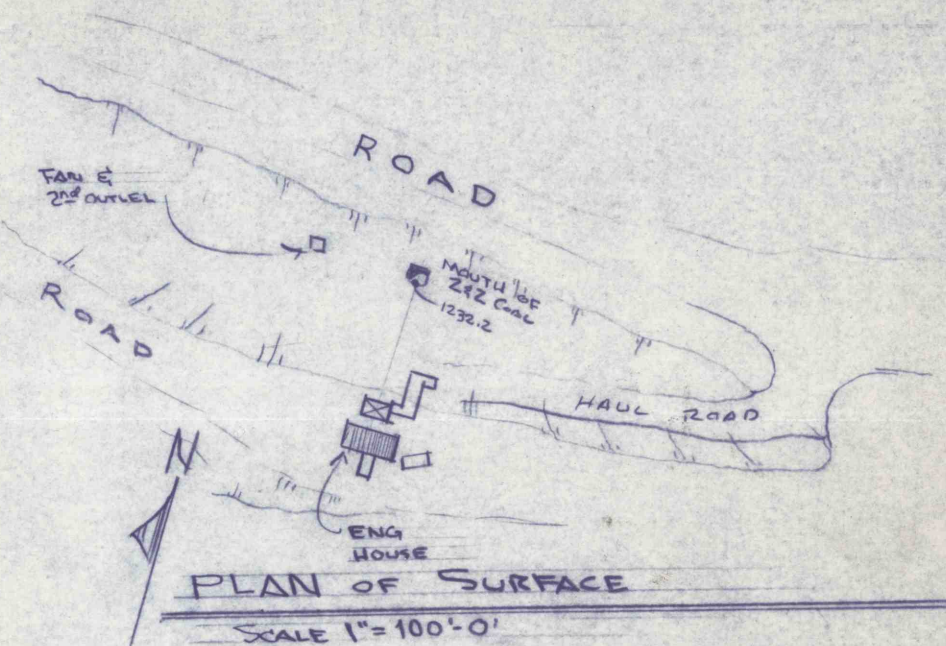

SECTIONS THRU Z&Z COAL CO SLOPE
SCALE 1"=1'-0"

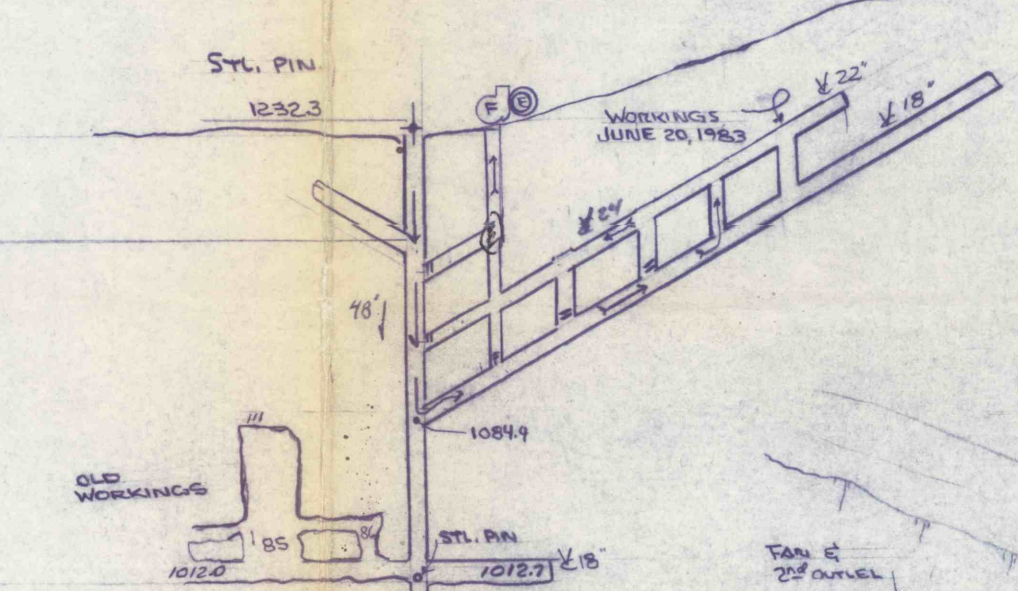

James Morrell Eicher 7/19/83

Z&Z COAL CO. No. 1 Slope I.D. 36-05906
EXCELSIOR
NORTH D. COUNTY PA.
10 VEIN

SCALE 1"=100'-0"

LEGEND

→ AIR SUPPLY	○ ESCAPE
← AIR RETURN	--- TEMPORARY STOPPING
□ PERMANENT STOPPING	
⊙ FAN	