
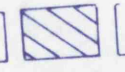
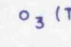
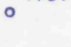







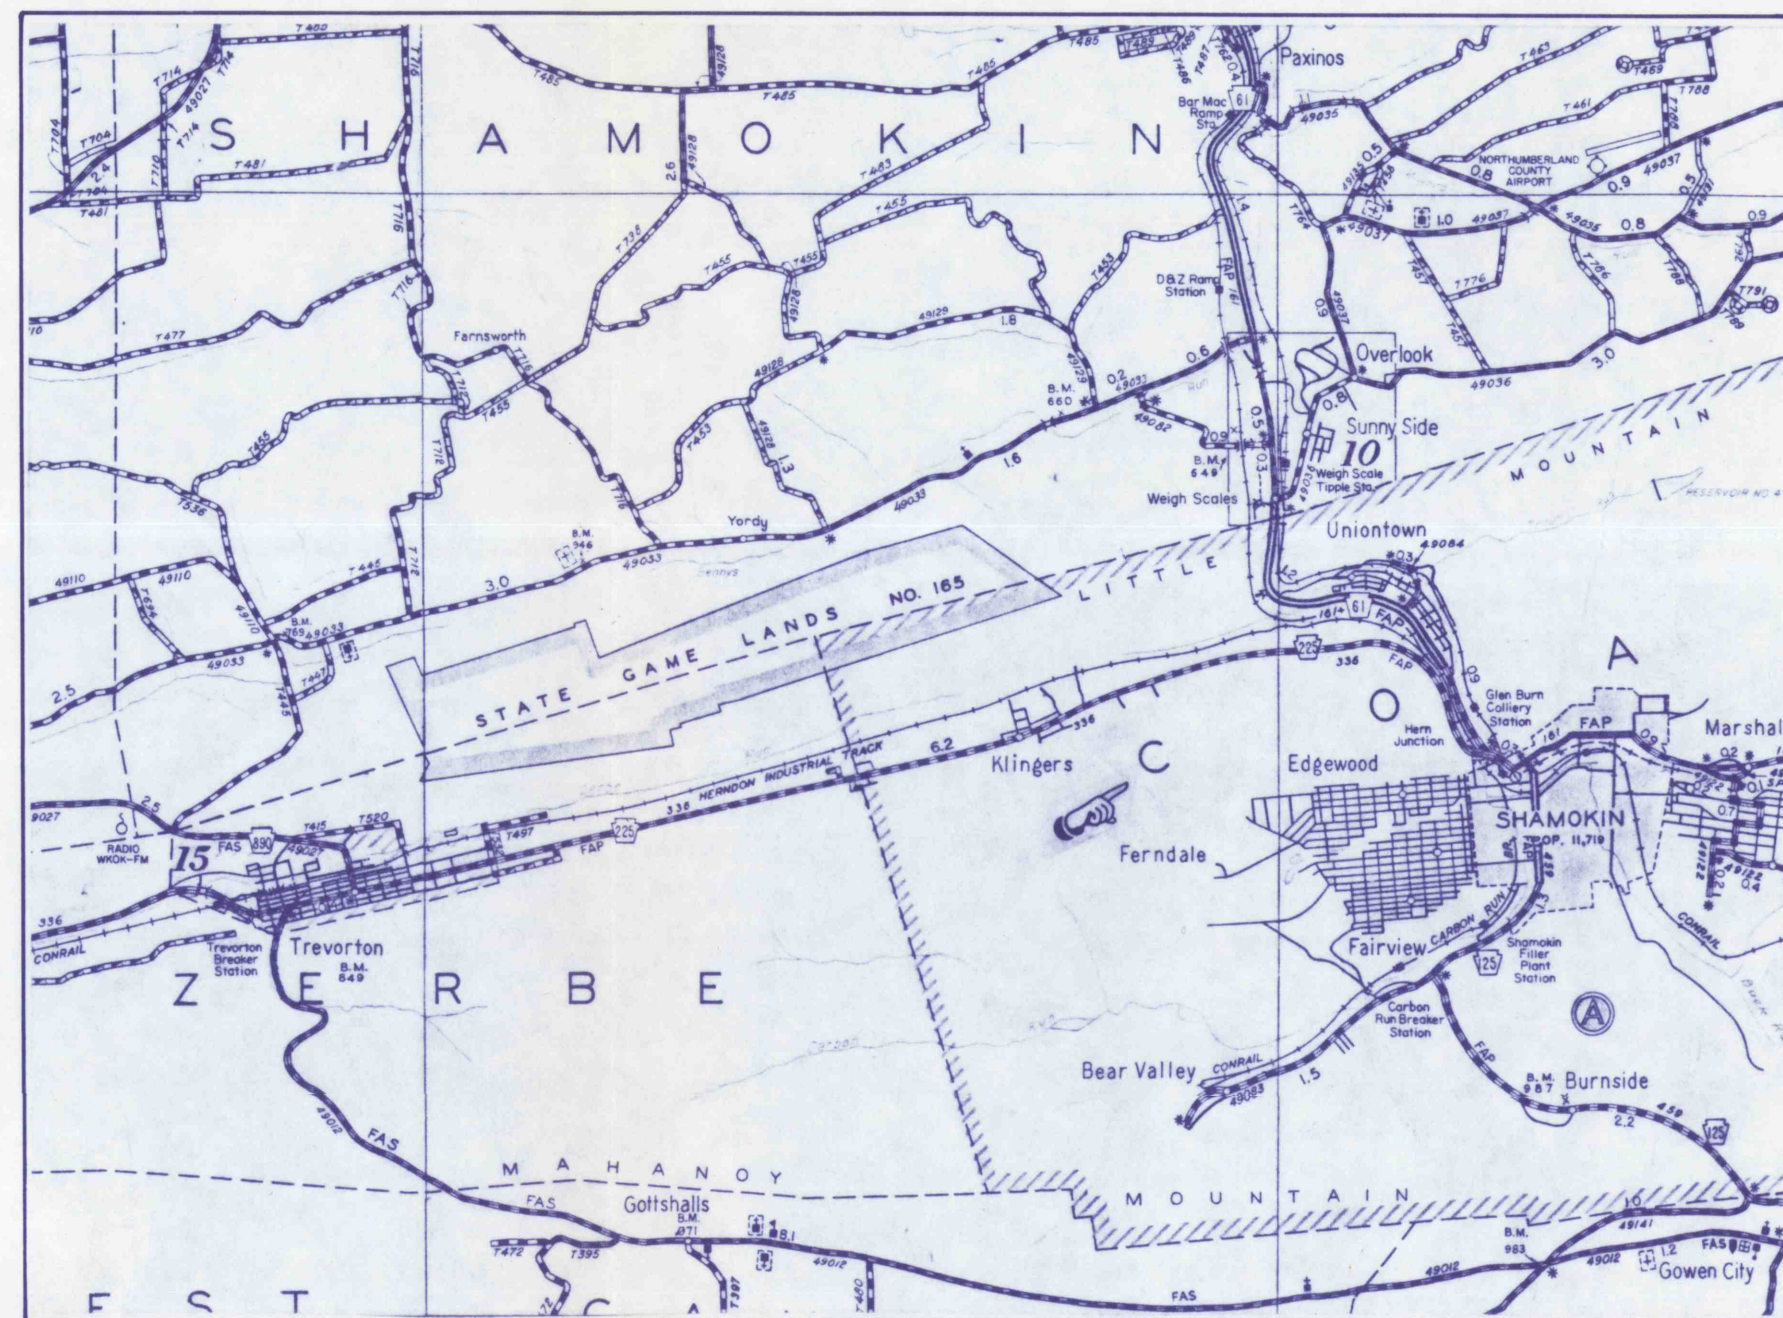
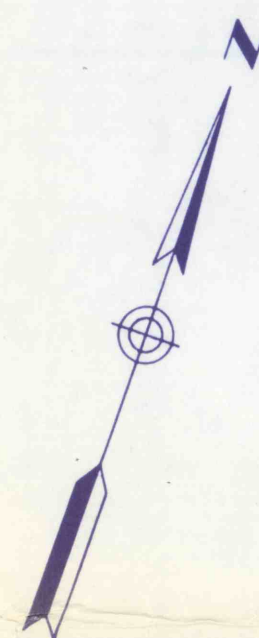


LEGEND

- ESCAPEWAY 
- ROBBED 
- SURVEY STATION  (TAYLOR-DOBECK ASSOC.)  4167A (SUSQUEHANNA COAL CO.)
- ELEVATION +1382 (SUSQUEHANNA COAL CO. DATUM)
- STOPPING 
- INTAKE AIR 
- RETURN AIR 
- OLD ABANDONED WORKINGS 
- NEW WORKINGS OF NORTH MOUNTAIN COAL CO., INC. 
- PROPERTY LINE 
- OUTCROP LINE 




Location Map
1 Inch = 1 Mile

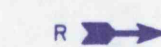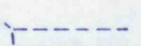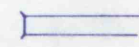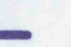


Pennsylvania State Highway Traffic Route No. 225
To Trevorton To Shamokin

Pennsylvania Power & Light Co. Right-Of-Way

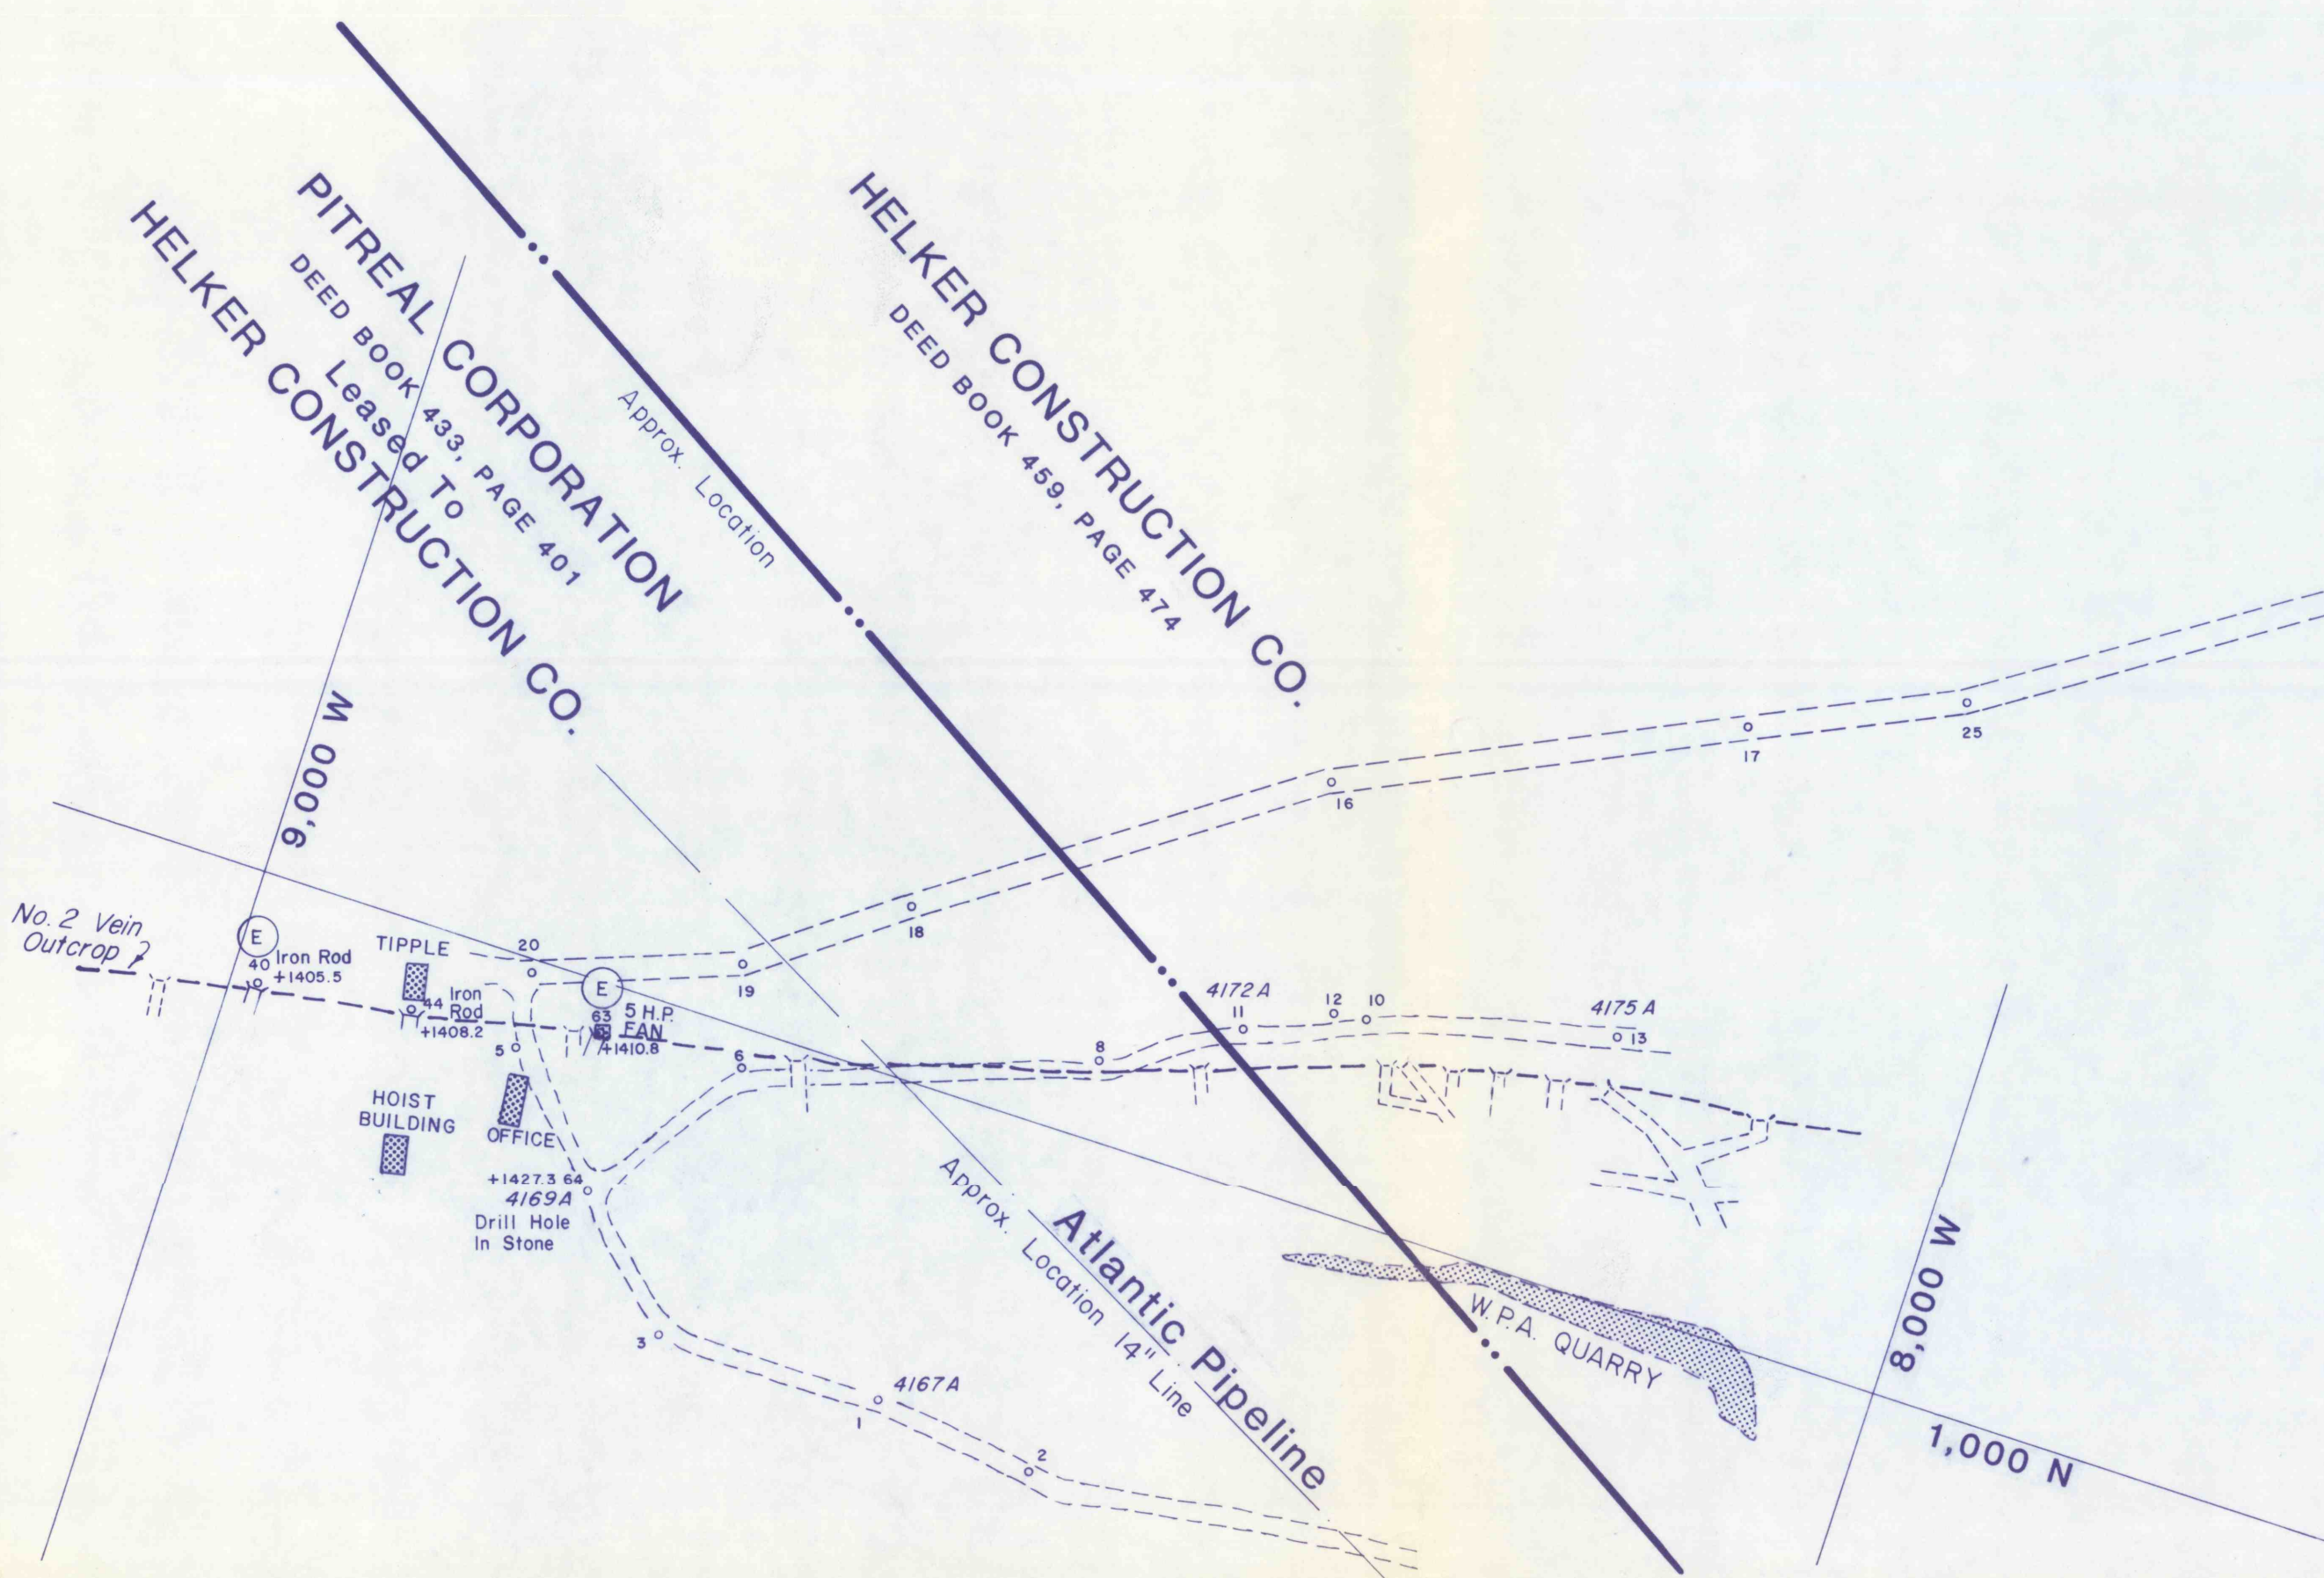

No. 2 Vein - South Dip
MINE SURVEY FOR
NORTH MOUNTAIN COAL CO., INC.
COAL TOWNSHIP, NORTHUMBERLAND COUNTY
PENNSYLVANIA
SCALE: 1 INCH = 100 FEET, OCTOBER 16, 1985
M.S.H.A. I.D.# 36-05873

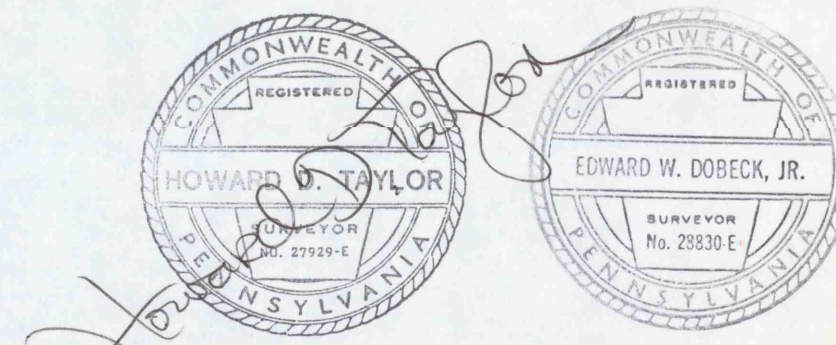

John B. Heibel

Taylor-Dobeck Associates
PROFESSIONAL LAND SURVEYORS
RD#1 BOX 659
SHAMOKIN, PA. 17872