
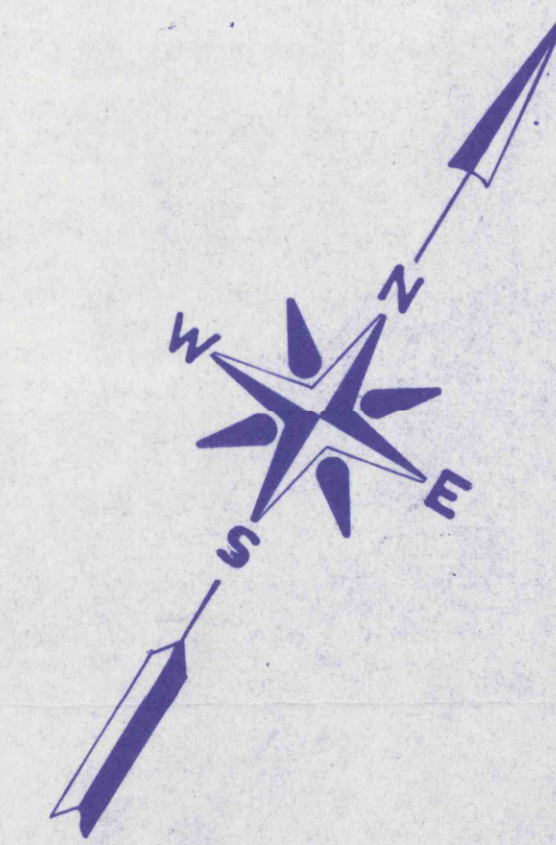



TREMONT TWP.

SCHUYLKILL COUNTY

JOHN HUBER WARRANT

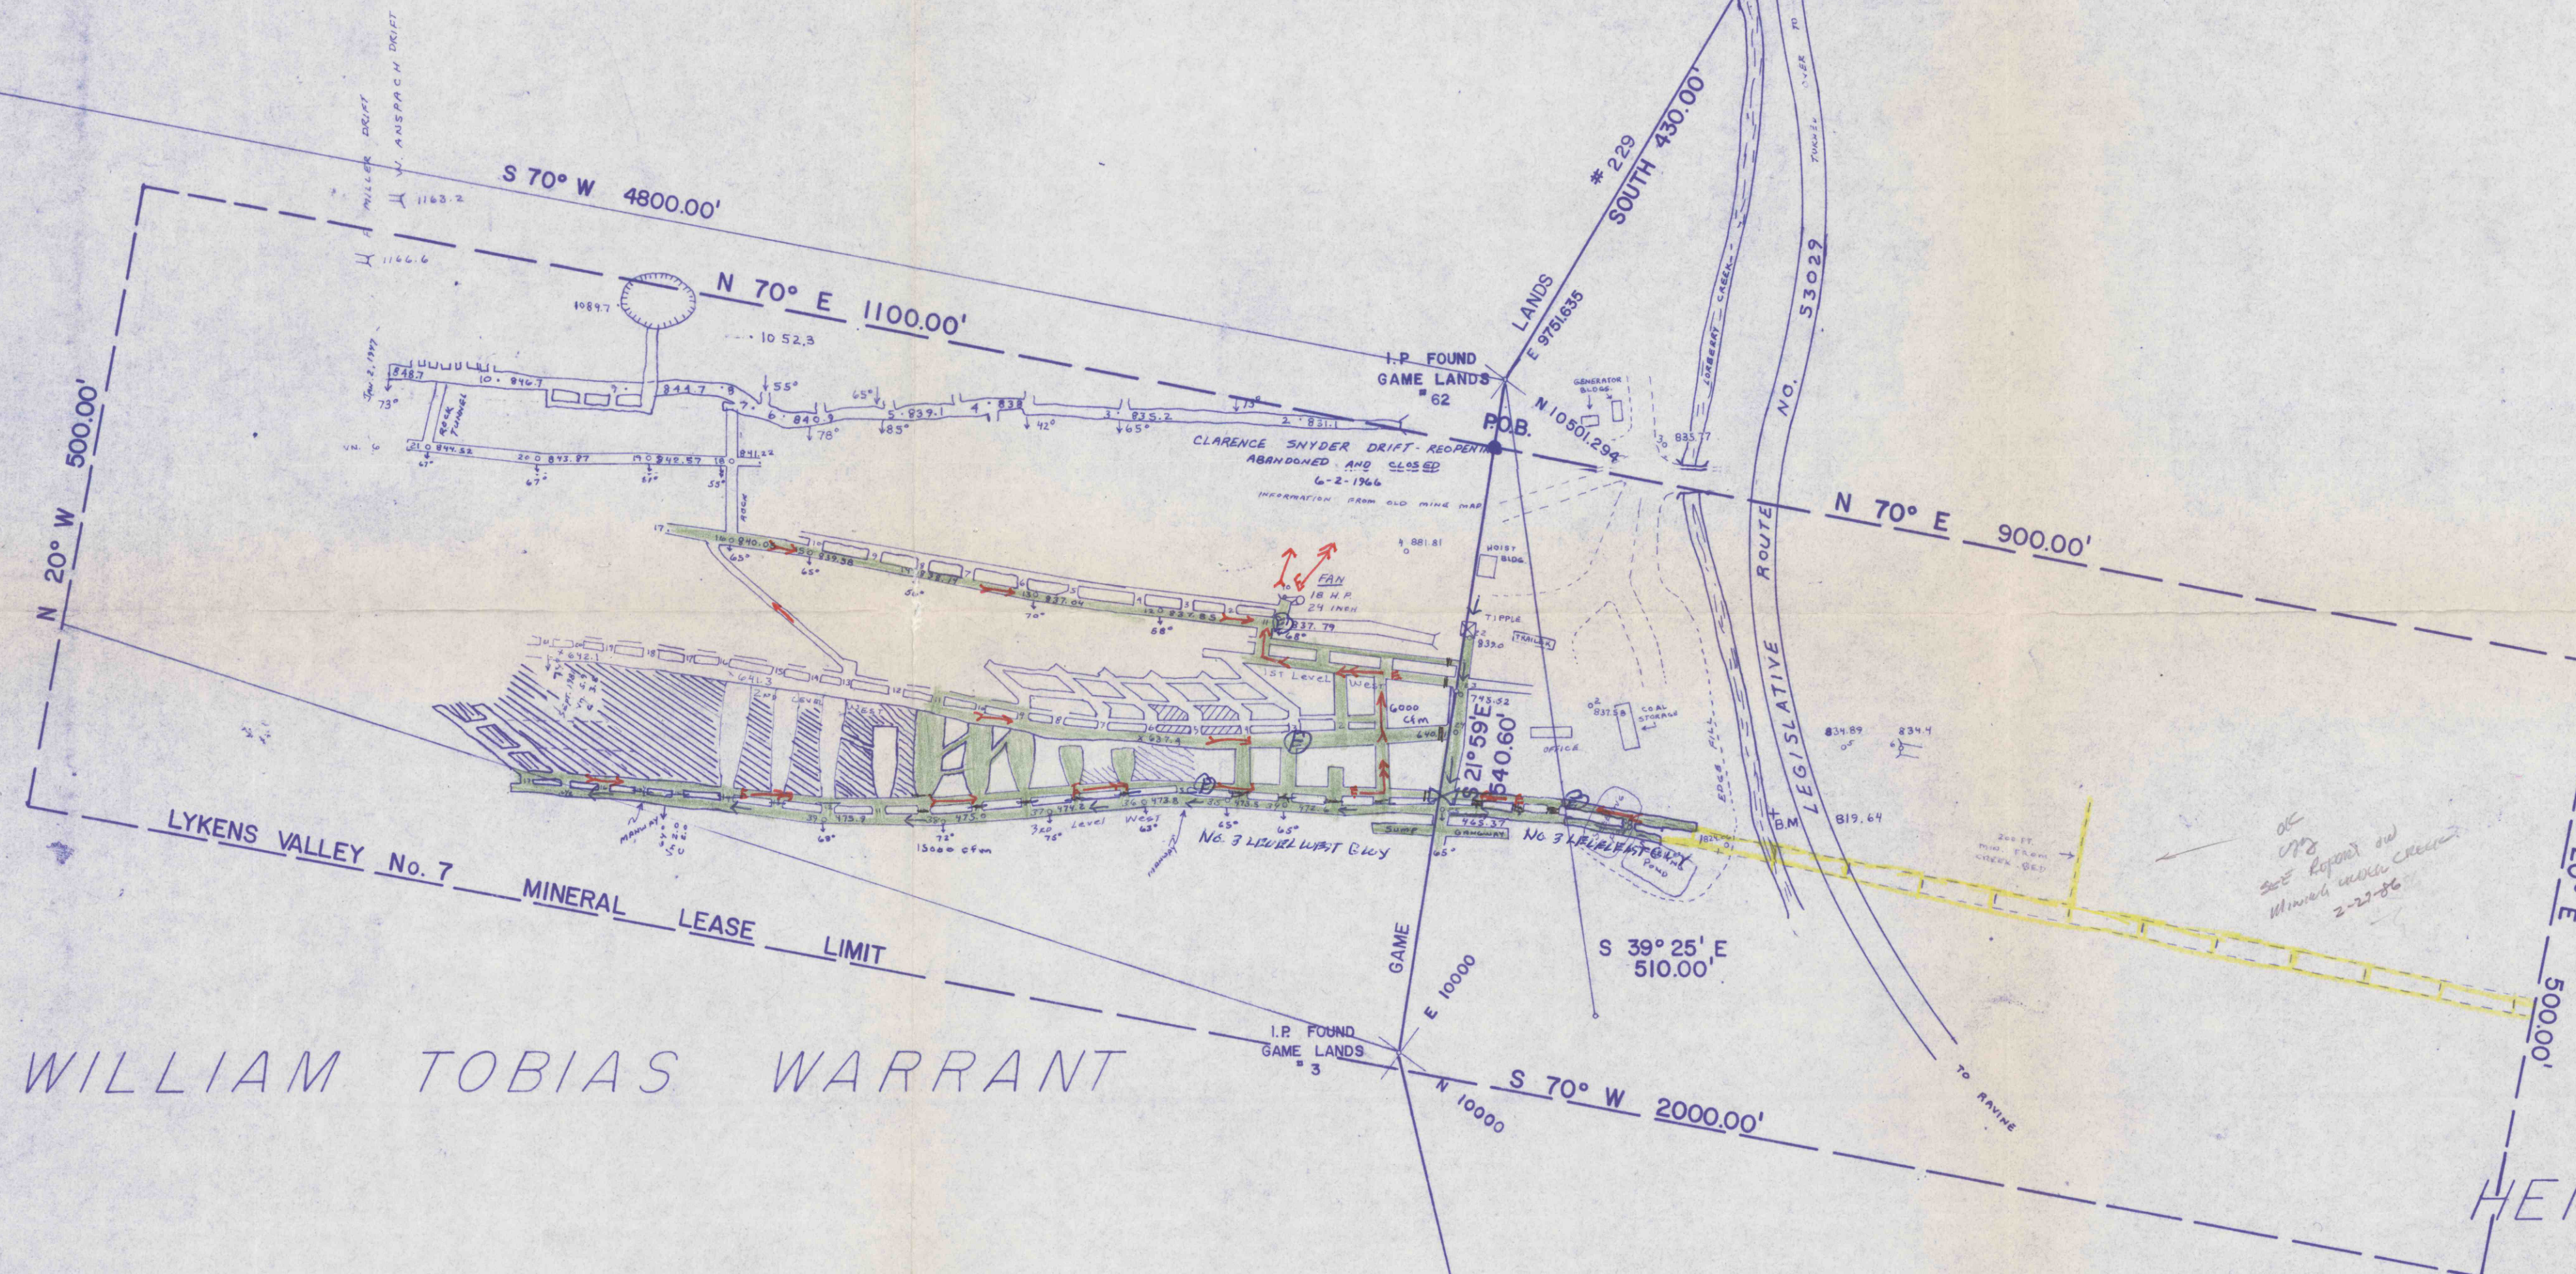

LOCATION MAP

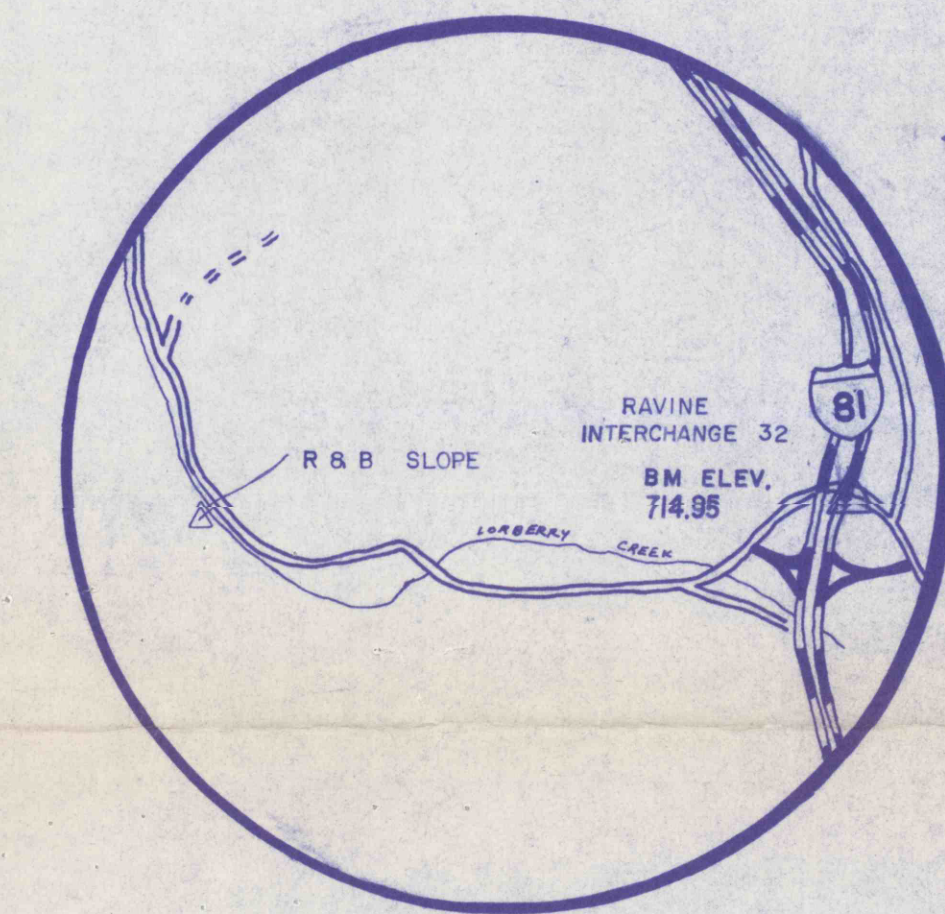

LEGEND


- INTAKE AIR
- RETURN AIR
- ESCAPEWAY
- ACTIVE WORKINGS
- PROPOSED WORKINGS
- OVER CAST

PENNA. GAME COMM.
COMMON LINES


STA.	BRG.	DIST.
G.L. 60 - 61	N 64° 36' E	289.9'
G.L. 61 - 62	S 05° 22' E	428.2'
G.L. 62 - 3	S 27° 21' E	540.6'
G.L. 3 - 4	S 49° 00' E	1600.0'

I, the undersigned, hereby certify that this map is correct and shows all the information, to the best of my knowledge and belief, required by the mining laws of this state, and covers the period ending: September 5, 1986

Signed: Steven E. Dziuban

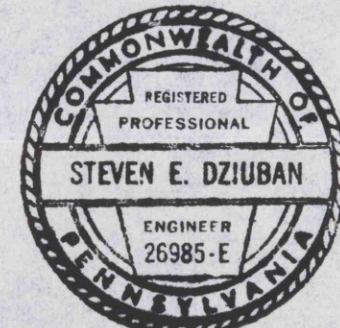

SCALE : 0 100 200 300 400

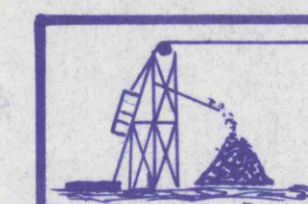

BARNHART COAL CO.

R & B SLOPE
LYKENS VALLEY No. 7
I.D. No. 36-05593
RD. 1 BOX 104
WILLIAMSTOWN, PA. 17098

SCALE 1" = 100'

DATE September 5, 1986

DRAWN BY DAVID N. HOFFERBACH

I.D. 36-05593