


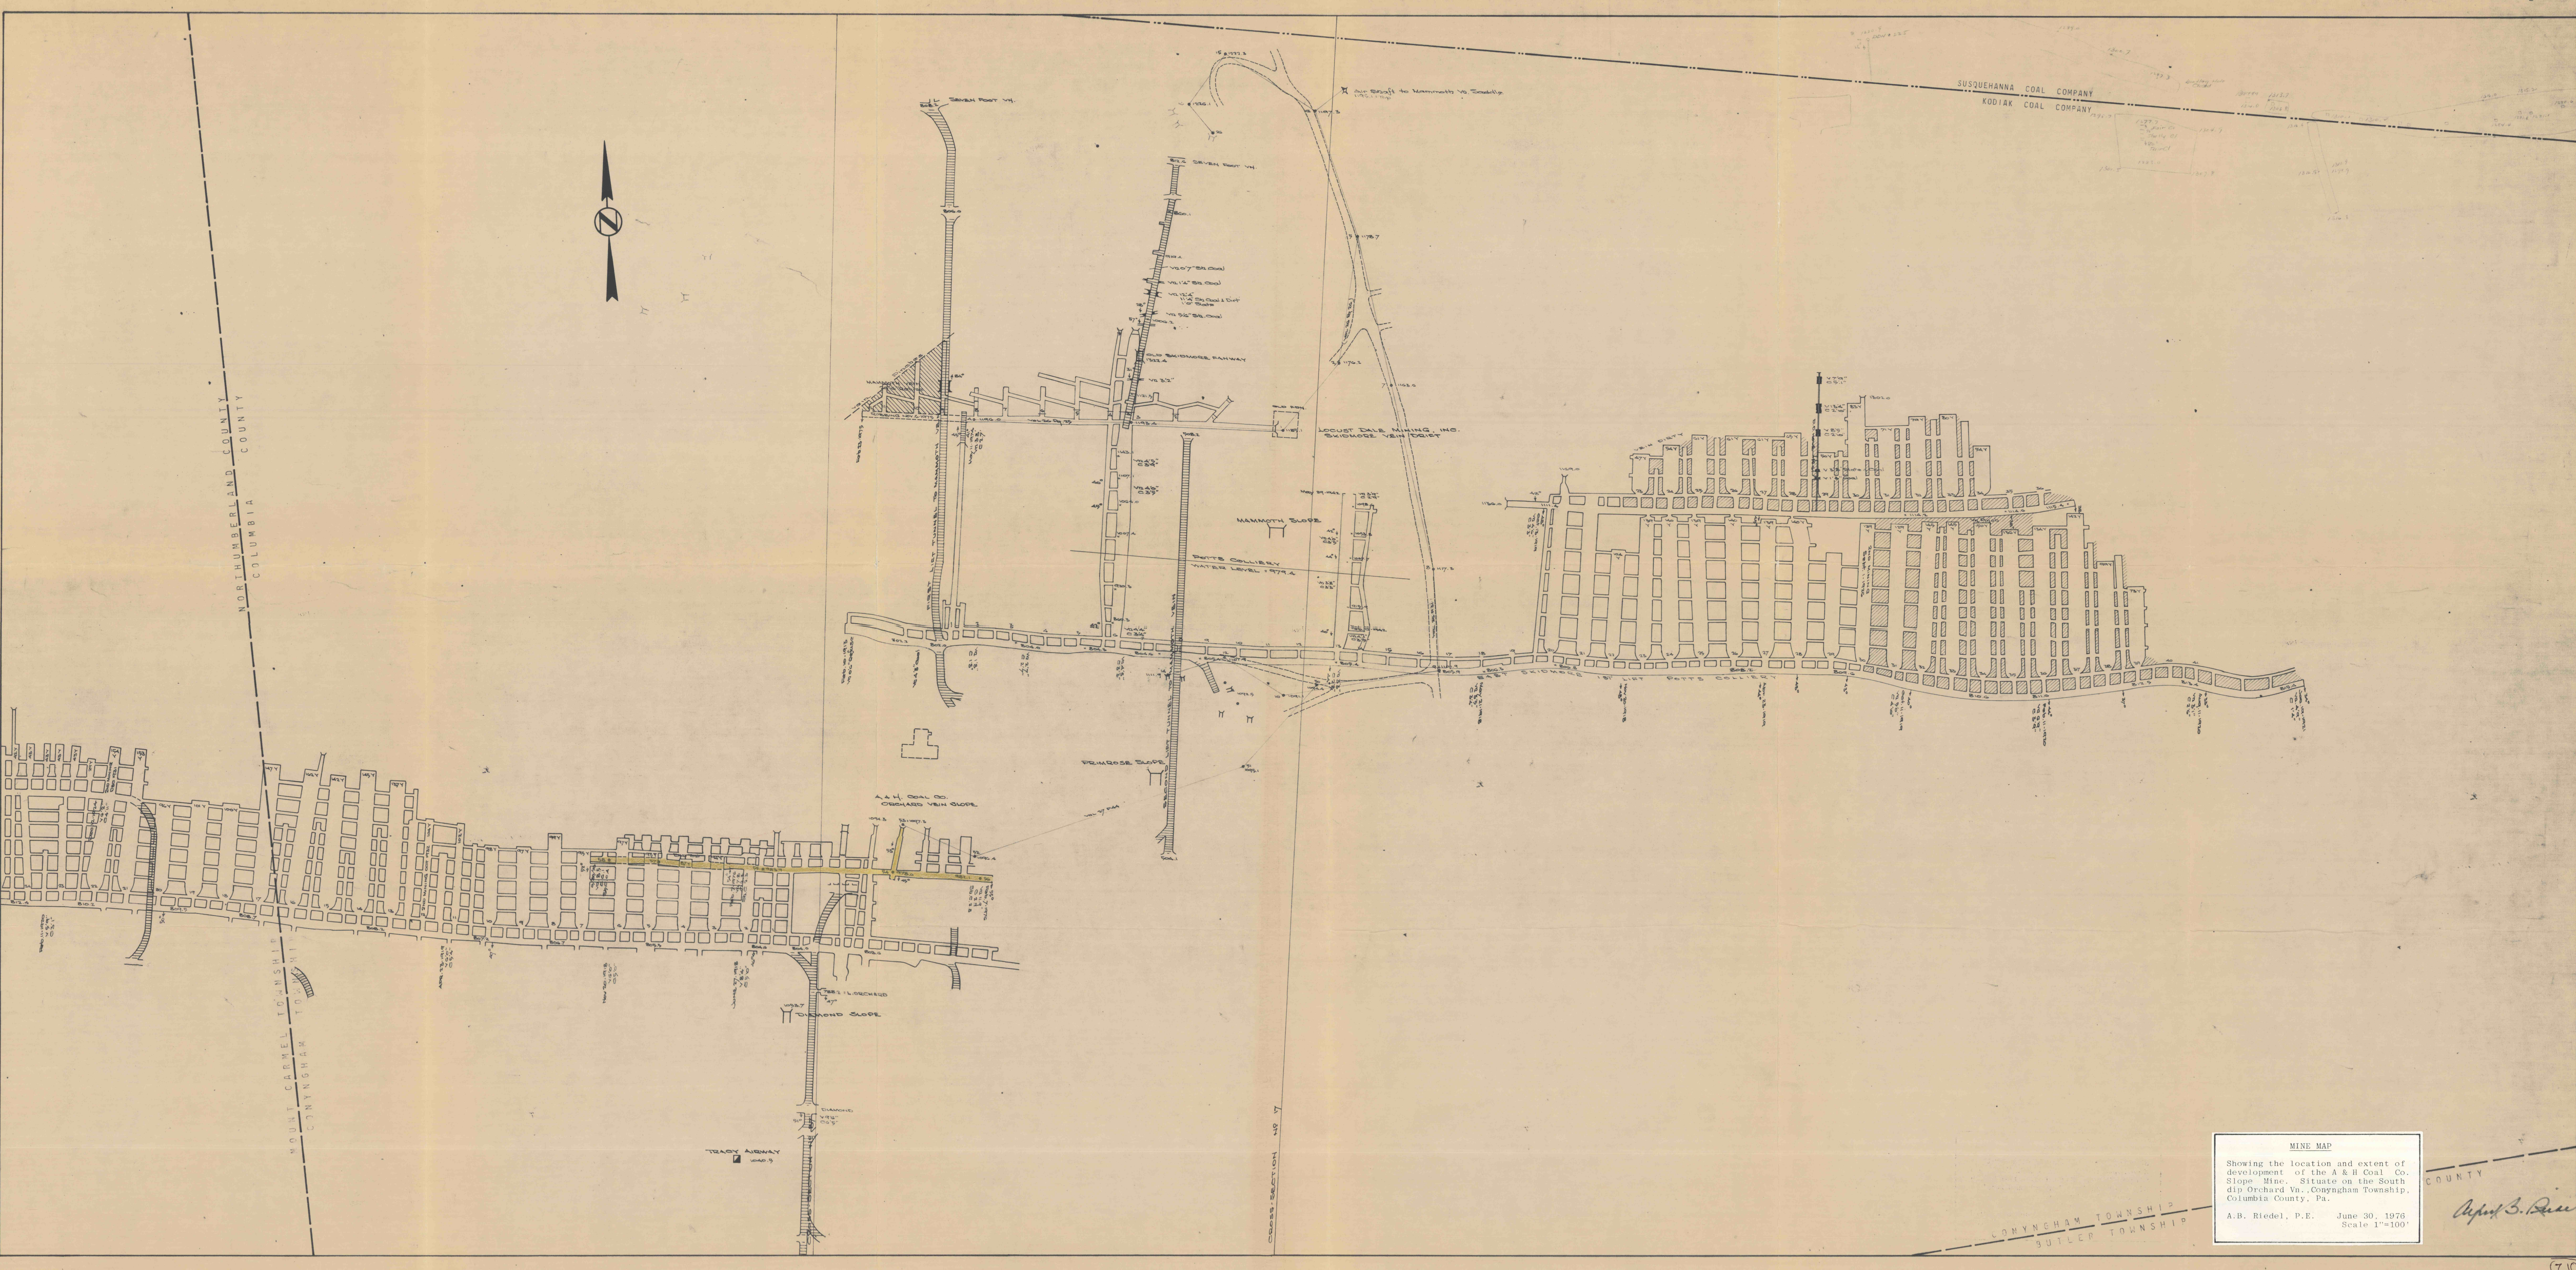

MINE MAP
Showing the location and extent of
development of the A & H Coal Co.
Slope Mine. Situate on the South
dip Orchard Vn., Conyngham Township,
Columbia County, Pa.
A.B. Riedel, P.E. June 30, 1976
Scale 1"=100'

COUNTY
A.B. Riedel