


NORTHUMBERLAND COUNTY
COLUMBIA COUNTY

COUNTY LINE

BURN RITE
COAL CO.

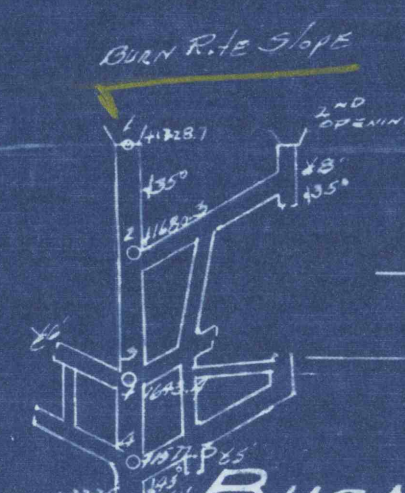

MINE WORKINGS
IN THE
BUCK MTN VEIN UNDERLAP
AT
MIDVALLEY COLLIERY
ON
NATHANIEL BROWN TRACT
OF THE
COLONIAL COLLIERY LANDS

SCALE 1" = 100'
JAN. 16-1917

C O L O N I A L C O A L L I E R Y

N A T H A N I E L B R O W N

SHAFT NO. 23
BARREN
SHAFT NO. 22
BARREN

