



1000' Lease Area

1000' Lease Area

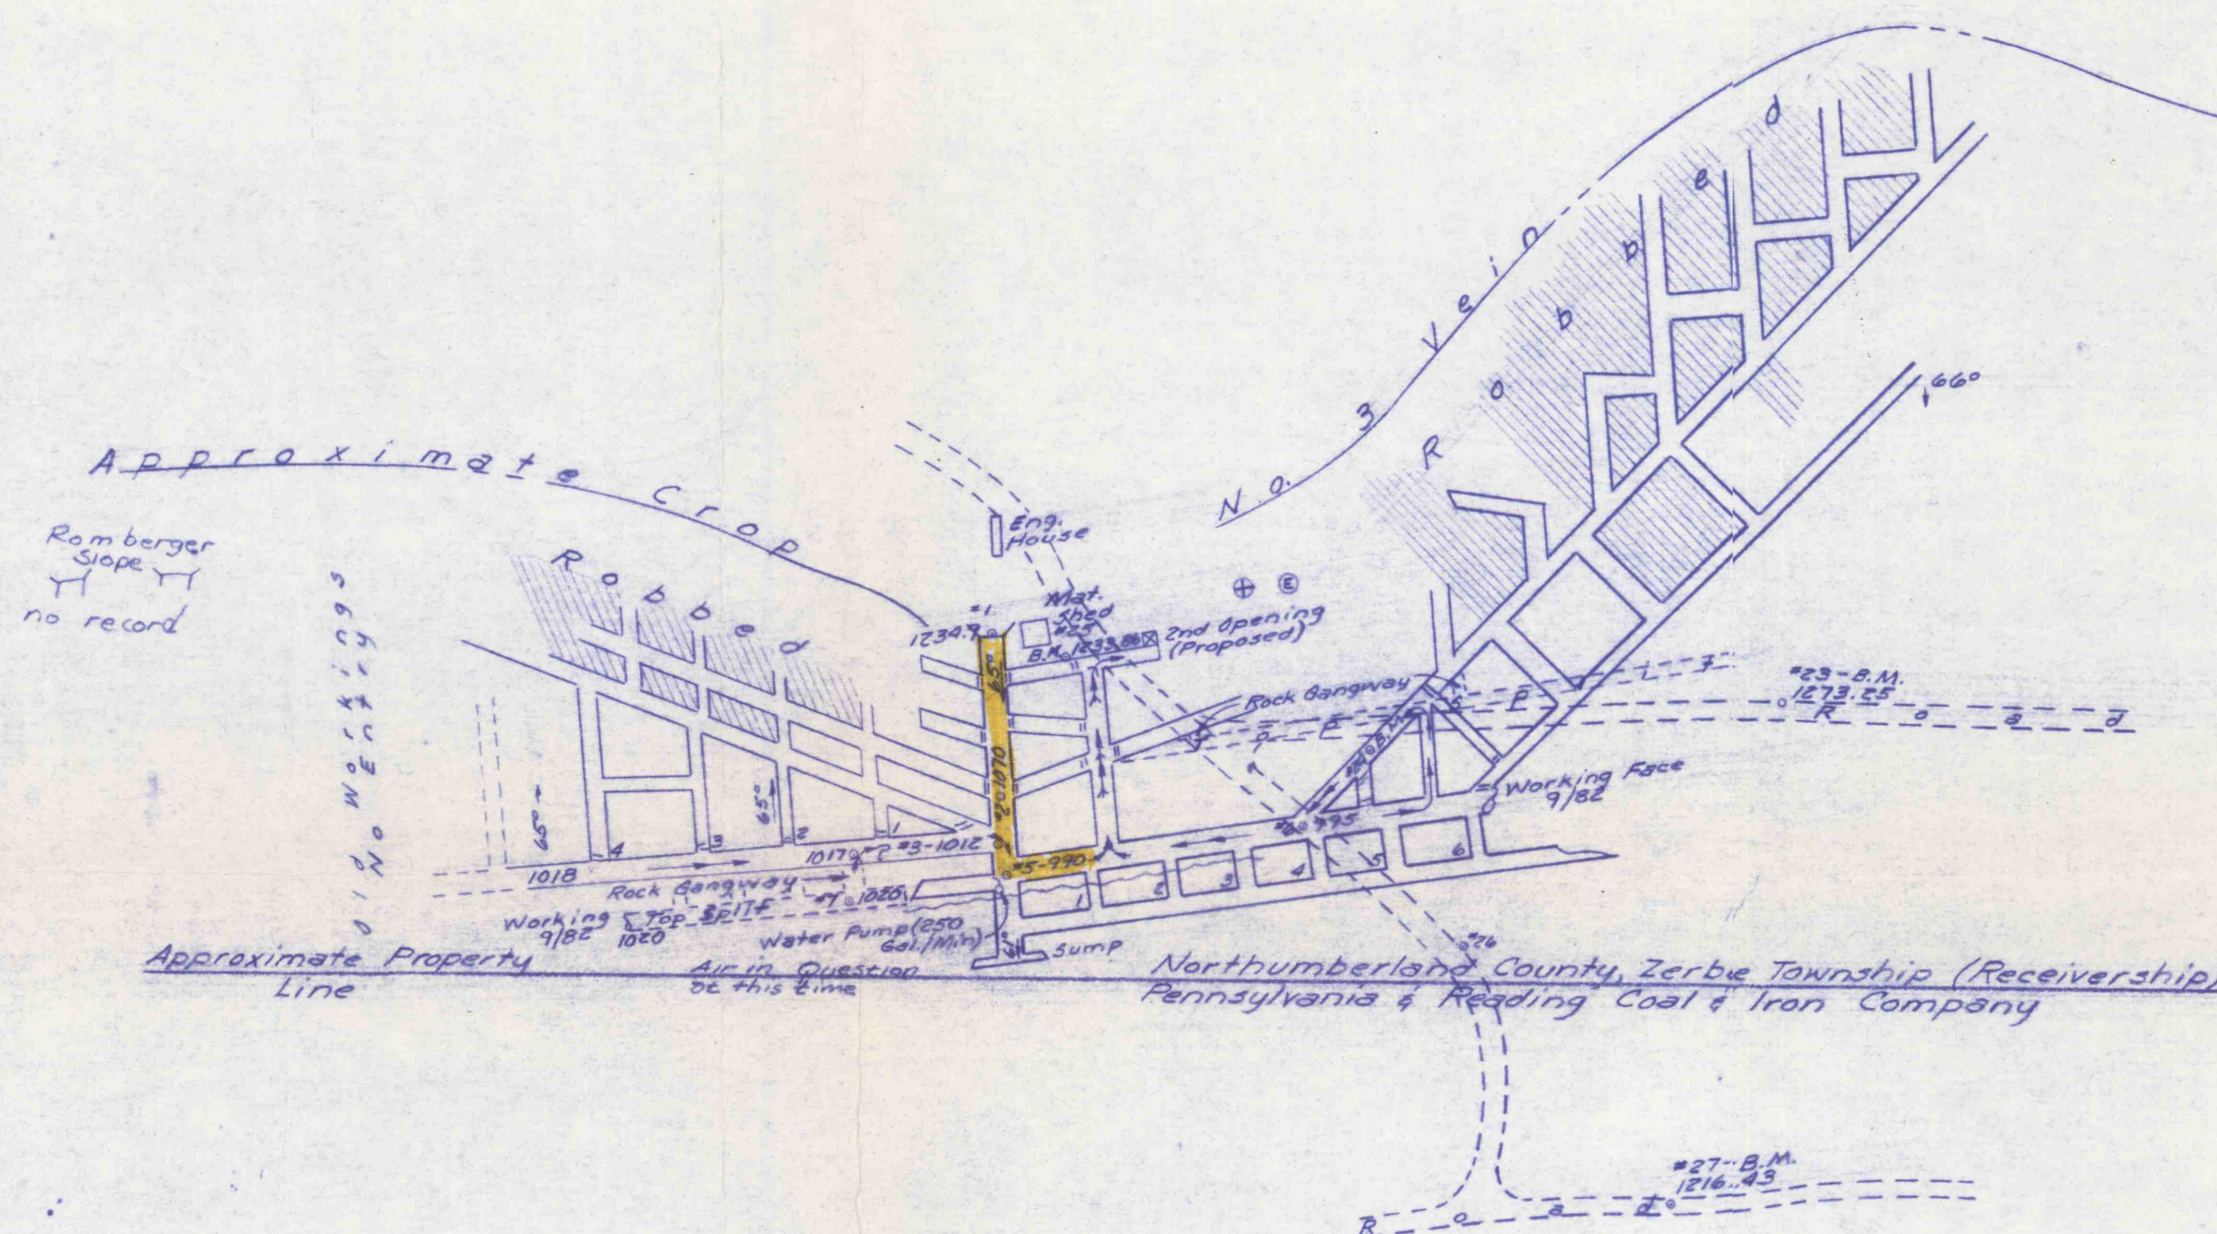

Plan View

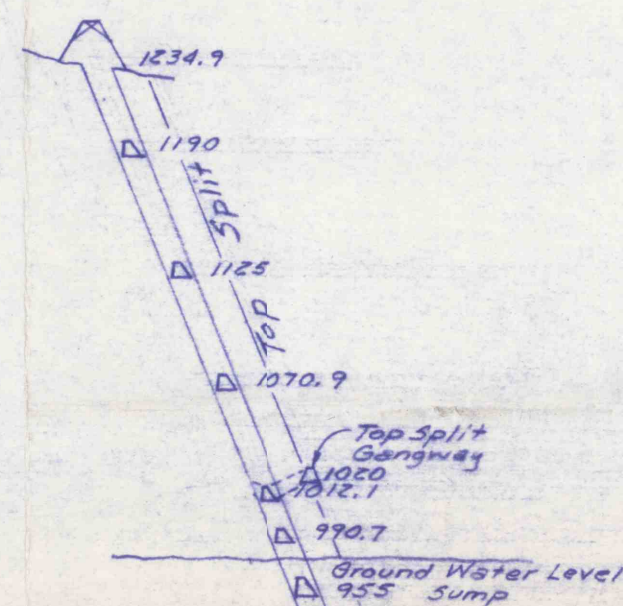

Mine Pool Elevation
868.04 - 8/82

Cross Section of North Franklin
Working (Looking East)

100 50 0 50 100
Graphic Scale

LEGEND

- ⊕ - Escapeway
- ⊕ - Fan
- Air Intake ← Exhaust
- Permanent Stopping
- Temporary Stopping

Notes

- 1- Tie with K.D. Lady Luck #1412.
- 2- Vert with P.R.C. & USC-65
- 3- Coal posted at Mine

WAGNER
group

WAGNER ASSOCIATES, INC.

Engineers • Architects • Planners • Surveyors

312 Mauch Chunk Street, Pottsville, PA. 17801

Situate in the Township of Zerbe, County of Northumberland, Commonwealth of Pennsylvania

Hard Times Coal Company

ID-36-05446

Vein No. 3, "D" Bed

Pottsville Formation

ISSUE DATE:

SCALE: 1"=100'

DWG. BY: AKulp

PROJ. MGR: S.C.B.

DATE: 10/25/82

CHKD. BY: S.C.B.

DEPT. HD: C.W.S.

ORDER NO: 5120-A

DWG. NO:

92144