


SHARP MOUNTAIN TRACT

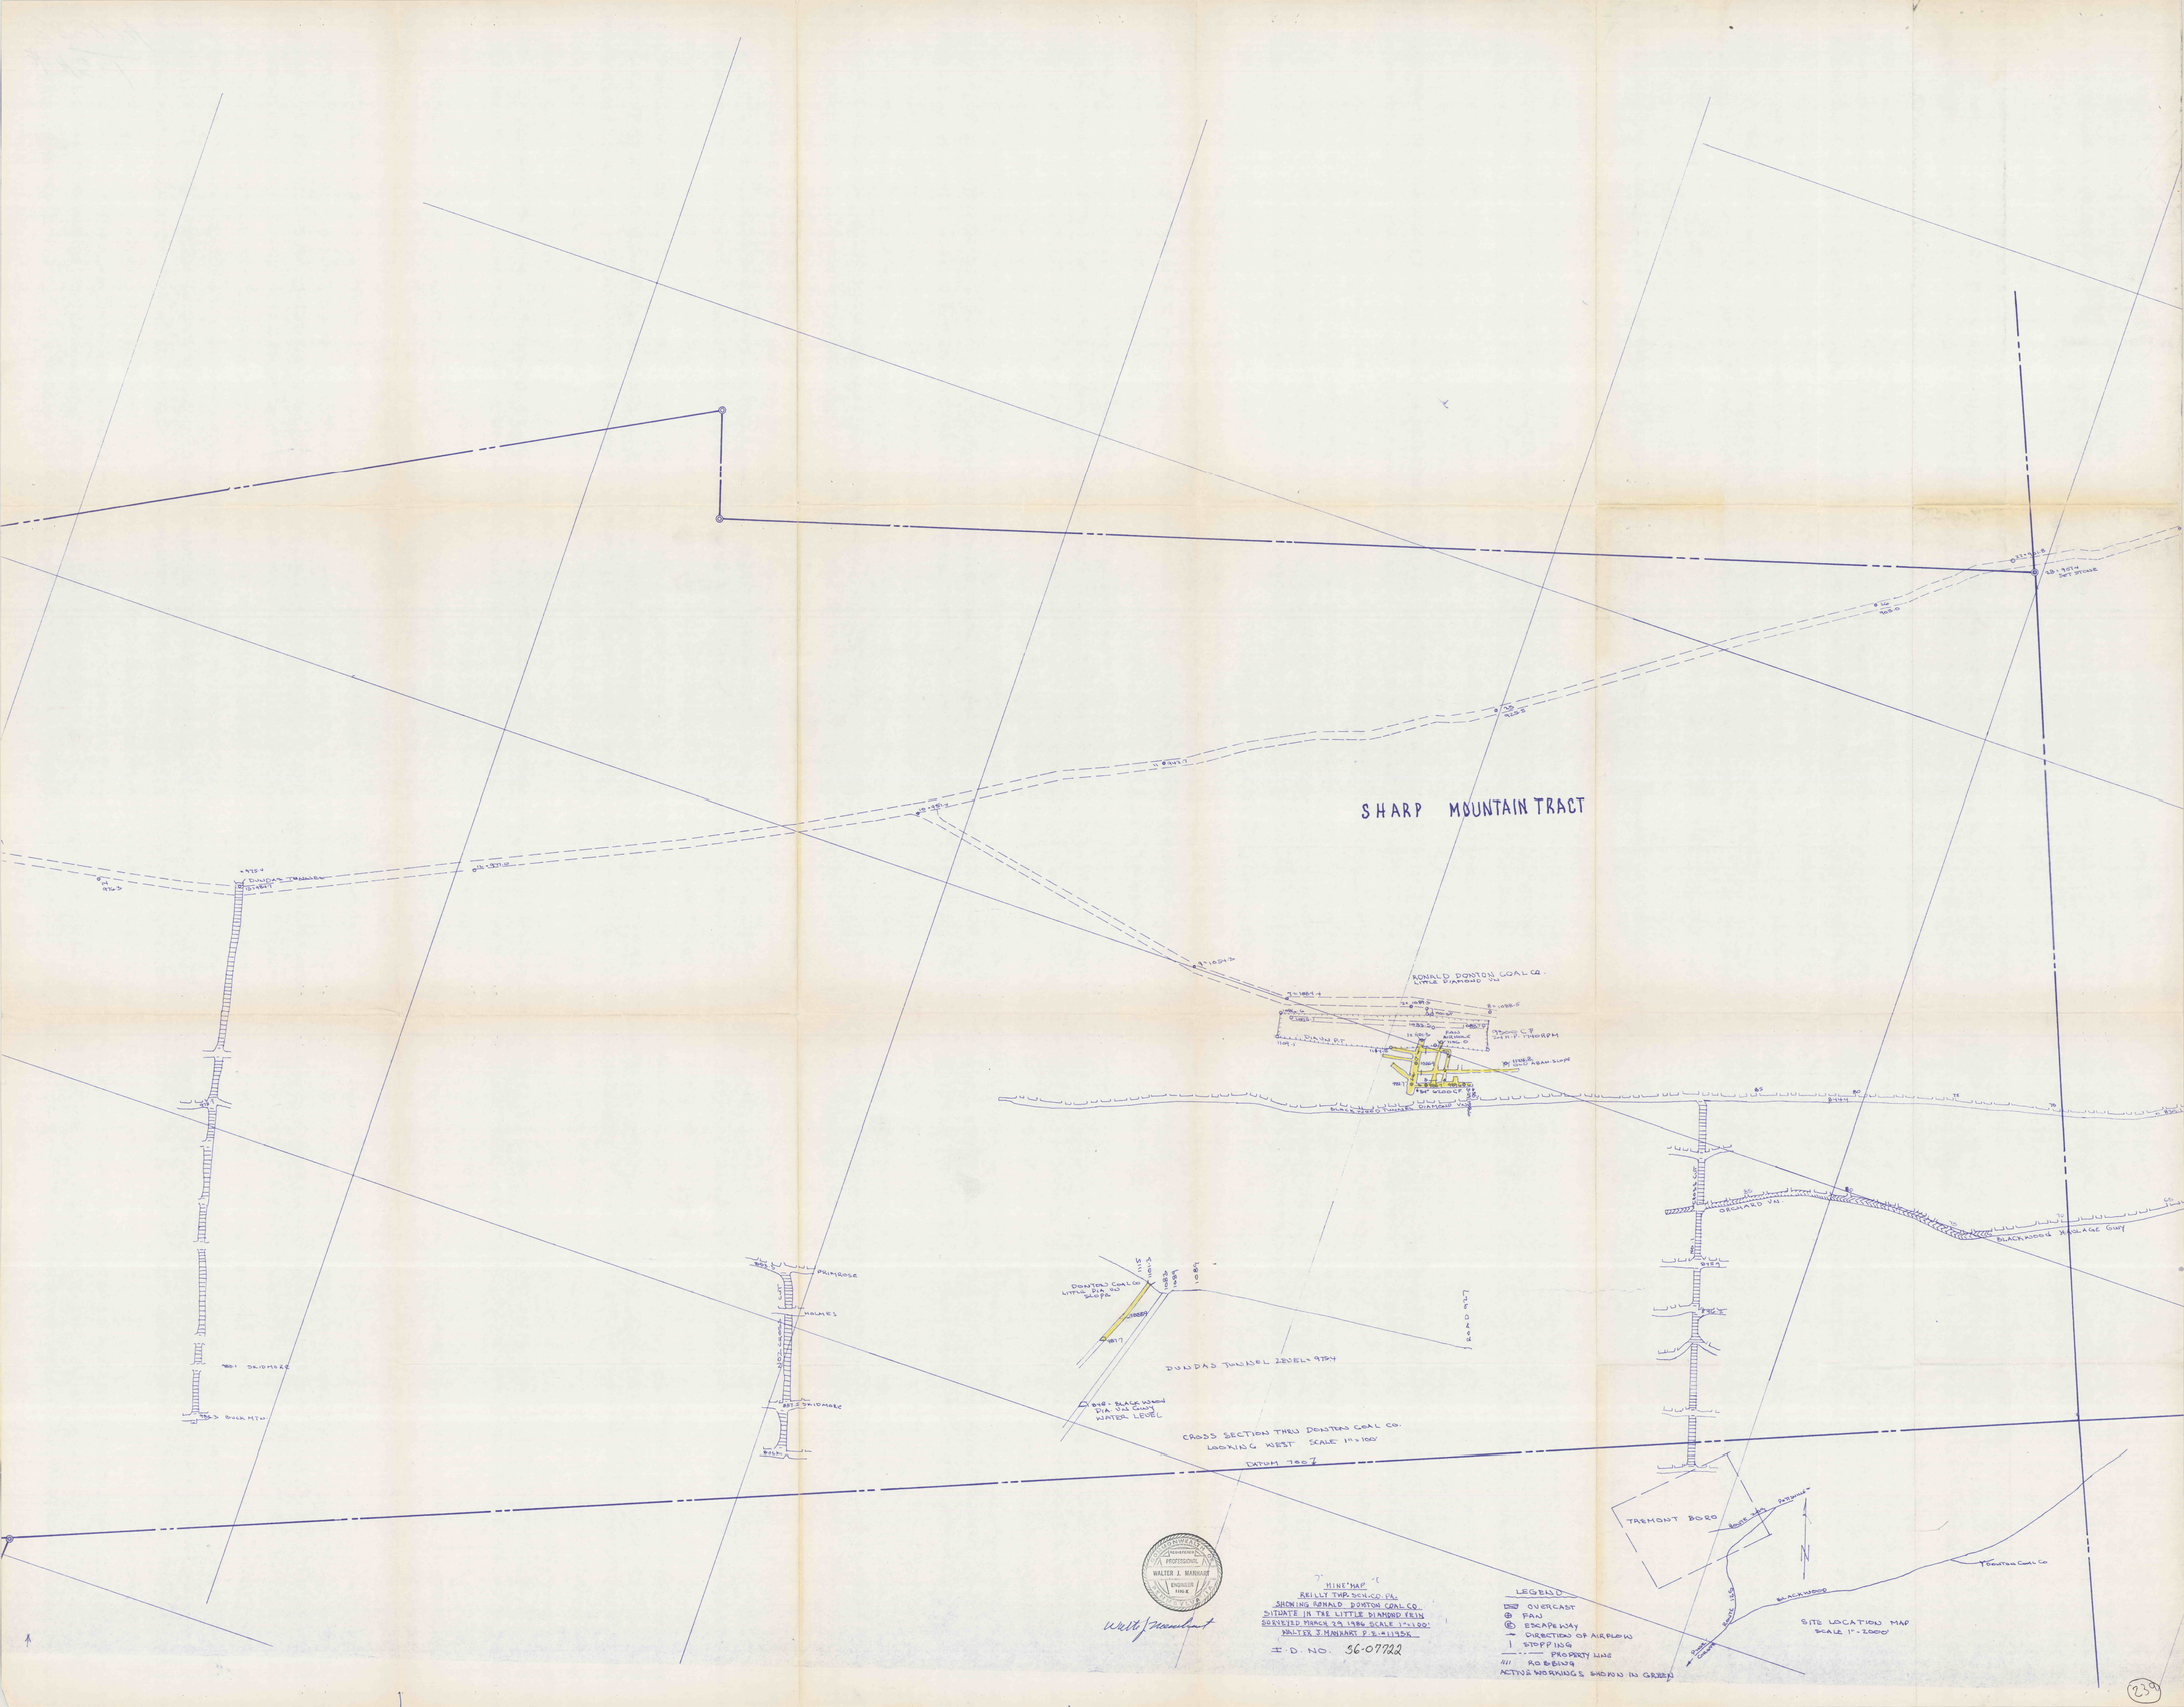


I.D. NO. 36-07722

LEGEND
OVERCAST
FAN
ESCAPE WAY
DIRECTION OF AIRFLOW
STOPPING
PROPERTY LINE
ROAD BEING
ACTIVE WORKINGS SHOWN IN GREEN

SITE LOCATION MAP
SCALE 1"=2000'