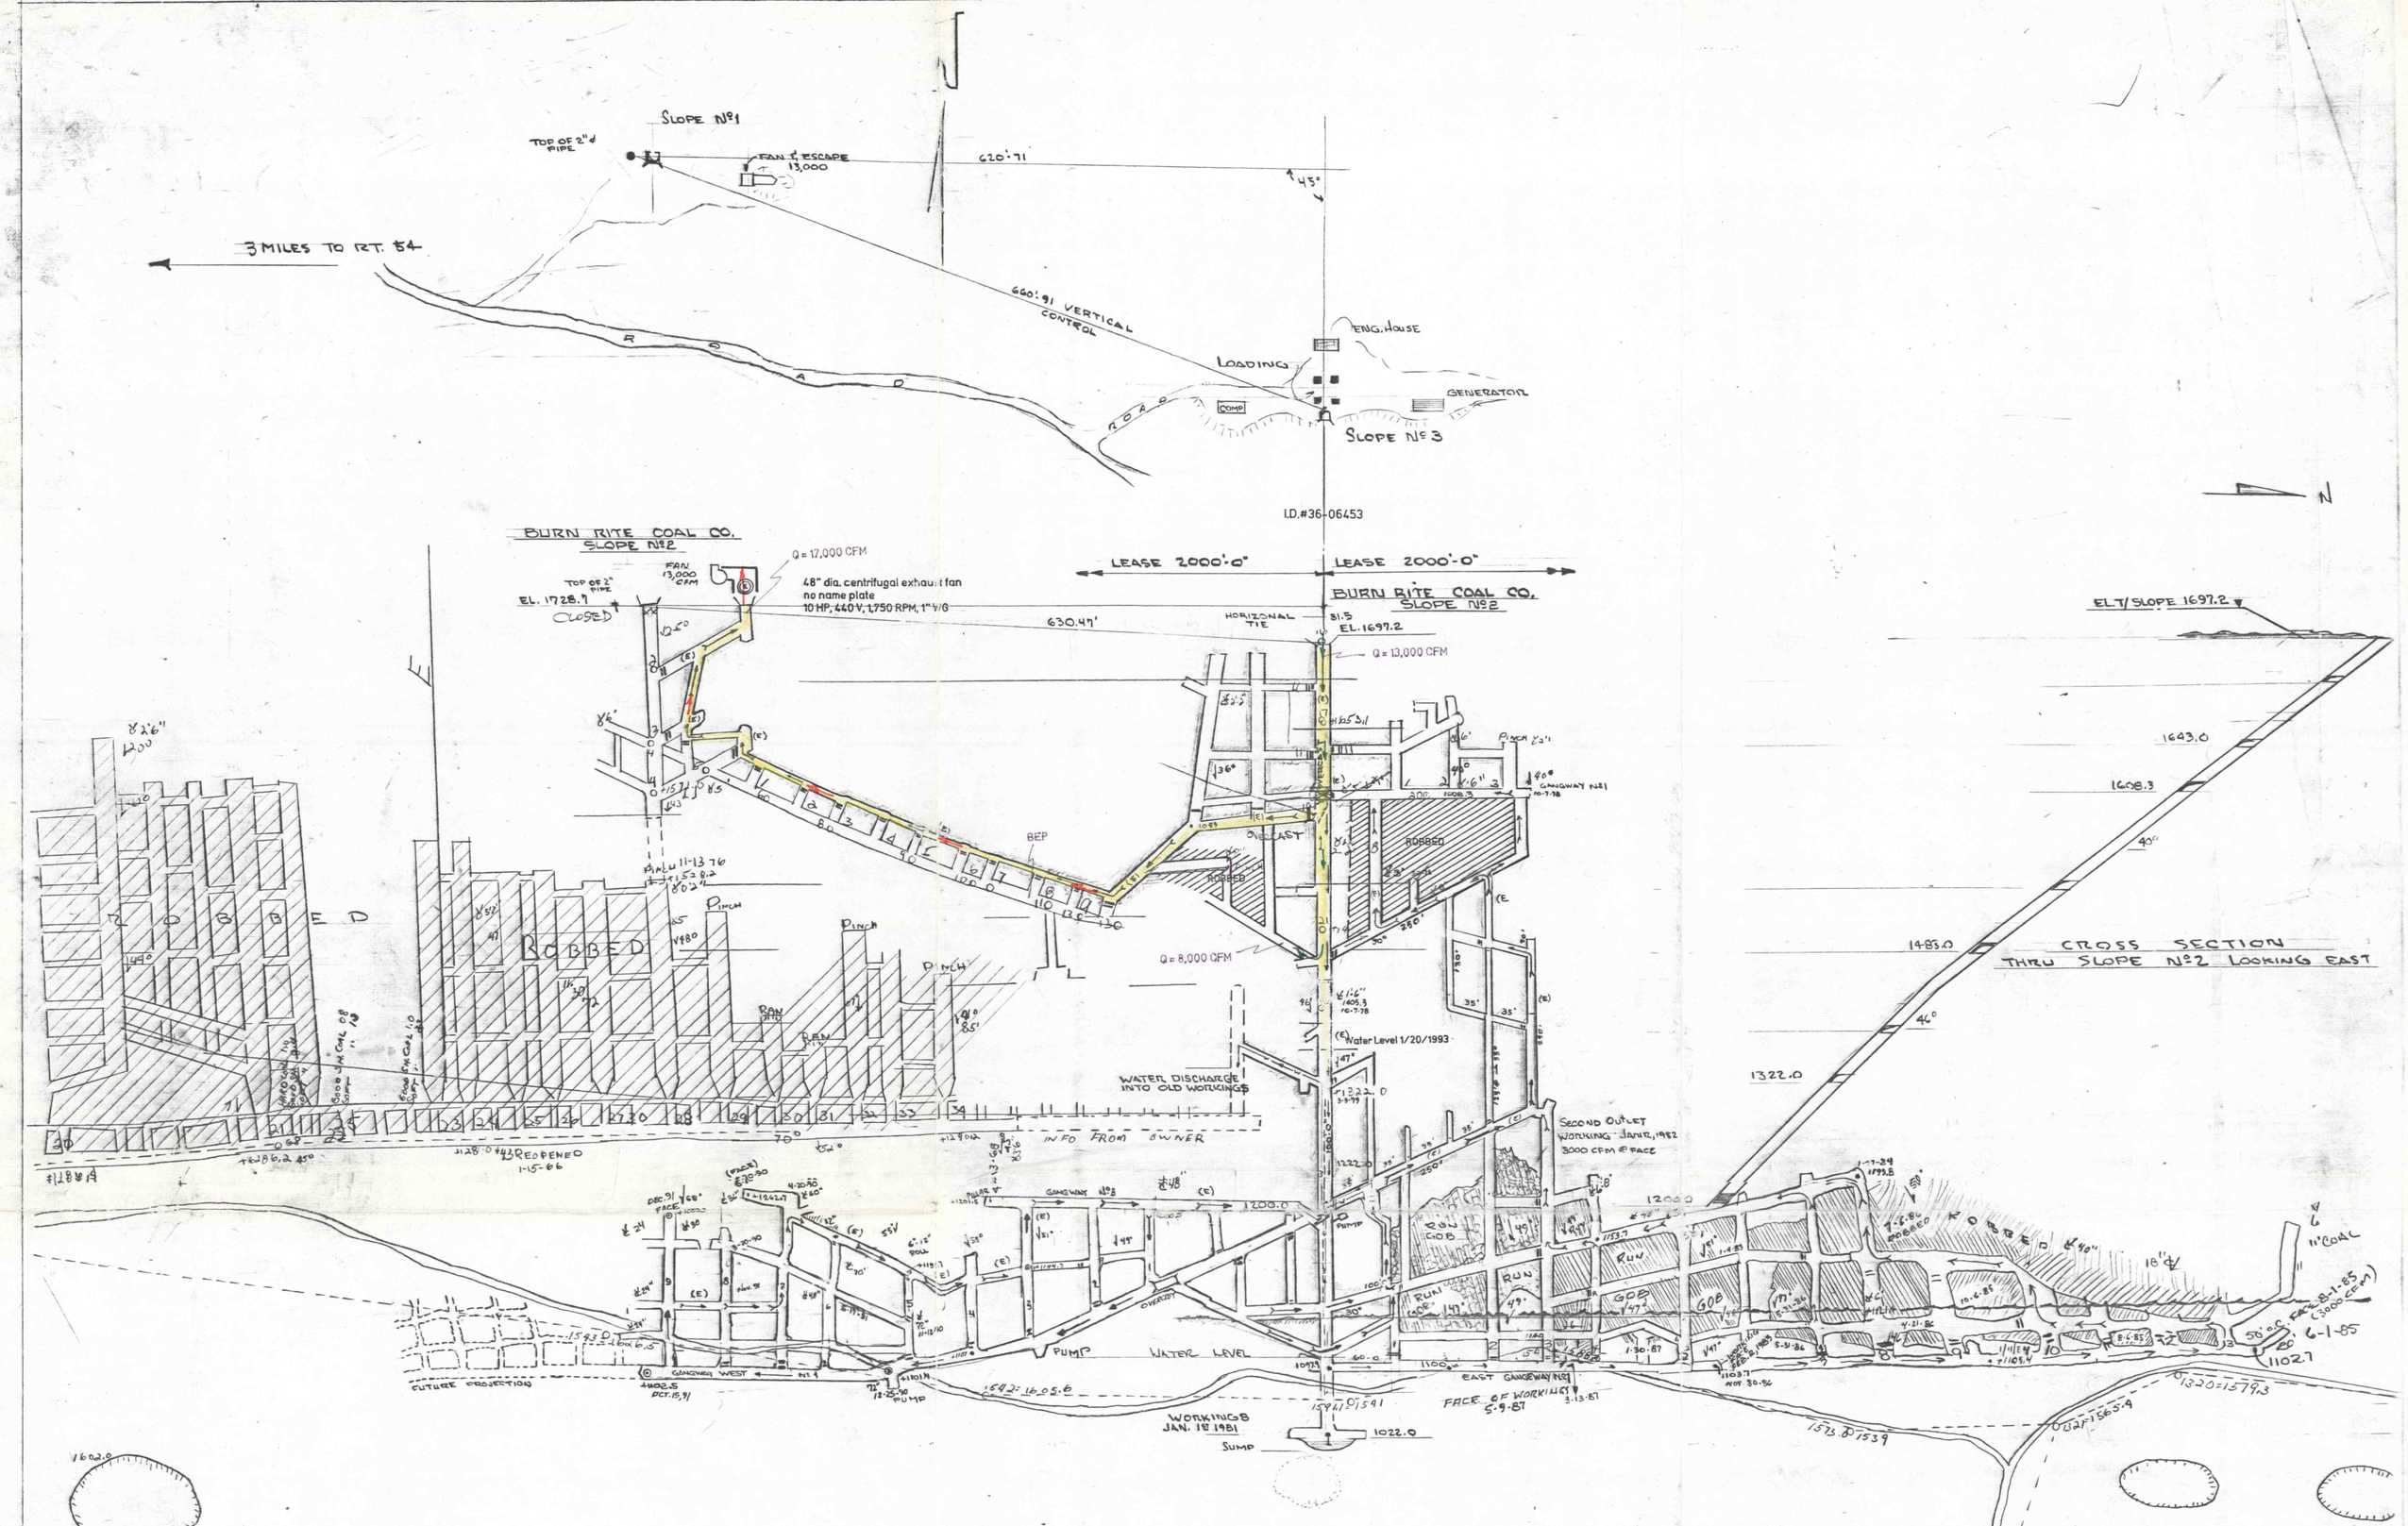

NOTE: DUPLICATED MAP BY TRUMBO\COVELSKI

Alfred B. Riedel

MINE MAP

Showing the location and extent of development (as reported by Operator), of mine workings of the Burnrite Coal Company. Situate on the south dip Lykens vein, Wilburton Township, Columbia County.

A.B. Riedel, P.E. — January 20, 1993

UPDATED Sept 13, 1993 — Scale 1"=100'

VENTILATION SYMBOLS (where appropriate)

- (F) Main Fan
- (A) Auxiliary Fan
- Air Flow-Intake (Green)
- Air Flow-Return (Red)
- Stopping
- Air Bridge
- R Regulator
- Man Door
- V Velocity, fpm
- Q Quantity, cfm
- WG Water Gauge, in
- (E) Escapeway
- BEP Bleeder Evaluation Point
- Pillar Removal or Robbing
- Mine Seal
- Active Workings (Yellow)
- Curtain or Brattice
- Workings Not Surveyed
- Caved Ground