


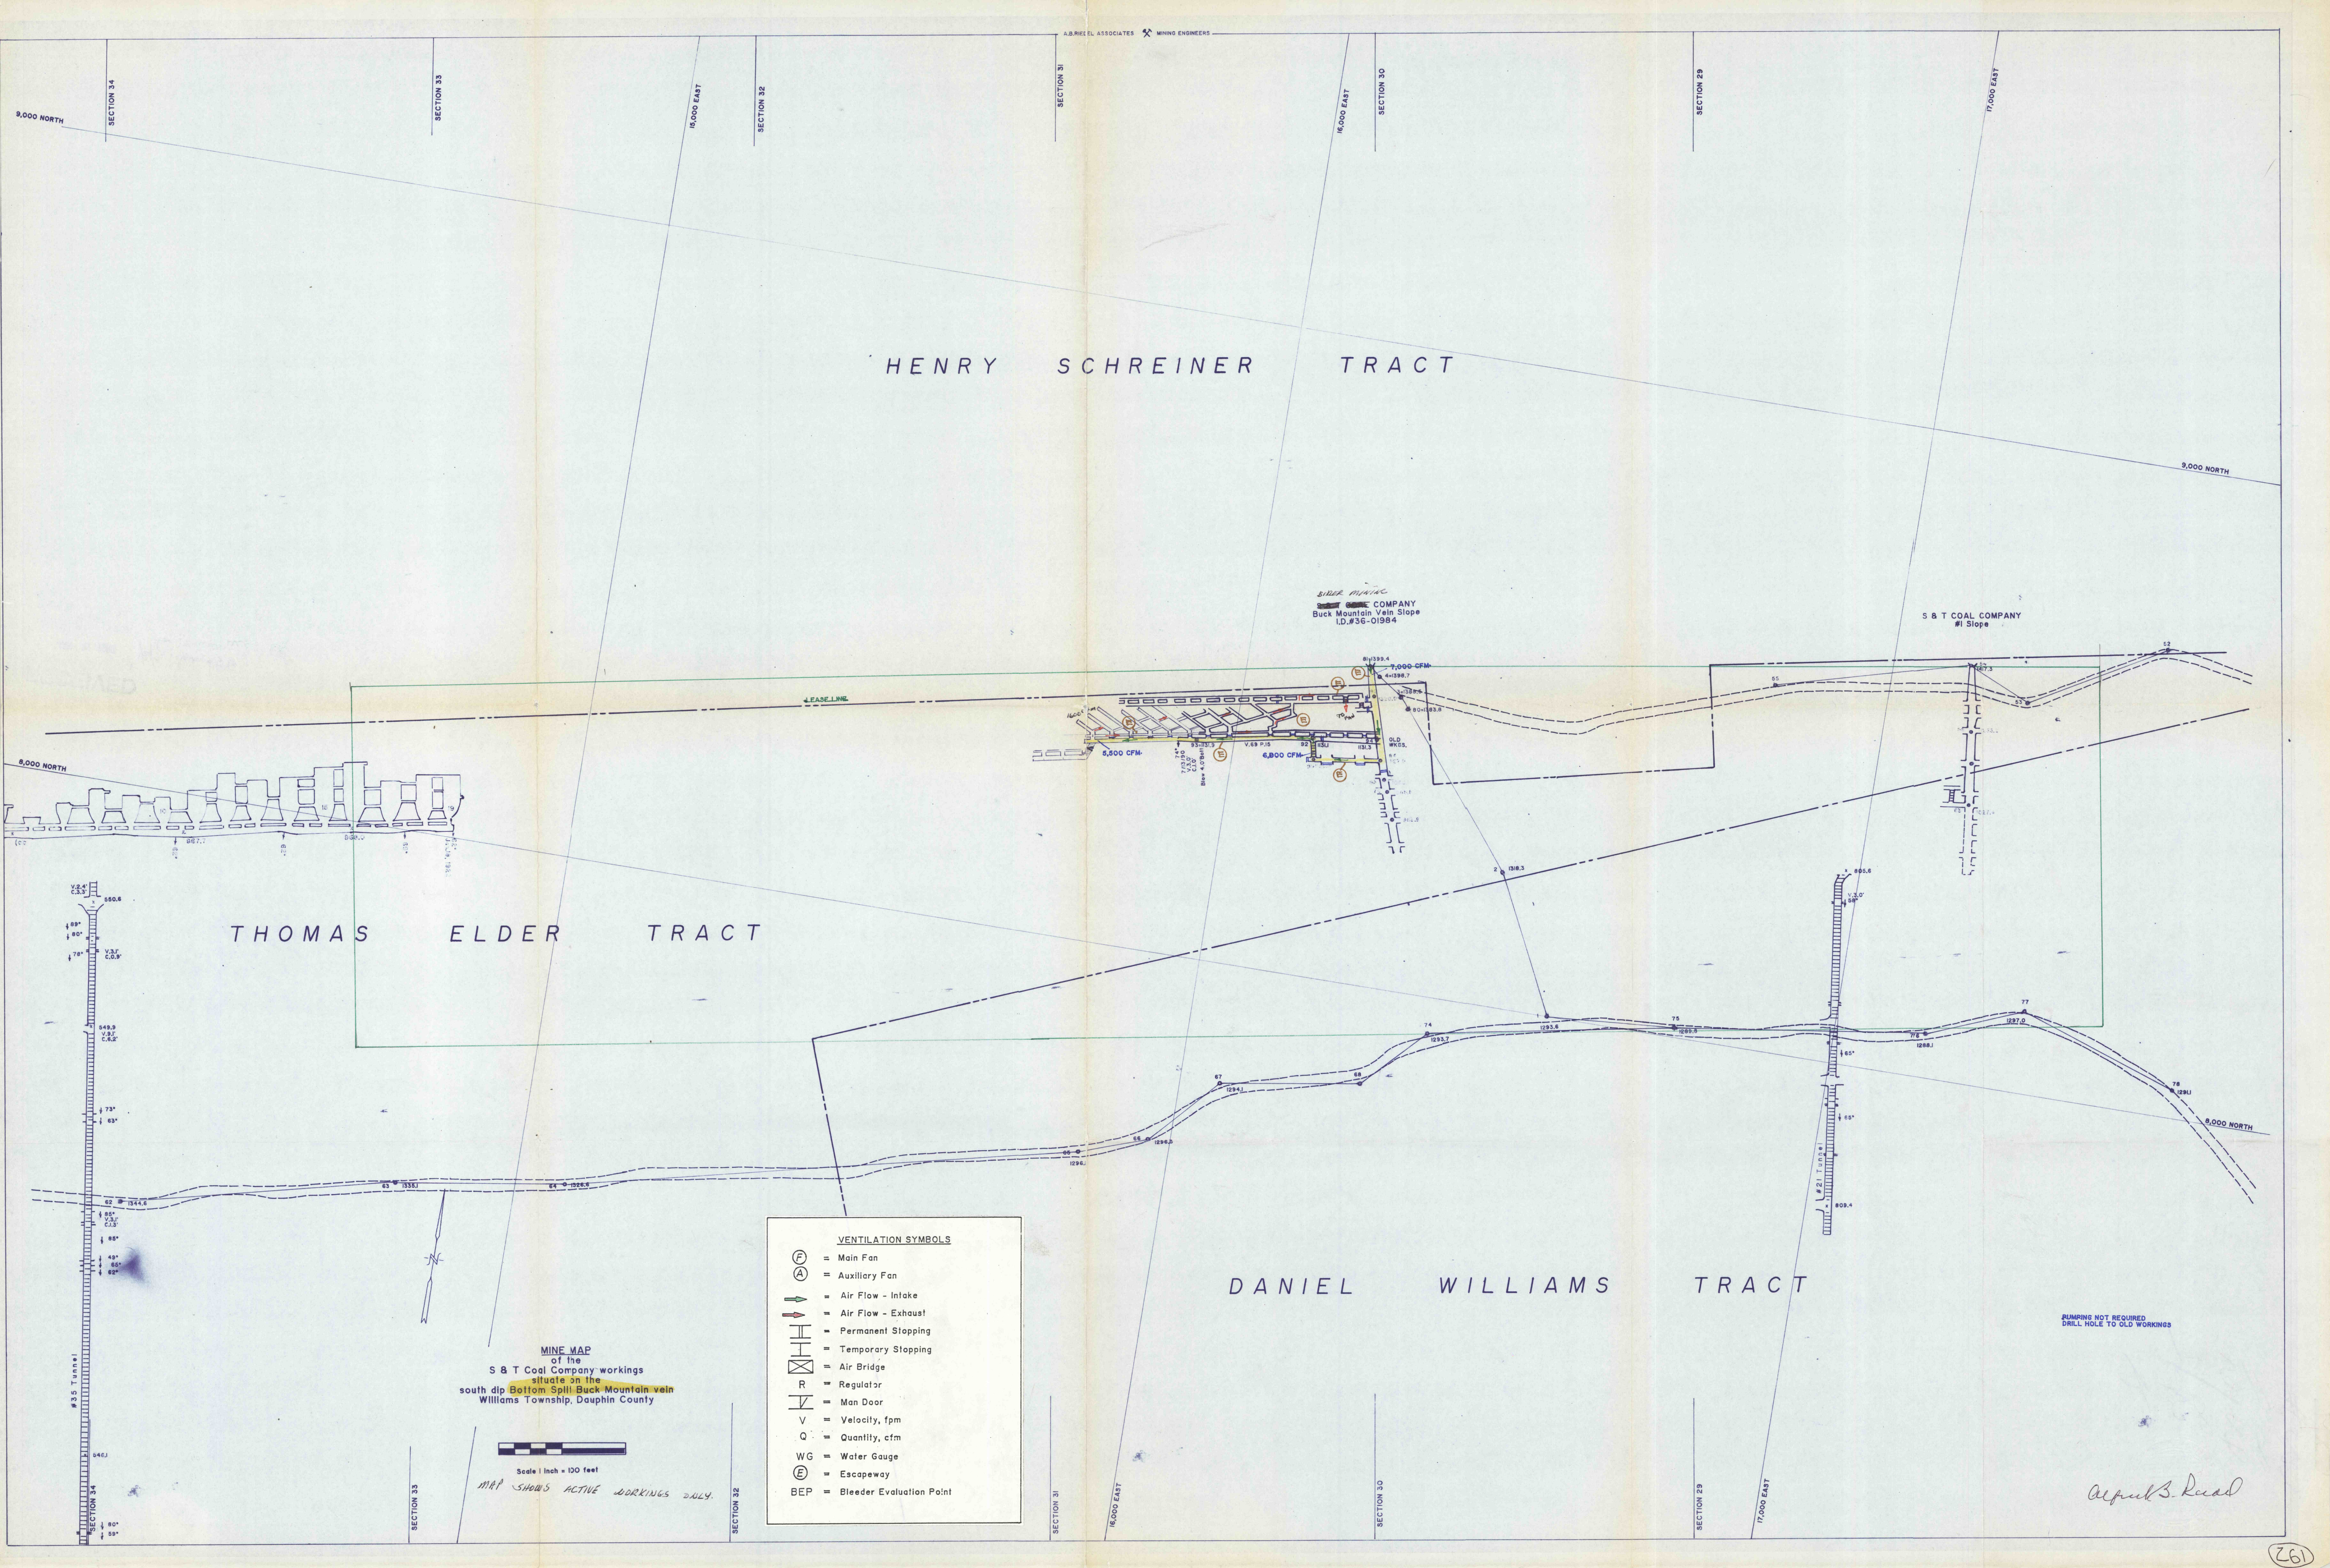

HENRY SCHREINER TRACT

THOMAS ELDER TRACT

DANIEL WILLIAMS TRACT

S & T COAL COMPANY
Buck Mountain Vein Slope
I.D.#36-01984

S & T COAL COMPANY
#1 Slope

VENTILATION SYMBOLS

- (F) = Main Fan
- (A) = Auxiliary Fan
- = Air Flow - Intake
- ← = Air Flow - Exhaust
- = Permanent Stopping
- - - = Temporary Stopping
- ⊠ = Air Bridge
- R = Regulator
- ⌢ = Man Door
- V = Velocity, fpm
- Q = Quantity, cfm
- WG = Water Gauge
- (E) = Escapeway
- BEP = Bleeder Evaluation Point

MINE MAP
of the
S & T Coal Company workings
situate on the
south dip Bottom Split Buck Mountain vein
Williams Township, Dauphin County

Scale 1 inch = 100 feet

MAP SHOWS ACTIVE WORKINGS ONLY.

RUNNING NOT REQUIRED
DRILL HOLE TO OLD WORKINGS

April B. Reed