


VENTILATION SYMBOLS

- (F) = Main Fan
- (A) = Auxiliary Fan
- = Air Flow - Intake
- ← = Air Flow - Exhaust
- = Permanent Stopping
- - - = Temporary Stopping
- ⊠ = Air Bridge
- R = Regulator
- ⌋ = Man Door
- V = Velocity, fpm
- Q = Quantity, cfm
- WG = Water Gauge
- (E) = Escapeway
- BEP = Bleeder Evaluation Point

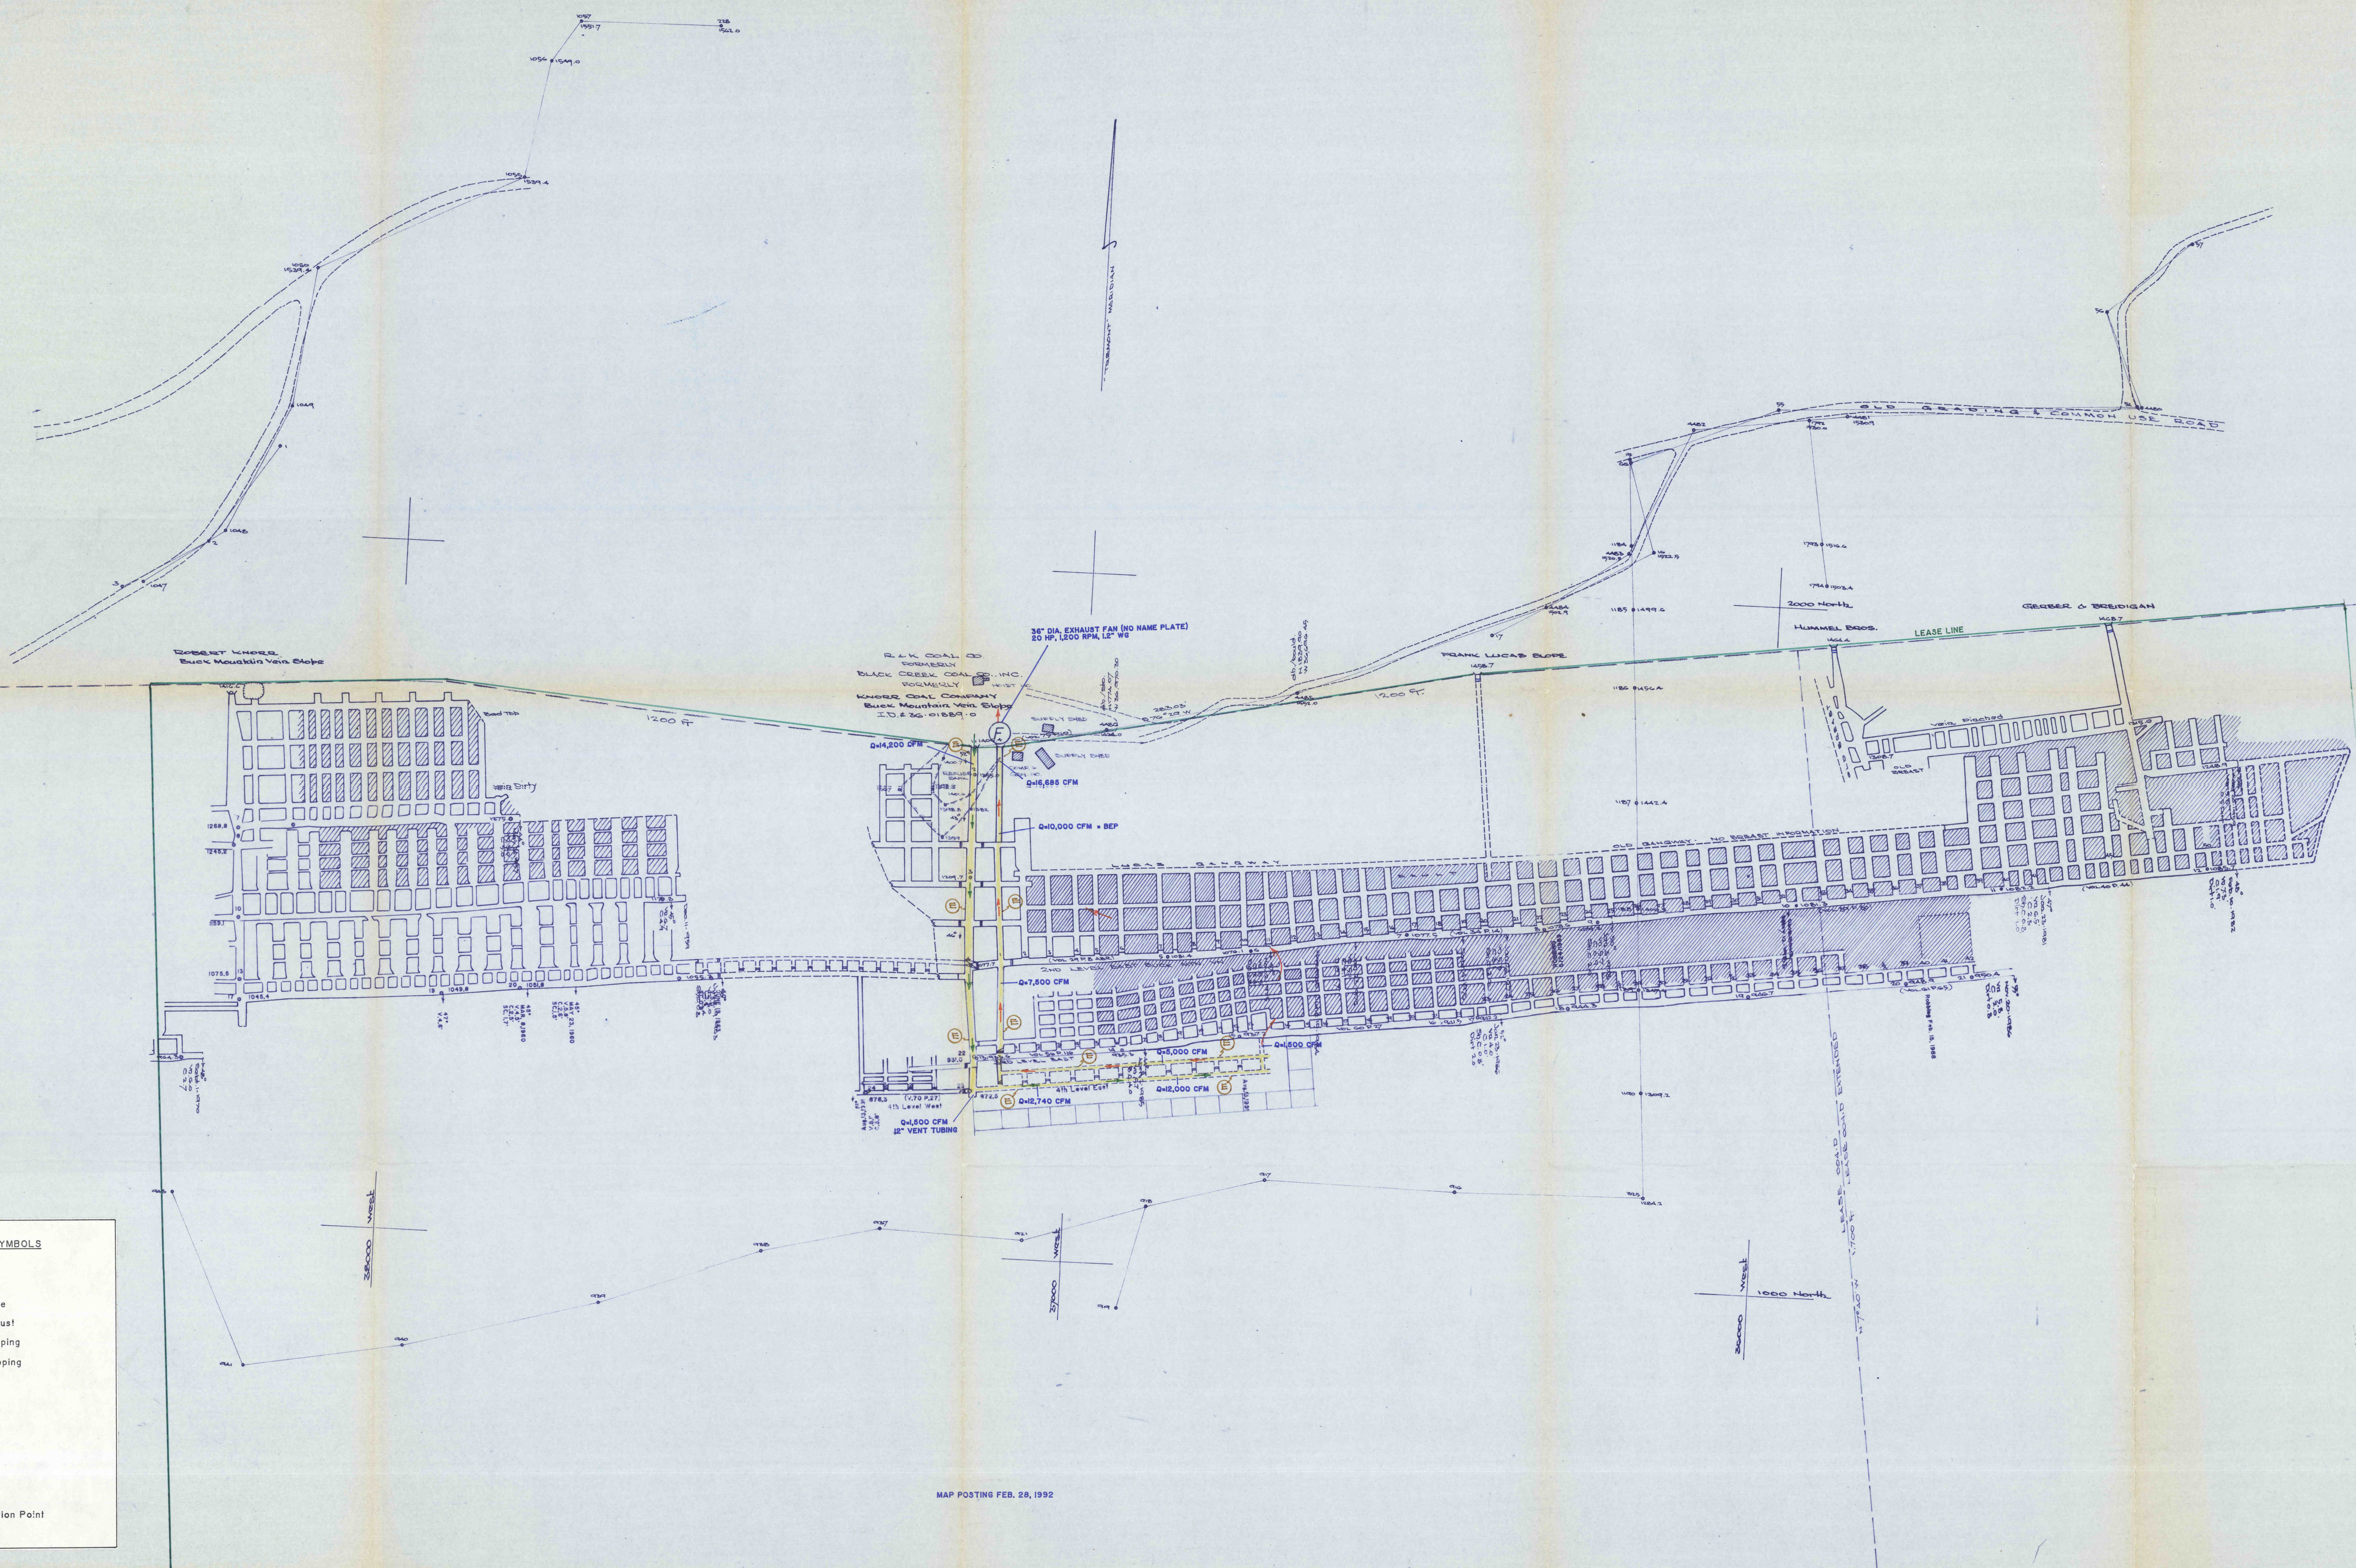

MINE MAP
of the
R & K COAL COMPANY MINE WORKINGS
situate
Hegins Township, Schuylkill County

Scale 1 inch = 100 feet

Arthur B. Reed