


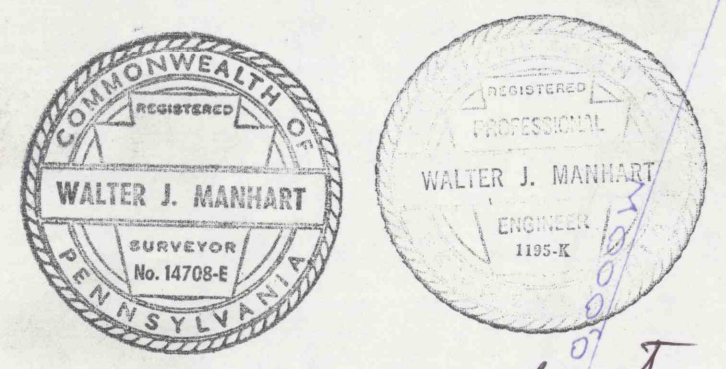

Walter J. Manhart

LEASE
6500 FEET EAST FROM HIGHWAY
500 FEET WIDE ALONG THE VEIN
R. S. & M. COAL CO. DRIFT-ROCKHVEN
CITY OF PITTSVILLE, SCH. CO. PA.
WALTER J. MANHART PENO. 1195K
SURVEYOR NO. 14708
SCALE 1"=100' DEC-11-1987
POSTED DEC 21, 1988
POSTED JAN 10, 1990
POSTED JAN 12, 1991
POSTED JAN 10, 1992

- LEGEND
- X - OVERCAST
 - - - DIRECTION OF AIR
 - STOPPING
 - PERMANENT STOPPING
 - AIR DRAIN CAN
 - AIR BATTLE
 - BLEEDER SYSTEM (EVALUATION POINT)
 - EXHAUSTING
 - ACTIVE WORKINGS KNOWN IN YELLOW
 - /// ROBBING
 - RETURN AIR
 - ONE YEAR PROJECTIONS
 - ROCK TUNNEL CENTERLINE
 - COAL DEVELOPMENT

SECTION THROUGH AIRHOLE
R. S. & M. COAL CO.
SCALE 1"=100' LOOKING WEST

SECTION THROUGH ROCK TUNNEL
SCALE 1"=50' LOOKING WEST

SCALE 1"=100'

DATUM 500
LOOKING WEST

PROPERTY LINE