


READING ANTHRACITE CO.

GARRETT GROUP, L.P.

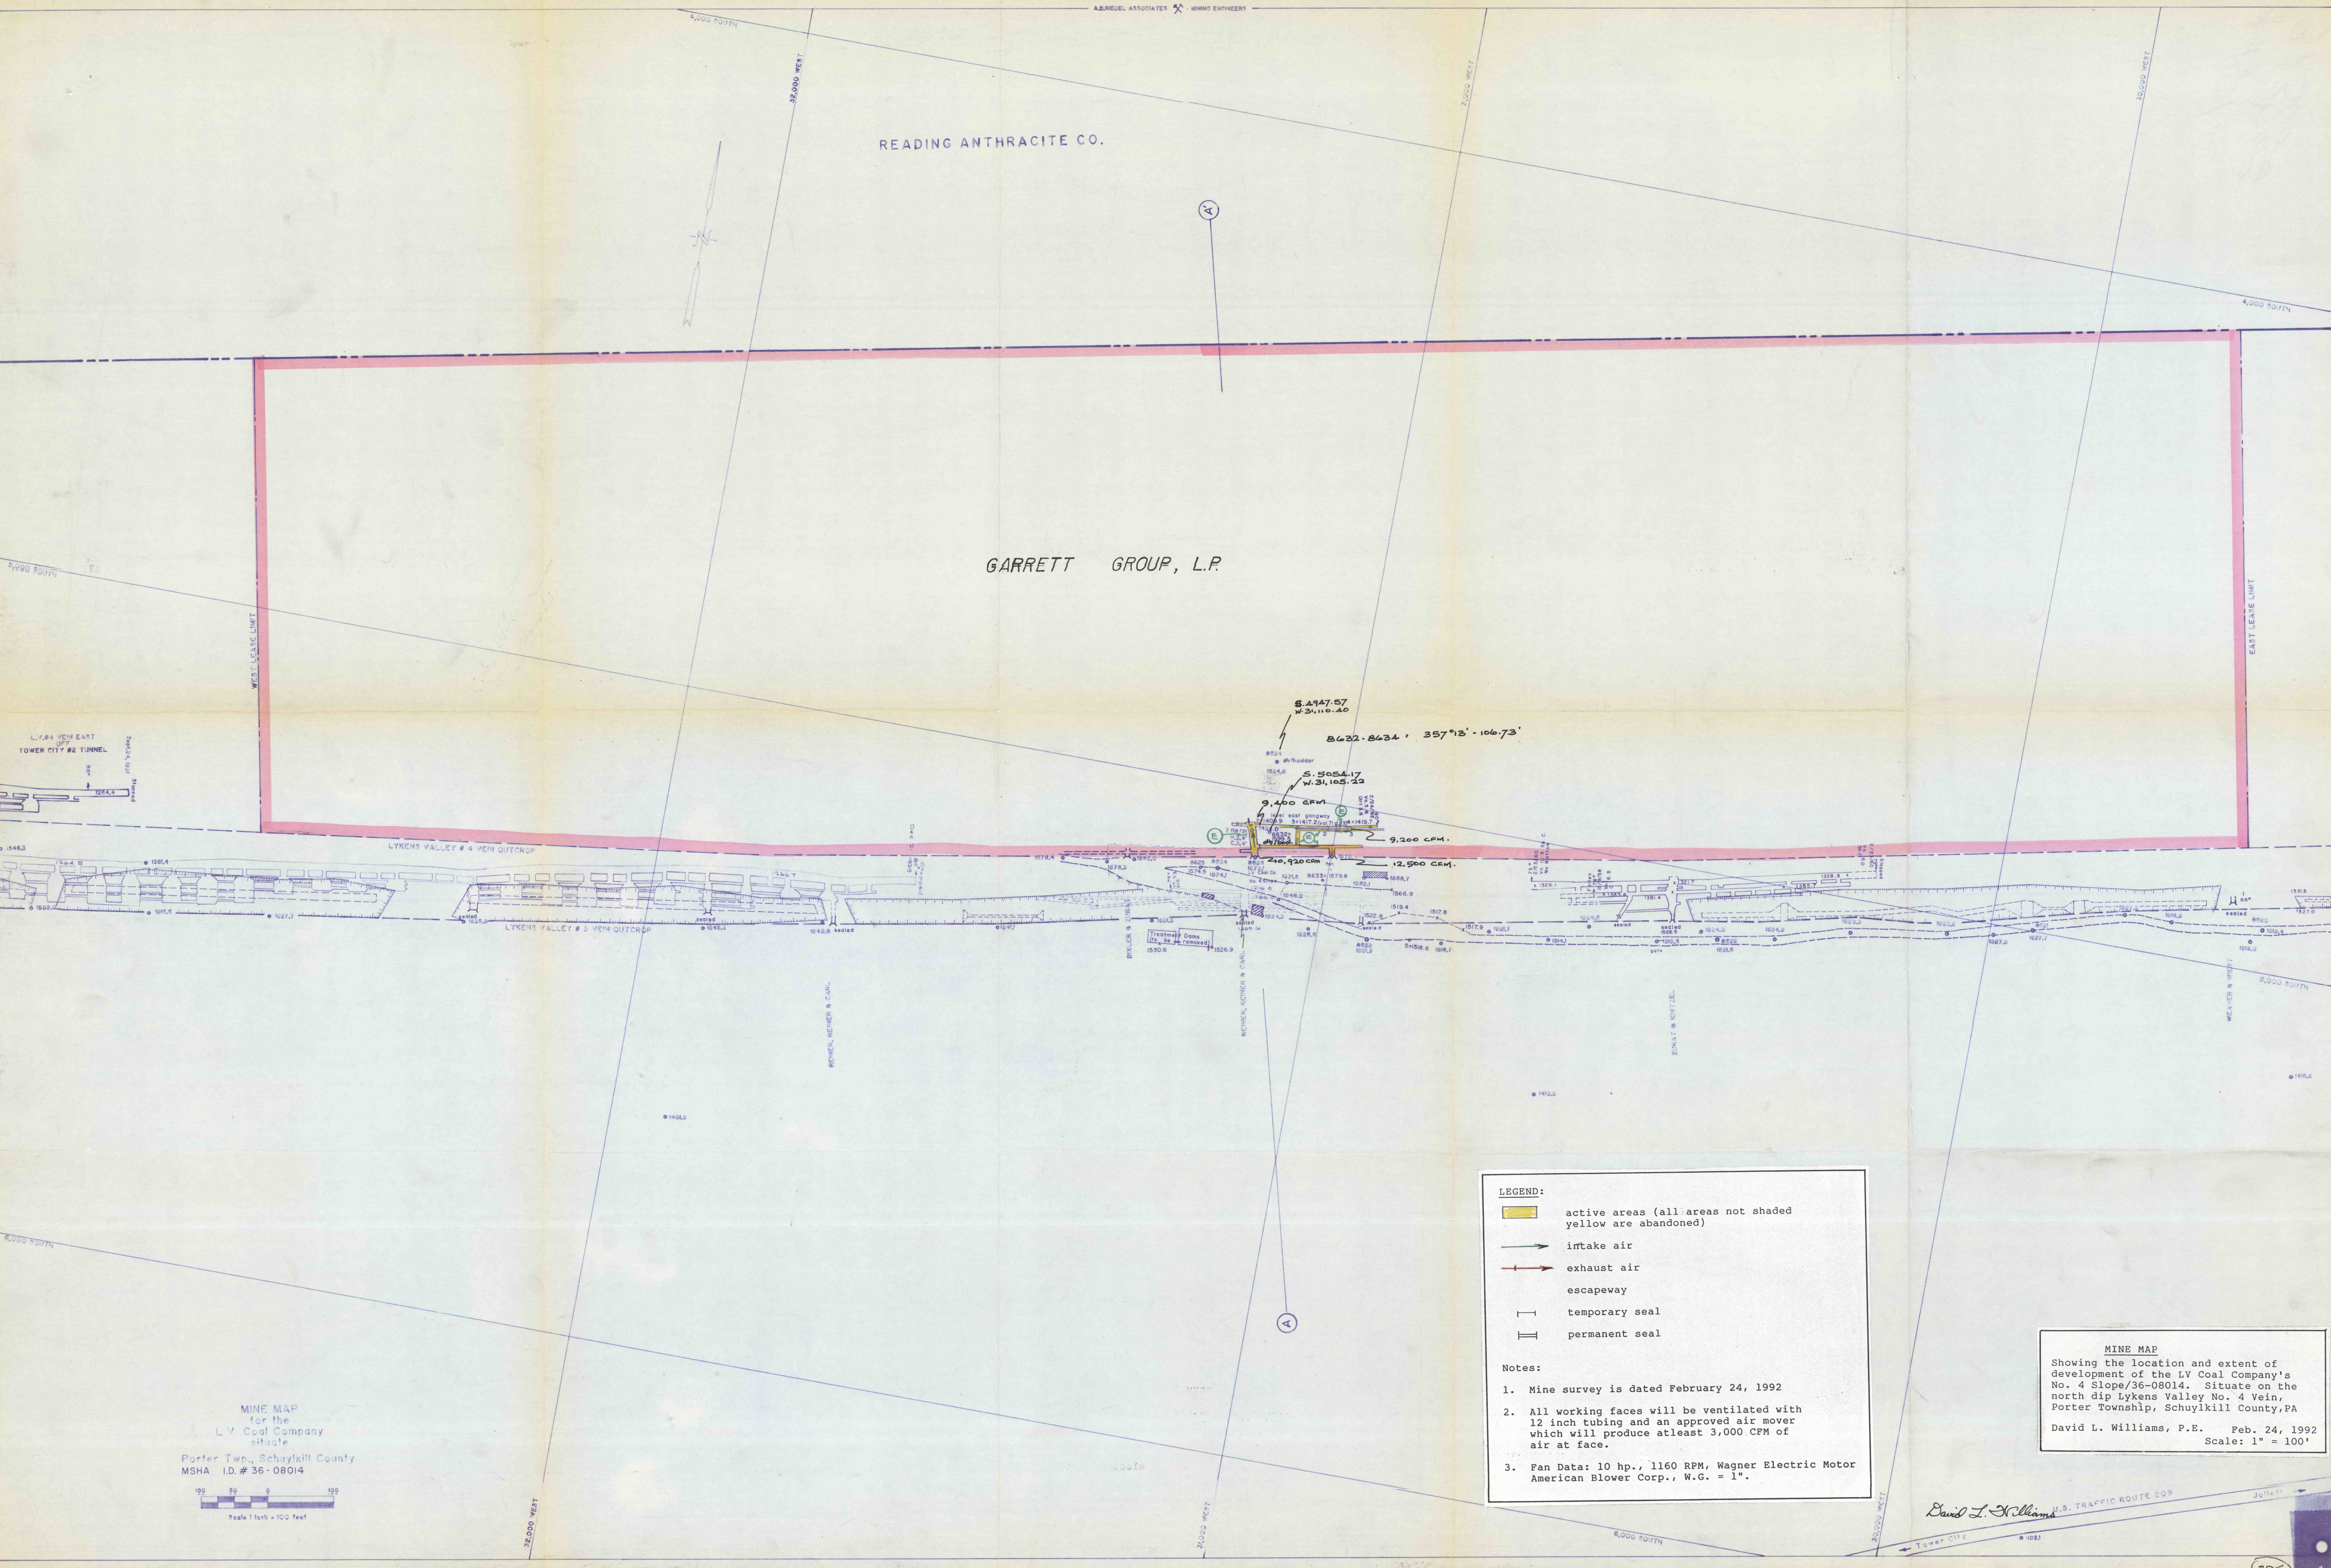

LYKENS VALLEY #4 VEIN EAST
TOWER CITY #2 TUNNEL

LYKENS VALLEY #4 VEIN OUTCROP

LYKENS VALLEY #5 VEIN OUTCROP

REVENUE, RENTERS & C.A.L.

REVENUE, RENTERS & C.A.L.

ZONALY & KENTZEL

WEN VALLEY & WILSON

LEGEND:

- active areas (all areas not shaded yellow are abandoned)
- intake air
- exhaust air
- escapeway
- temporary seal
- permanent seal

Notes:

1. Mine survey is dated February 24, 1992
2. All working faces will be ventilated with 12 inch tubing and an approved air mover which will produce atleast 3,000 CFM of air at face.
3. Fan Data: 10 hp., 1160 RPM, Wagner Electric Motor American Blower Corp., W.G. = 1".

MINE MAP
for the
L.V. Coal Company
situate
Porter Twp., Schuylkill County
MSHA I.D.# 36-08014

Scale 1 inch = 100 feet

MINE MAP
Showing the location and extent of
development of the LV Coal Company's
No. 4 Slope/36-08014. Situate on the
north dip Lykens Valley No. 4 Vein,
Porter Township, Schuylkill County, PA
David L. Williams, P.E. Feb. 24, 1992
Scale: 1" = 100'

David L. Williams U.S. TRAFFIC ROUTE 209