


J A C O B C H R I S T T R A C T

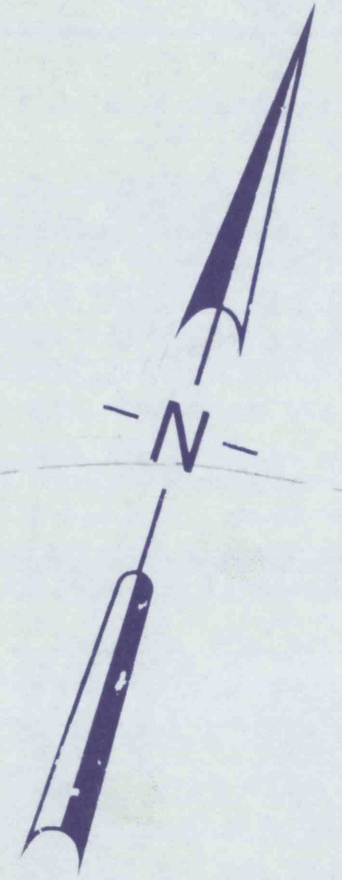

H E N R Y W E A V E R



K I L L I A N M

R A C T

H E N R Y S H A F F E R

MINE MAP

Showing the location and extent of development of the Mountain View Coal Company slope mine. Situate on the south dip Lykens Valley #6 vein, Barry Township, Schuylkill County.

A.B. Riedel, P.E. October 14, 1991
Scale 1"=100'

- VENTILATION SYMBOLS**
- ⊙ = Main Fan
 - ⊙ = Auxiliary Fan
 - = Air Flow - Intake
 - = Air Flow - Exhaust
 - ⊥ = Permanent Stopping
 - ⊥ = Temporary Stopping
 - ⊥ = Air Bridge
 - R = Regulator
 - ⊥ = Man Door
 - V = Velocity, fpm
 - Q = Quantity, cfm
 - WG = Water Gauge
 - ⊙ = Escapeway
 - BEP = Bleeder Evaluation Point

April B. Riedel